



- (DEMO)

[illegible]

PANEL		"EP-F"		VOLTAGE		120/208V/3PH/4W	
MOUNTING		SURFACE		MAIN BUS		FED FROM PANEL EP-E-26,28,30	
LOCATION		BASEMENT - MECHANICAL RM.		REMARKS			
NOTES:	DESCRIPTION	VA	BKR	A	B	C	
	CIRC PUMP #1	1334	20	1	•	2	15
	CIRC PUMP #2	1334	20	3	•	4	15
	LIGHTS, MECH RM., TUNNEL	249	15	5	•	6	15
	AIR COMP. FOR PLV MOUNT (HOSE TOWER)	1940	20	7	•	8	15
	BOILER #2	960	15	9	•	10	15
	BOILER #1	960	15	11	•	12	15
	LOOP PUMP	1730	15	13	•	14	15
				15	•	16	15
				17	•	18	20
	?	?	15	19	•	20	20
	?	?	15	21	•	22	15
	?	?	15	23	•	24	15
	LOAD	7072					5125

PANEL		"NP-B"		VOLTAGE		120/208V-3PH-4W			
MOUNTING		SURFACE		MAIN BUS		225A MAIN BREAKER 100A-3P			
LOCATION		BASEMENT ELECTRICAL RM.		REMARKS		C/W LOCKABLE DOOR			
NOTES:	DESCRIPTION	VA	BKR	A B C	BKR	VA	DESCRIPTION	NOTES:	
	PLUG: PARKING	650	15	1	2	20	SPARE	WAS I/C (EAST DOWN)	
	PLUG: PARKING	650	15	3	4			SEE REMO	
	PLUG: PARKING	650	15	5	6	20		SPARE	WAS I/C (WEST DOWN)
	PLUG: PARKING	650	15	7	8		SEE REMO		
	PLUG: PARKING	650	15	9	10	30	SPARE		WAS RTU (EAST)
	PLUG: PARKING	650	15	11	12			SEE REMO	
	PLUG: PARKING	650	15	13	14			SPARE	WAS RTU (NORTH)
	PLUG: PARKING	650	15	15	16	40	SEE REMO		
	SPRAY WASHER (HOSE TOWER)	2870	30	17	18		GYM TREADMILL		
				19	20			GYM TREADMILL	
	CONTROL GCT CAR PLUGS	600	15	21	22	20			
	SPACE			23	24	20			
	LOAD	8670					0	LOAD	

1	ISSUED FOR ADDENDUM 3	DTA	10.15 2025
0	ISSUED FOR CONSTRUCTION	DTA	09.11 2025
A	ISSUED FOR REVIEW	DTA	08.15 2025
No.	REVISION/DESCRIPTION	BY	DATE

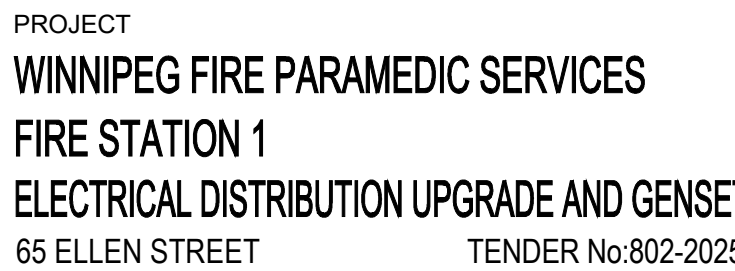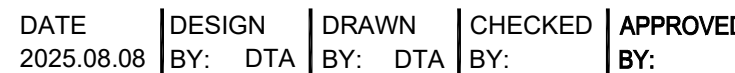

SCALE AS SHOWN	PROJECT No: 2024-070	SHEET No: E6-R1
-------------------	-------------------------	---------------------------