
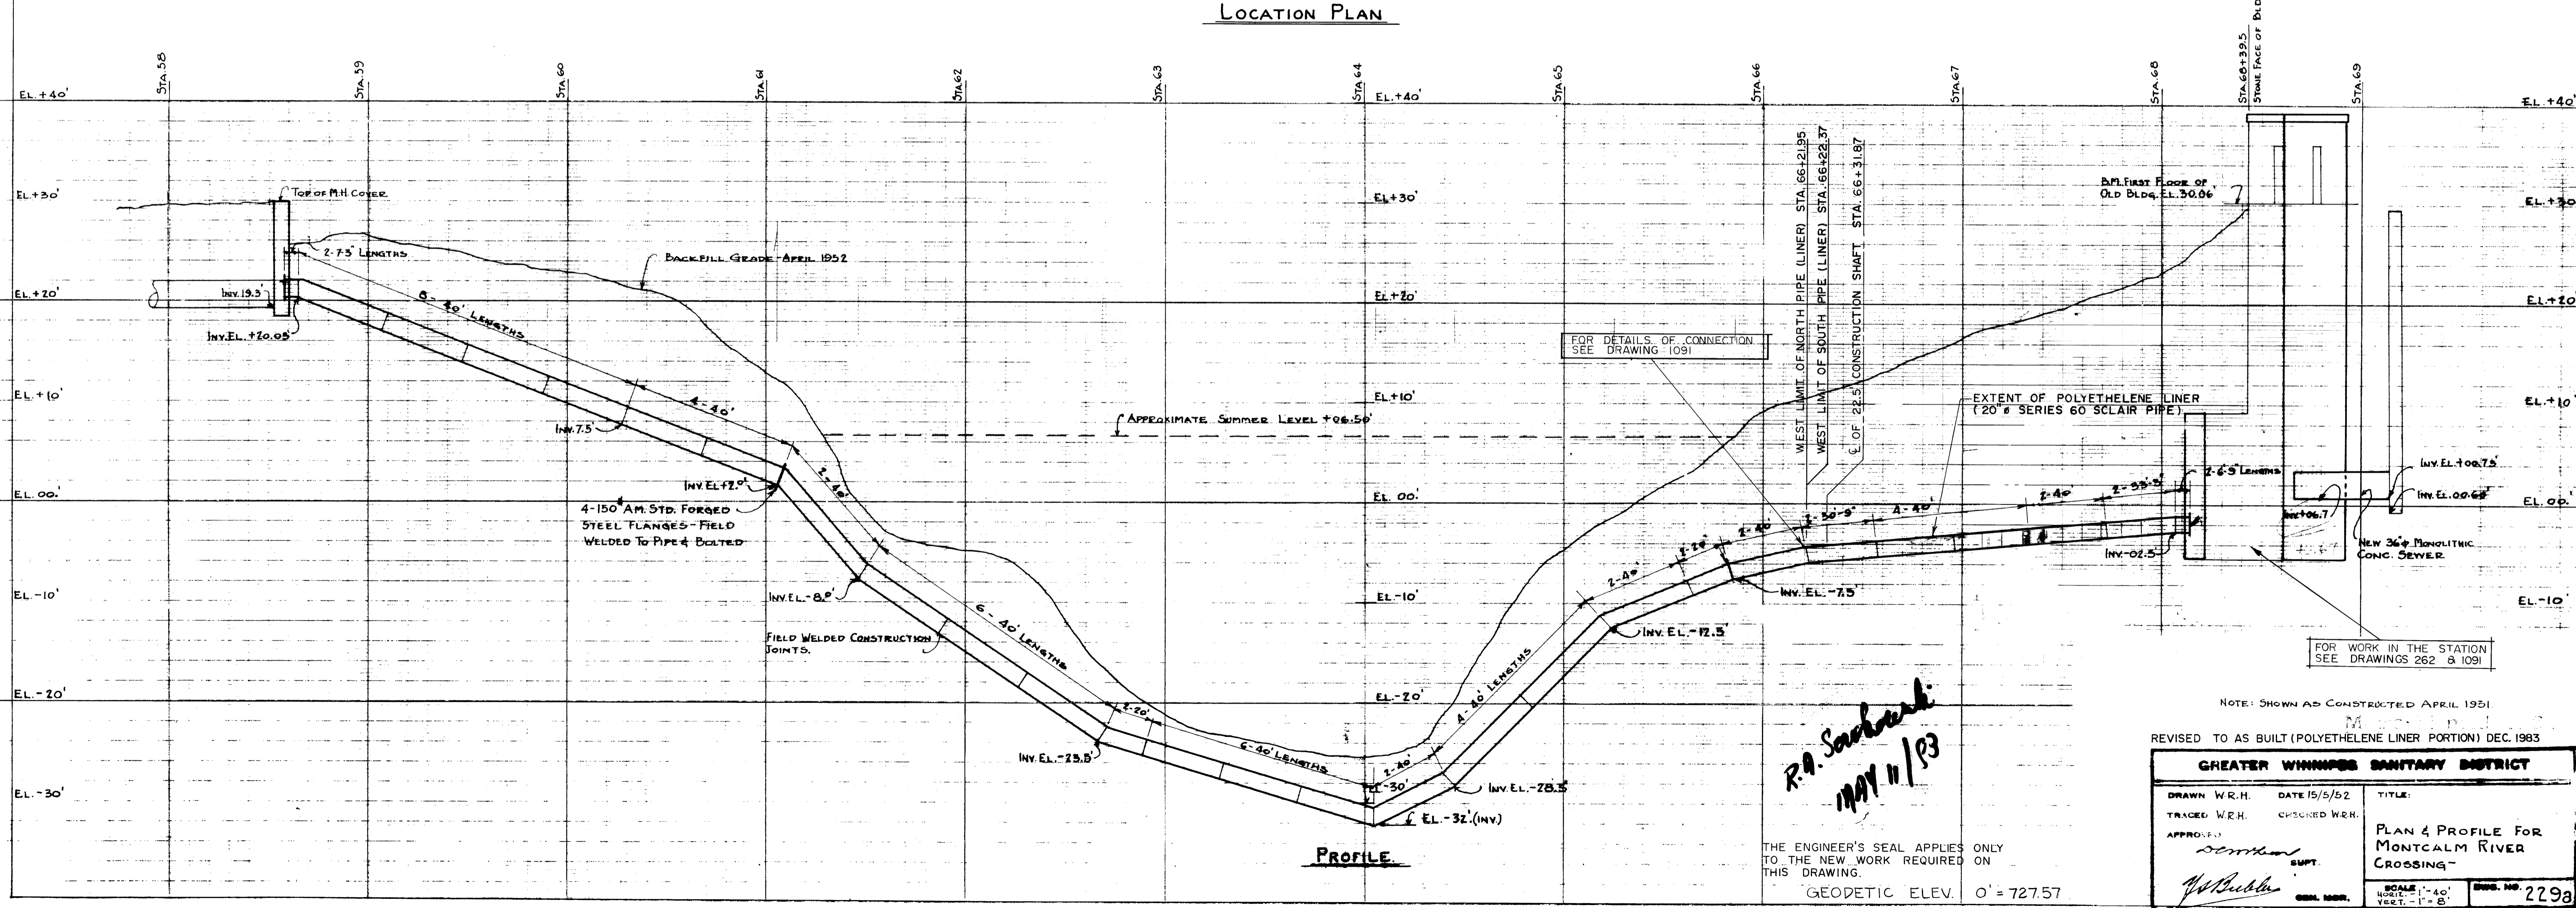


file # FM10014

REF. or DRAWING NO. 229a
DETAILS

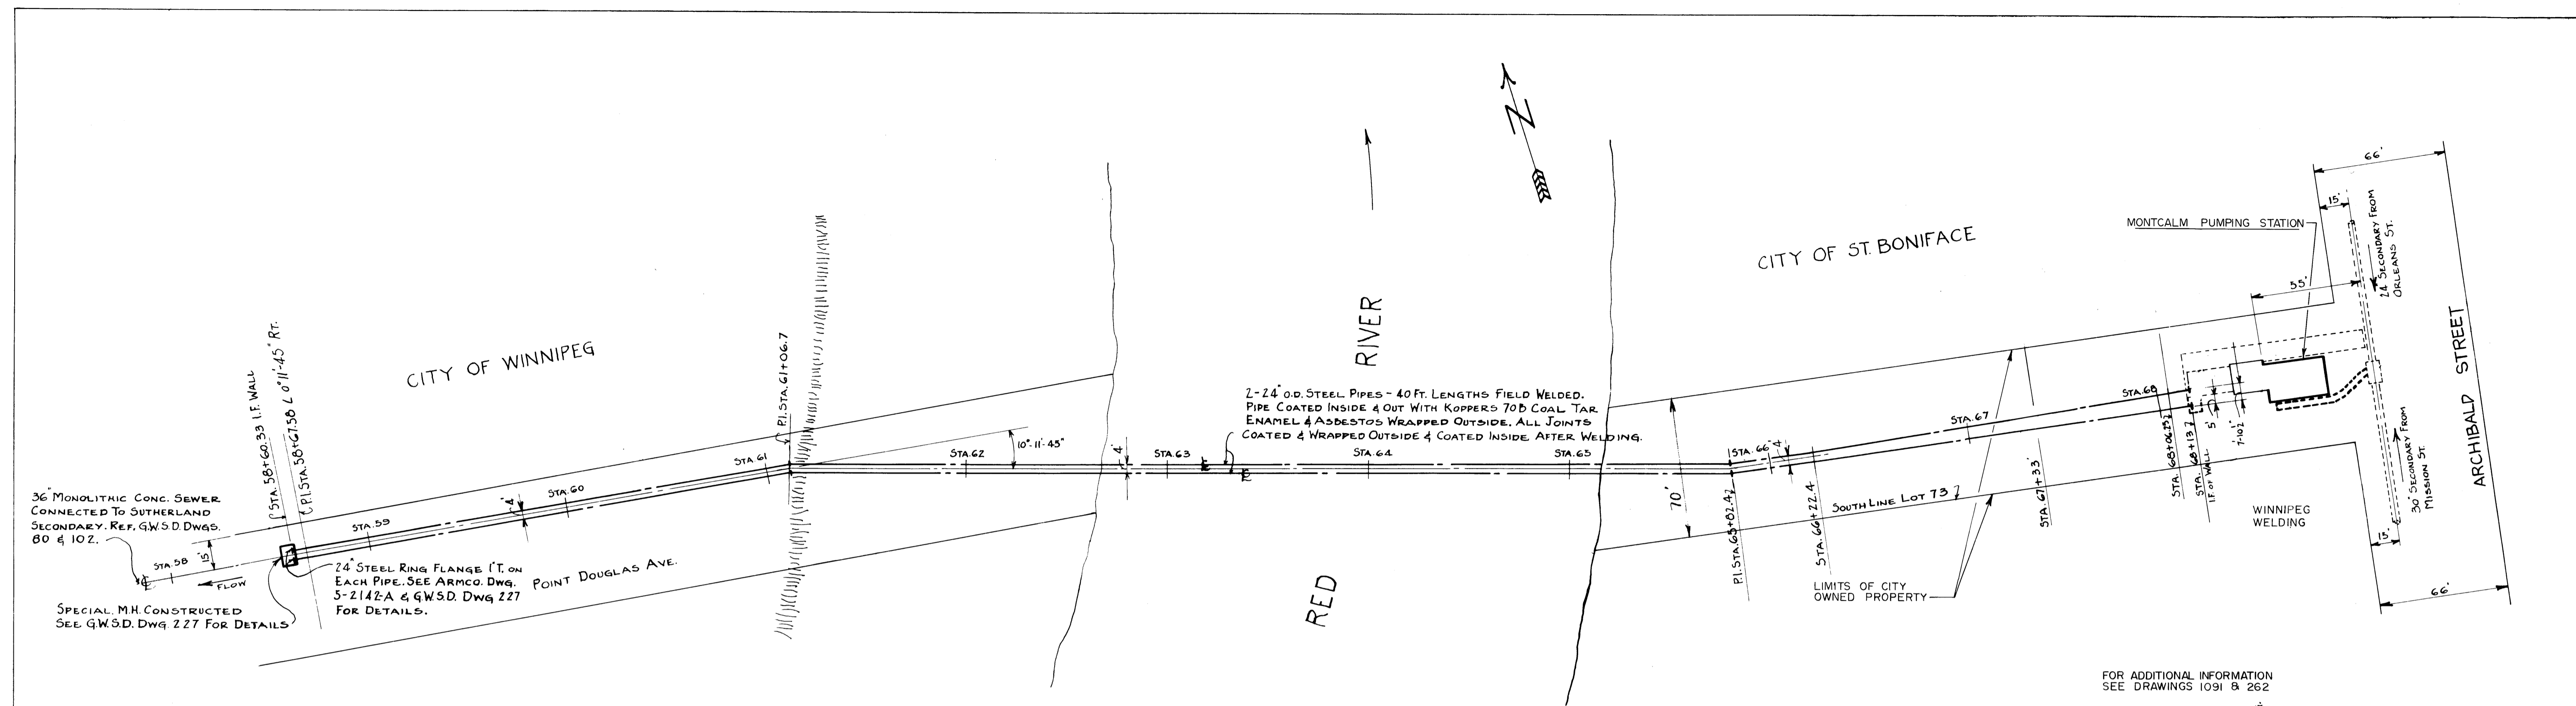

GREATER WINNIPEG SANITARY DISTRICT		
DRAWN W.R.H.	DATE 15/5/82	TITLE:
TRACED W.R.H.	CHECKED W.R.H.	PLAN & PROFILE FOR MONTCALM RIVER CROSSING
APPROVED	SUPT.	SCALE: HORIZ. 1" = 40'
		VERT. 1" = 8'
		DWG. NO. 229a