

SCALE: 1:11


PROVIDE OPERATING NUT PER DIMENSIONS OUTLINED IN SPECIFICATION E17.5(a)

~~ADAPTOR MOUNTING POSITION TO BE CONFIRMED.~~

B.K. B. Sth

MAR. 4, 2004

B.K. B. Sth
MAR. 4, 2004

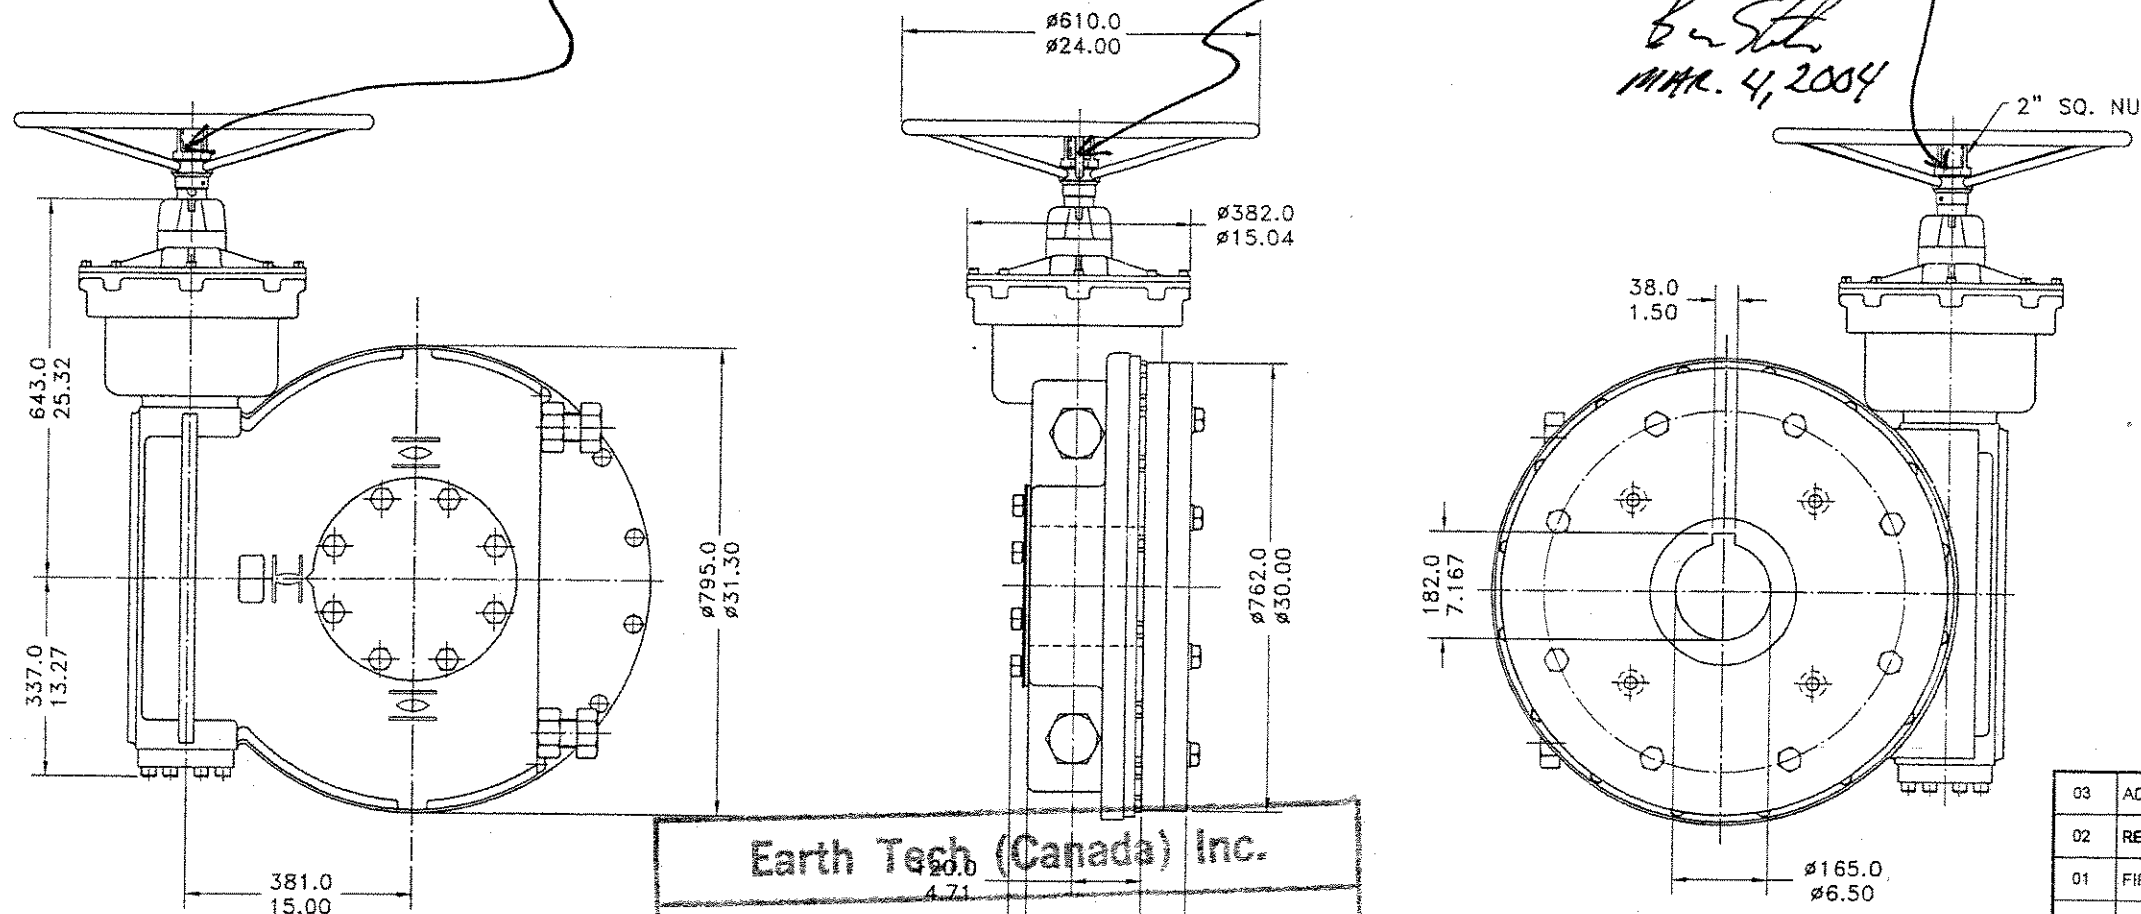

Earth Tech (Canada) Inc.

Reviewed for general conformance with design intent. Responsibility for design in the shop drawings rests with the Contractor.

Responsibility for verification and correlation of field dimensions, fabrication techniques of construction, installation and coordination of all parts of the work rests with the Contractor.

REVIEWED _____

REVIEWED AS MODIFIED

REVISE AND RE-SUBMIT _____

NOT REVIEWED _____

Project No. **63672 - DEACON UV DISINFECTION**

Date: **MAR. 4, 2004** By: **B.K. B. Sth**

City of Winnipeg Tender 493-2003
Deacon Ultraviolet (UV) Light Disinfection Project
Mueller Flow Control P/O 17592WT
Rotork Reference # 1759

Notes:

- 1) All dimensions are in mm/inches.
- 2) Gearbox weight: 1060lbs/481kg.
- 3) For project specific certified data, refer to certification sheet

REV	DESCRIPTION	DATE	APVD
03	ADDED 2" SQ. NUT	02/09/04	—
02	REMOVED VALVE, ADDED ADAPTION PLATE	01/29/04	—
01	FIRST ISSUE	01/12/04	—

REVISION HISTORY

rotork

Rotork Controls (Canada) Ltd.
2850 Argenta Road, Unit #4
Mississauga, Ontario
Tel (905) 363-0313

Rotork Controls (Canada) Ltd.
#9, 820-28th St
Calgary, Alberta
Tel (403) 569-9455

TITLE: **Exeeco Model IW11R1440 Gearbox with 24" Handwheel onto Adaptor Flange for 54"-150lb Rodney Hunt AWWA Butterfly Valve**

CERTIFIED

THIRD ANGLE PROJECTION

DRAWN: **Andrea Swan** DATE: **01/12/04**

CHECKED: **John Favaro** DATE: **01/12/04**


DWG. NO.:

B-922540-03

SCALE: 1:11

PROVIDE OPERATING NUT PER
DIMENSIONS OUTLINED IN
SPECIFICATION E17.5(a)

Ben Stoltz
MAR. 4, 2004

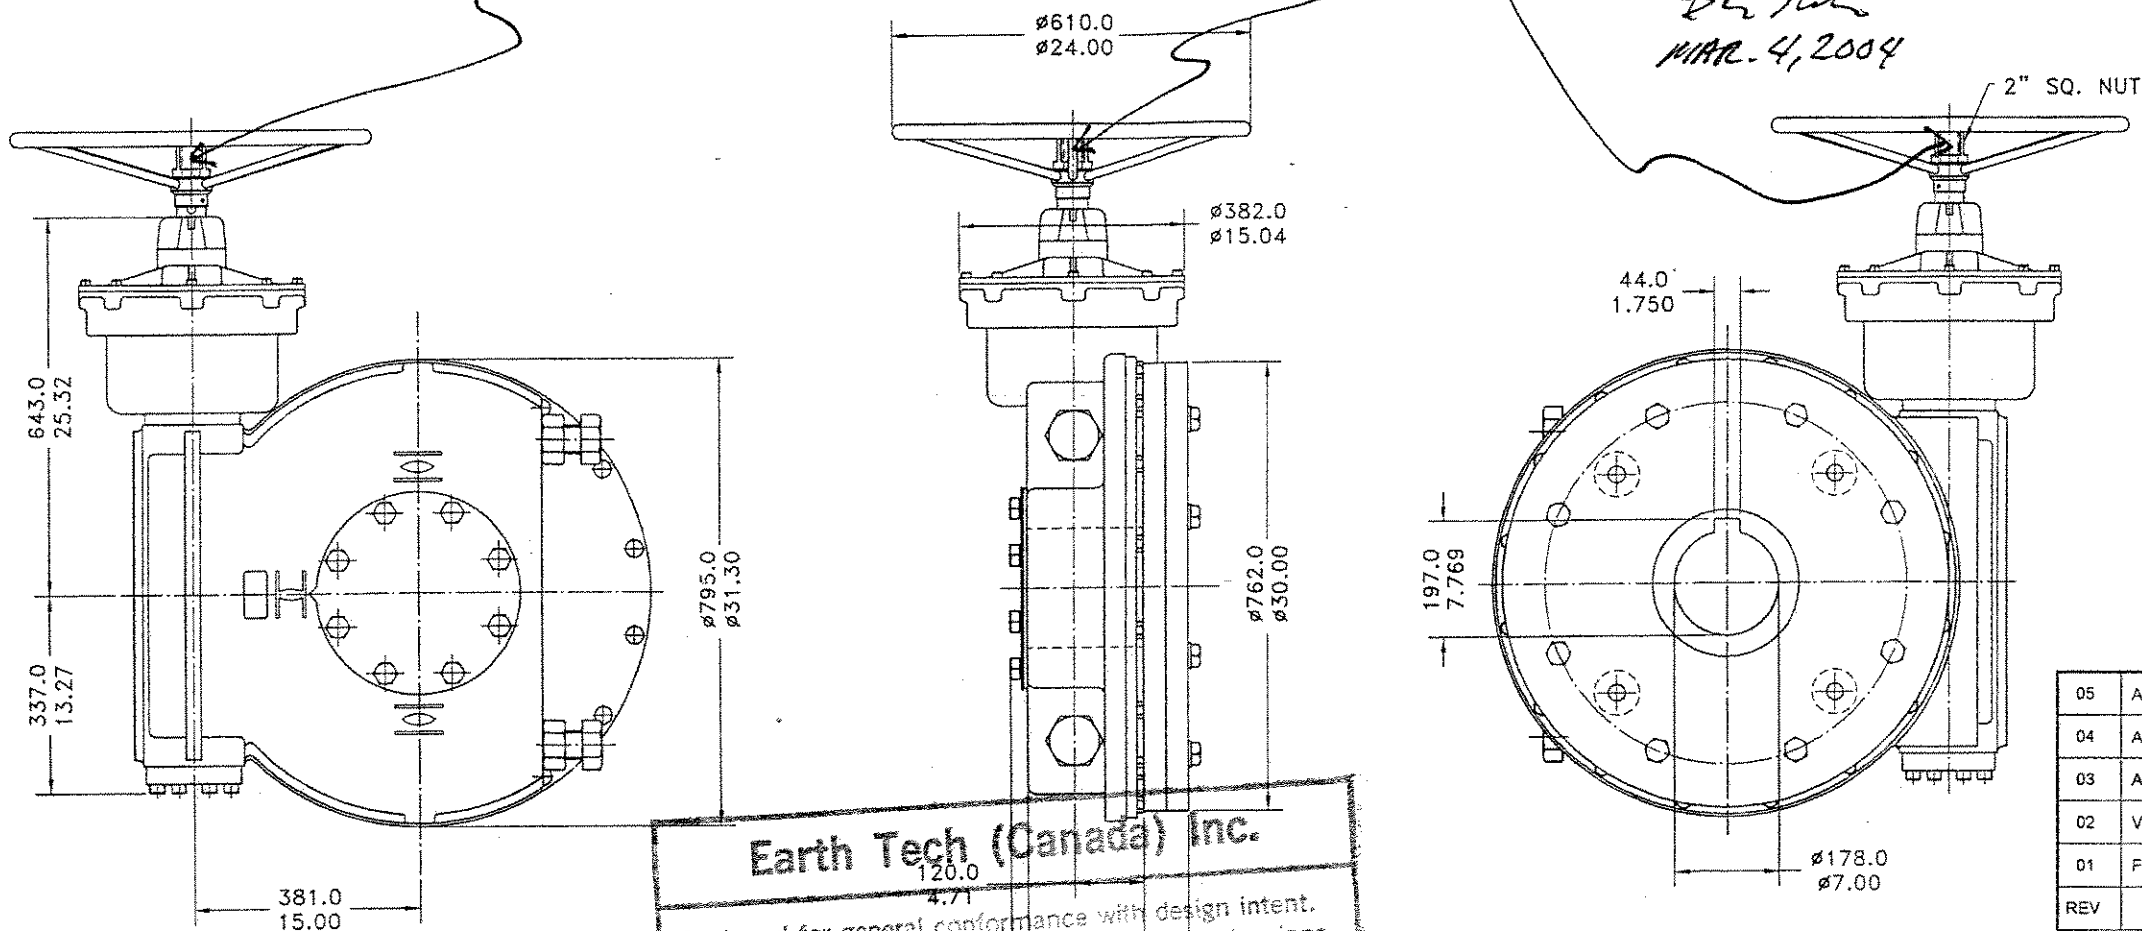

Earth Tech (Canada) Inc.

Reviewed for general conformance with design intent. Responsibility for detailed design in the shop drawings rests with MAX SYSTEM ENTRY

Reviewed by: *[Signature]* 76.0
3.00

Responsibility for verification and correlation of field dimensions, fabrication process, techniques of construction, installation and commissioning of all parts of the work rests with the Contractor.

Reviewed: _____

Reviewed as Modified: _____ ✓

Revise and Re-Submit: _____

Not Reviewed: _____

Project No. **63672- DEACON UV DISINFECTION**

Date: **MAR. 4, 2004** By: *[Signature]*

- Notes:
- 1) All dimensions are in mm/inches.
 - 2) Gearbox weight: 1060lbs/481kg.
 - 3) For project specific certified data, refer to certification sheet.

REV	DESCRIPTION	DATE	APVD
05	ADDED 2" SQ. NUT	02/09/04	—
04	ADDED ADAPTION PLATE	01/29/04	—
03	ADDED CUSTOMER NOTES	01/19/04	—
02	VALVE REMOVED	01/16/04	—
01	FIRST ISSUE	01/12/04	—

REVISION HISTORY

rotork

Rotork Controls (Canada) Ltd.
2850 Argenta Road, Unit #4
Mississauga, Ontario
Tel (905) 363-0313

Rotork Controls (Canada) Ltd.
#9, 820-28th St.
Calgary, Alberta
Tel (403) 569-9455

TITLE: **Exeeco Model IW11R2160 Gearbox with 24" Handwheel onto Adaptor Flange for 66"-150lb Rodney Hunt AWWA Butterfly Valve**

CERTIFIED THIRD ANGLE PROJECTION

DRAWN: **Andrea Swan** DATE: **01/12/04**

CHECKED: **John Favaro** DATE: **01/12/04**

DWG. NO.: **B-922536-05**

City of Winnipeg Tender 493-2003
Deacon Ultraviolet (UV) Light Disinfection Project
Mueller Flow Control P/O 1759WT
Rotork Reference # 1759