


D SIZE 22" x 34" (559mm x 864mm)

UMA FILE NAME: OVERALL_RX.DWG 2004-04-23 1:27pm WJD

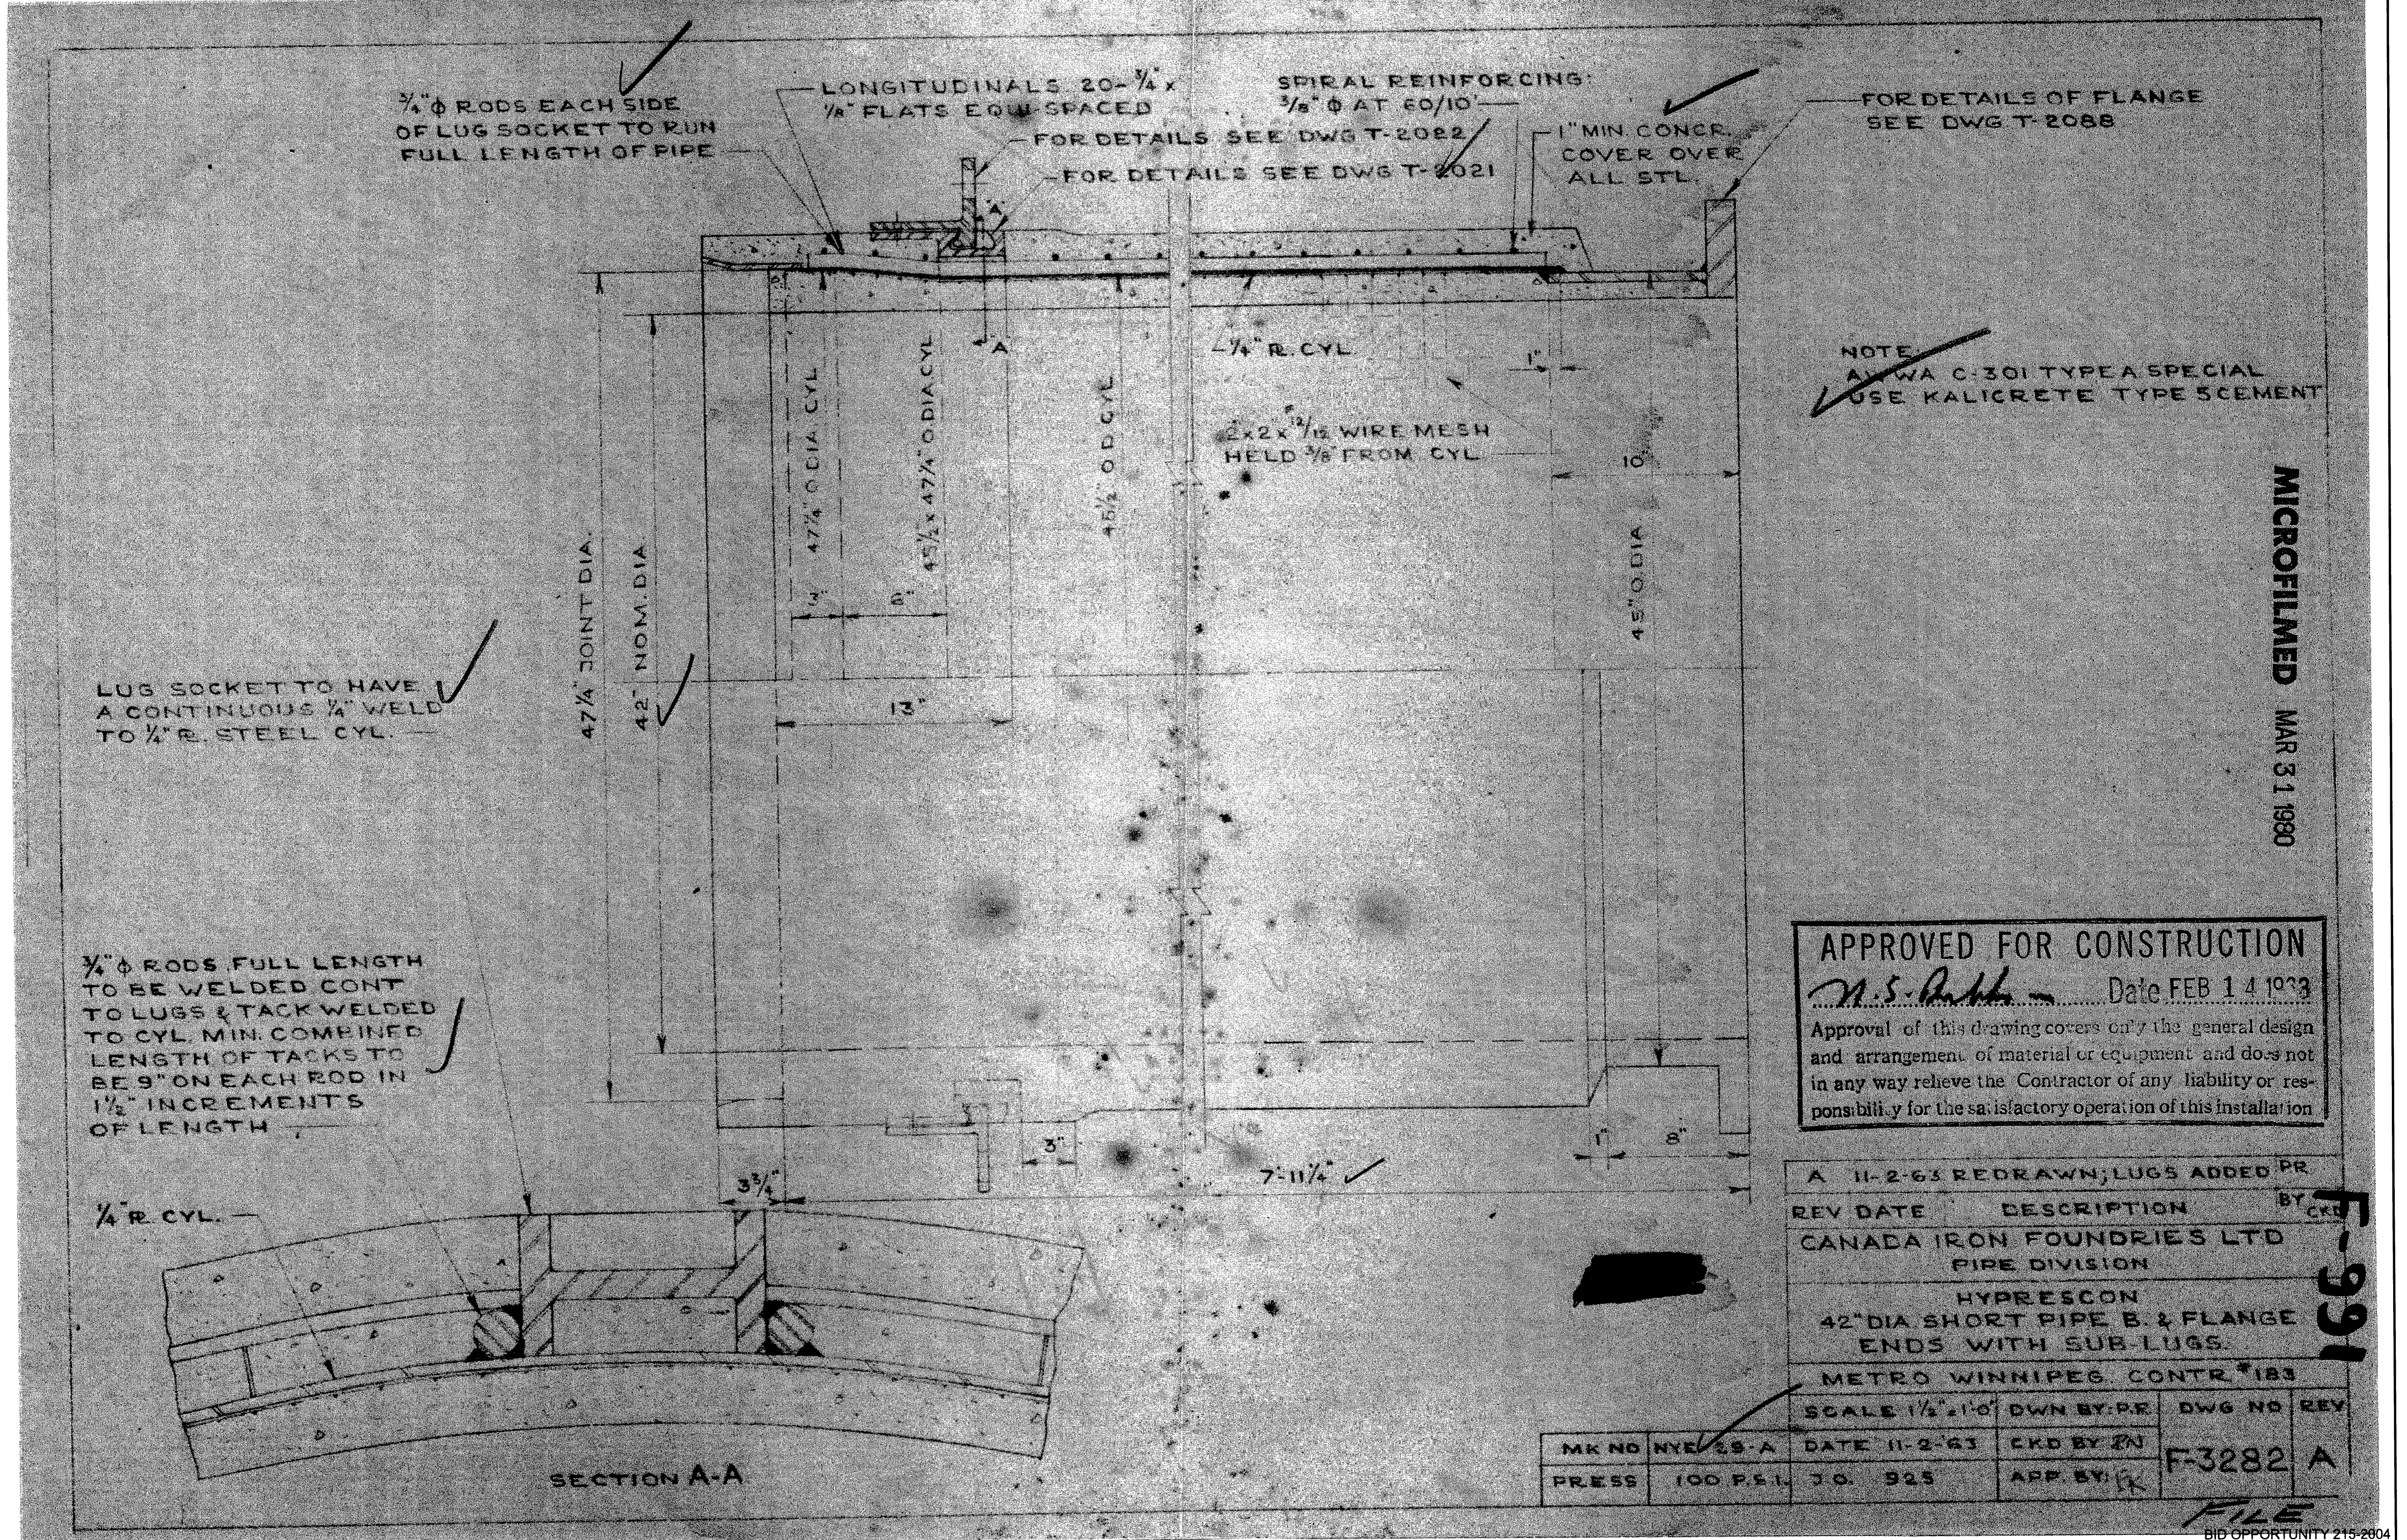

MICROFILMED MAR 31 1980

APPROVED FOR CONSTRUCTION
M.S. Poth Date FEB 14 1993
 Approval of this drawing covers only the general design and arrangement of material or equipment and does not in any way relieve the Contractor of any liability or responsibility for the satisfactory operation of this installation

REV	DATE	DESCRIPTION	BY
A	11-2-63	REDRAWN; LUGS ADDED	PR
CANADA IRON FOUNDRIES LTD PIPE DIVISION			
HYPRESCON 42" DIA SHORT PIPE B. & FLANGE ENDS WITH SUB-LUGS.			
METRO WINNIPEG CONTR #183			
SCALE	1/2" = 1'-0"	DWN BY: RE	DWG NO
REV			
MR NO	NYE 25-A	DATE 11-2-63	CKD BY: JN
PRESS	100 P.S.I.	JO. 925	APP BY: JK
			F-3282 A

LOCATION APPROVED
UNDERGROUND STRUCTURES

SUPR. U/G STRUCTURES COMMITTEE DATE

NOTE:
LOCATION OF UNDERGROUND STRUCTURES AS SHOWN ARE BASED ON THE BEST INFORMATION AVAILABLE. BUT NO GUARANTEE IS GIVEN THAT ALL EXISTING UTILITIES ARE SHOWN OR THAT THE GIVEN LOCATIONS ARE EXACT. CONFIRMATION OF EXISTENCE AND EXACT LOCATION OF ALL SERVICES MUST BE OBTAINED FROM THE INDIVIDUAL UTILITIES BEFORE PROCEEDING WITH CONSTRUCTION.

NO.	REVISIONS	YYMMDD	BY

uma
www.umagroup.com

2004 UMA ENGINEERING LTD. ALL RIGHTS RESERVED.

DESIGNED BY	MGM	CHECKED BY	
DRAWN BY	WJd	APPROVED BY	
HOR. SCALE	1:500	RELEASED FOR CONSTRUCTION	
VERT. SCALE	1:50		
DATE		DATE	

PROFESSIONAL'S SEAL

CONSULTANT DRAWING NO.
D265-182-00

THE CITY OF WINNIPEG

Winnipeg

BRANCH II AQUEDUCT INTERCONNECTOR - VALVE CHAMBER

HISTORICAL DRAWING (FOR INFORMATION ONLY)

SHEET OF

CITY DRAWING NUMBER

F-991

REV

BID OPPORTUNITY 215-2004