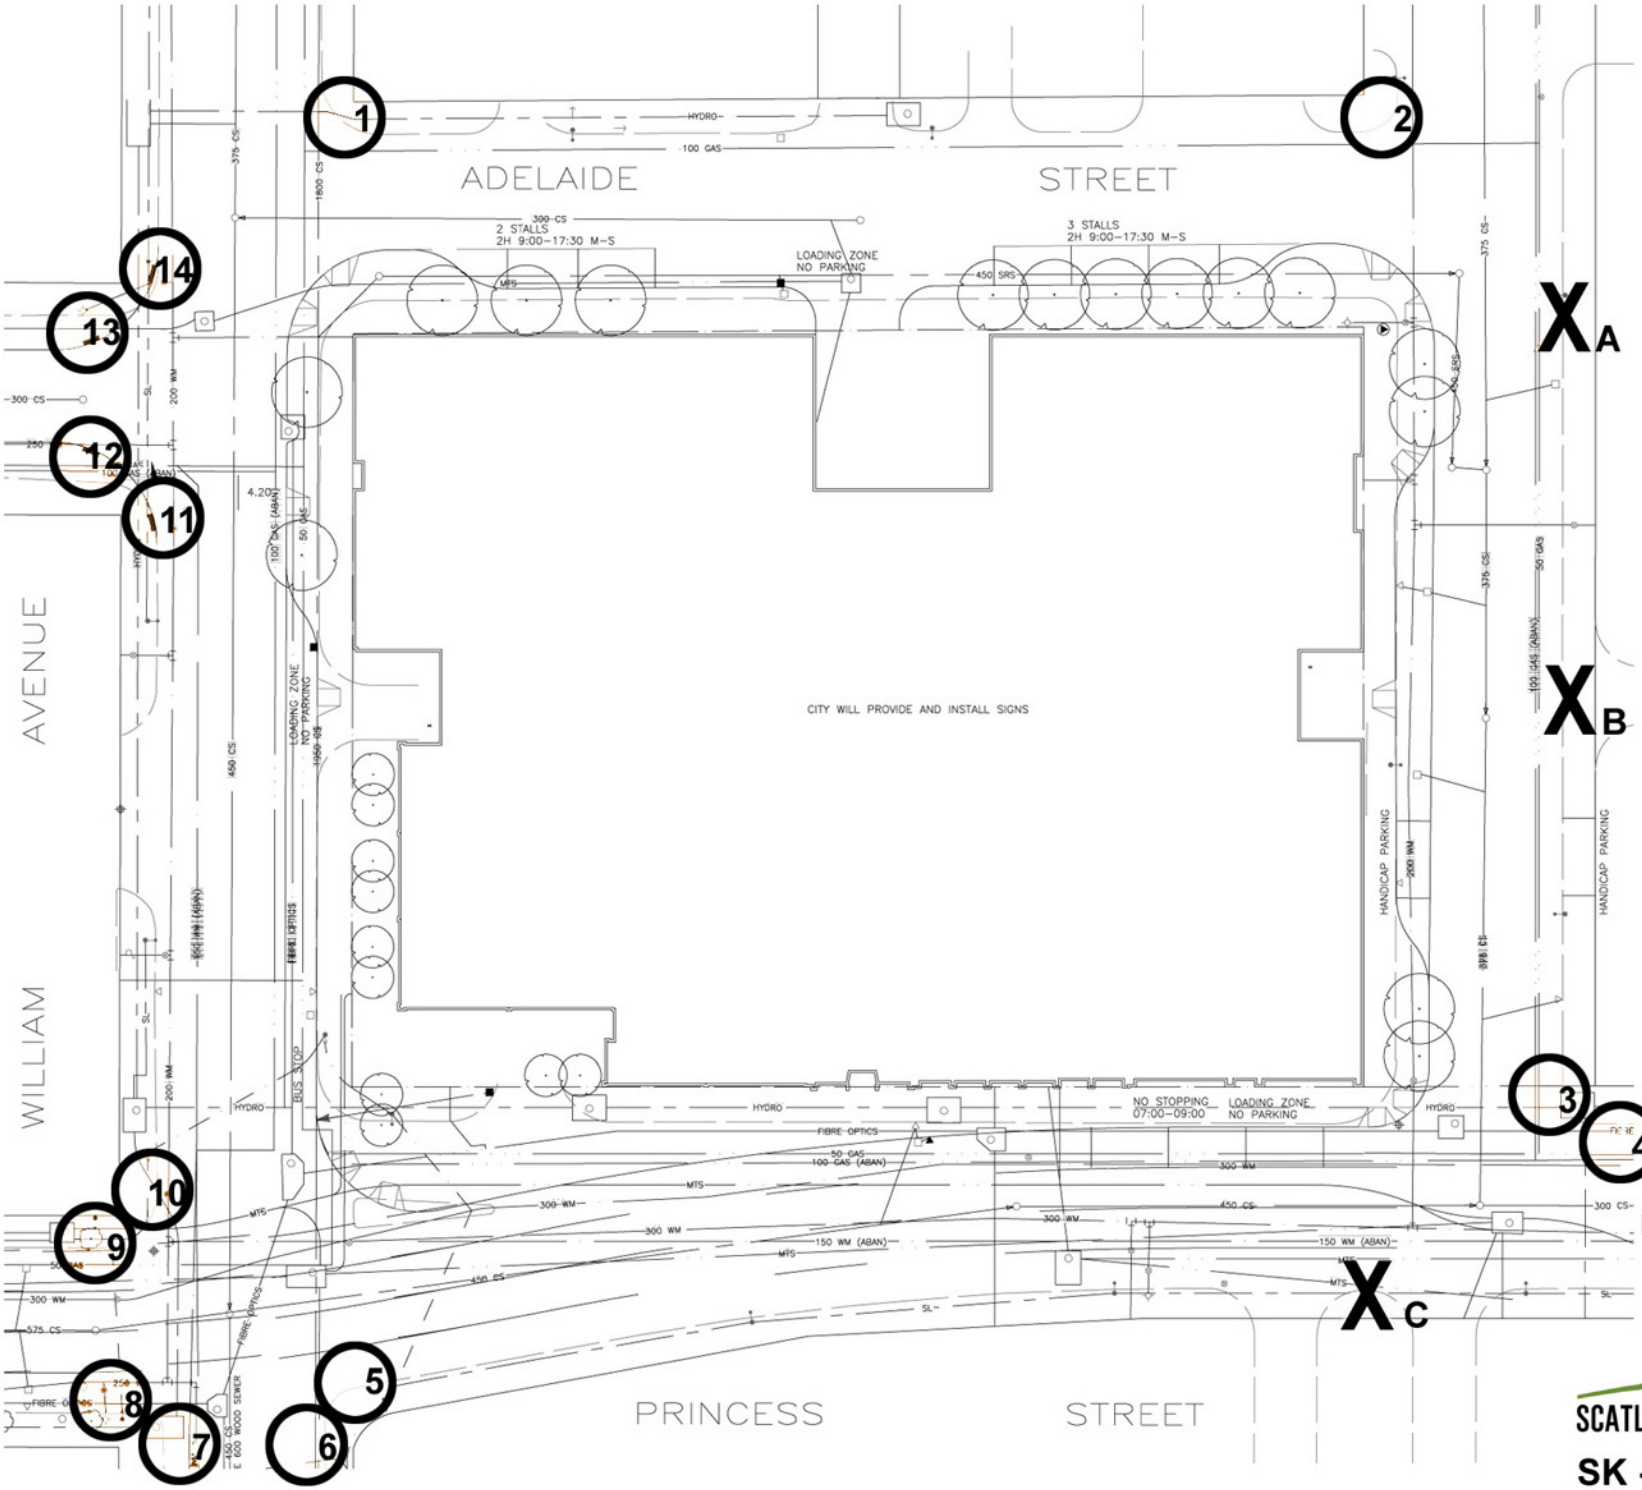

Legend

○ Pararamps - replaced/rebuilt

X New Pararamps

SCATLIFF + MILLER + MURRAY landscape architects

SK - 1 94-2004

Not to scale