SHEET: COW-A1 (03/2005)

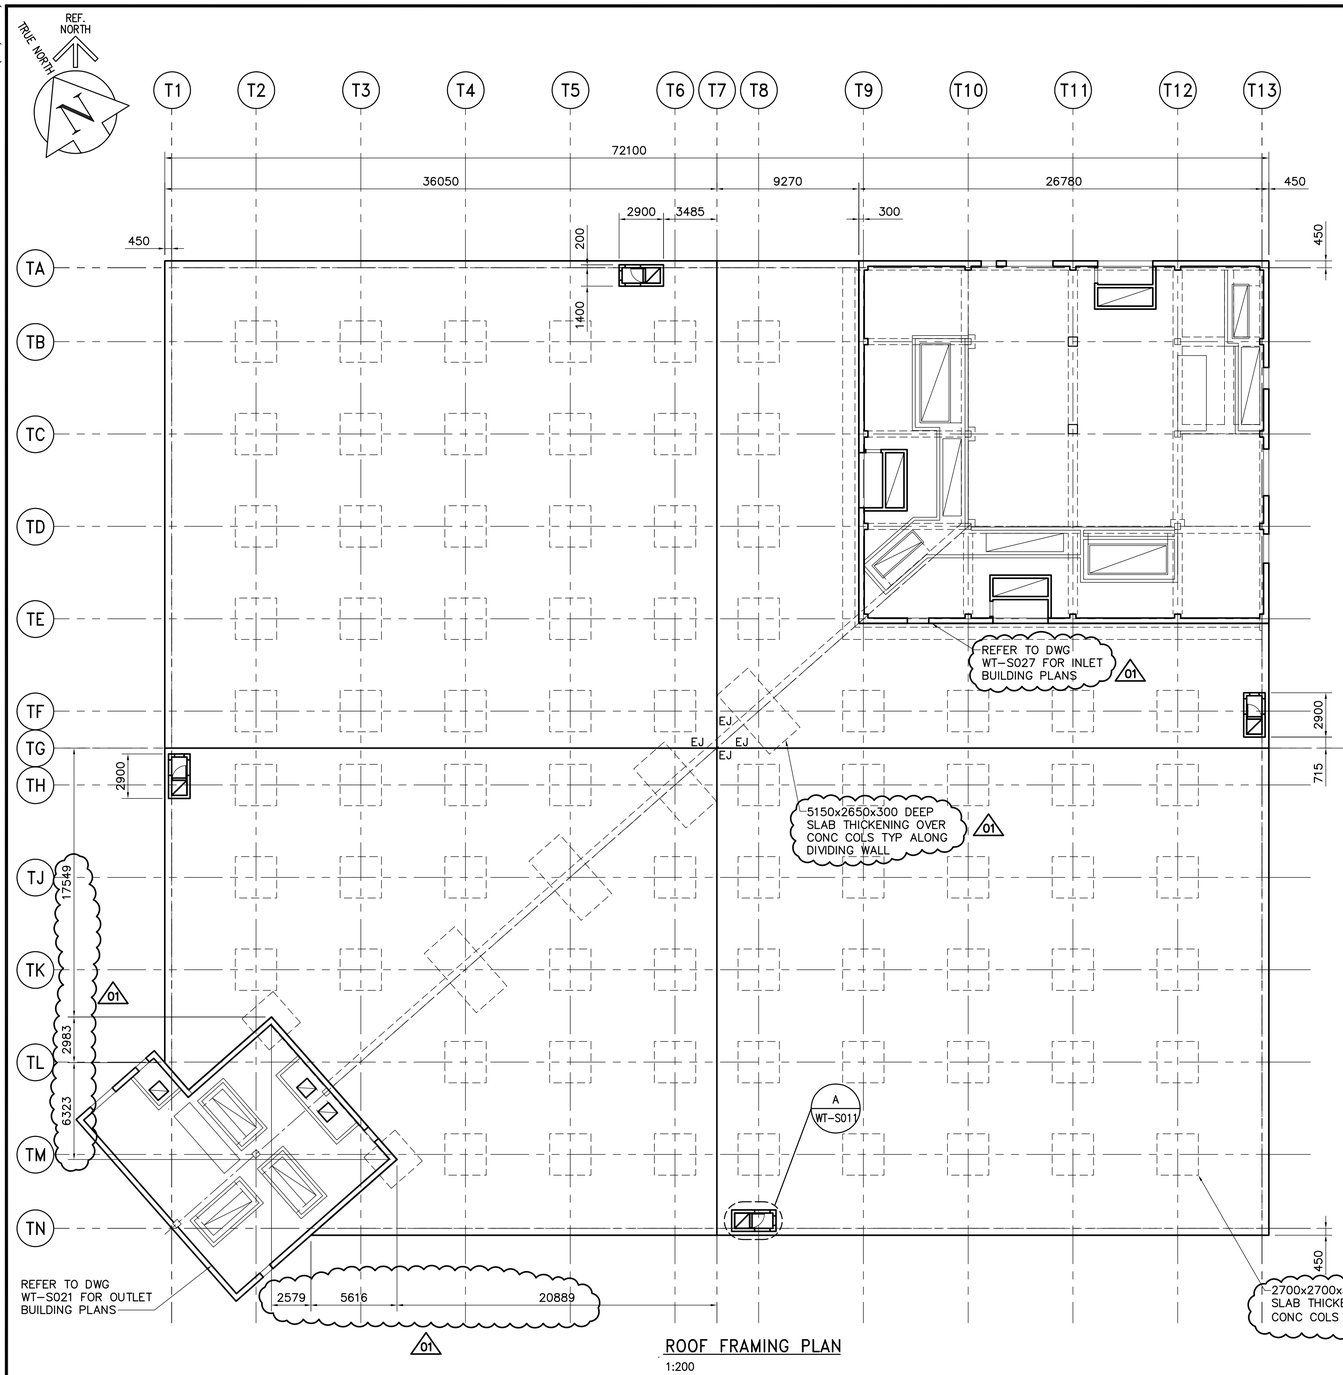

ROOF FRAMING PLAN
1:200

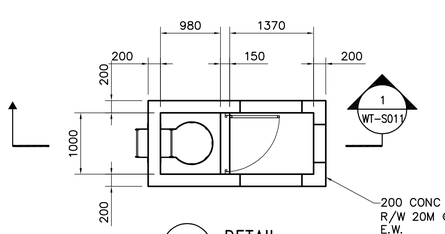

A WT-S011 DETAIL
1:50

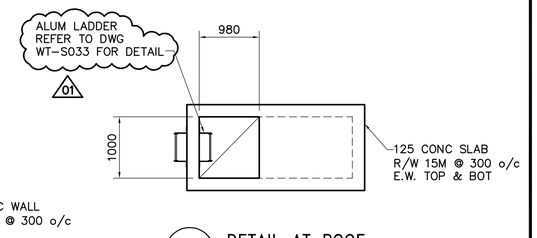

A WT-S011 DETAIL AT ROOF
1:50

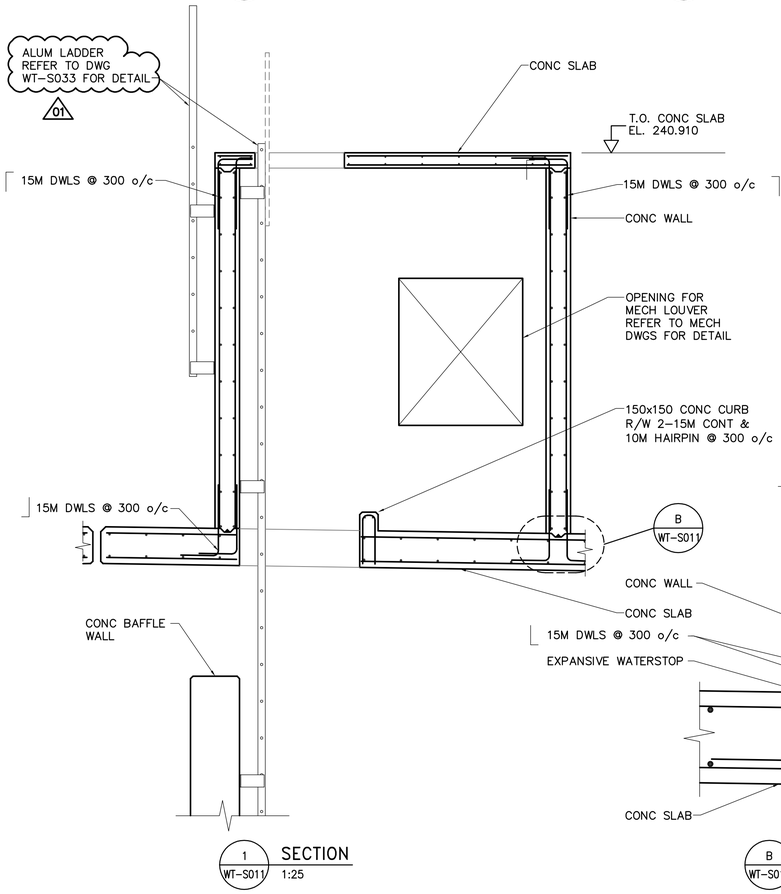

1 WT-S011 SECTION
1:25

B WT-S011 DETAIL
1:10

01
DRAWING NOTES:
1. REFER TO DRAWING WT-S033 FOR TYPICAL REINFORCING AROUND OPENINGS.

APEGM
Certificate of Authorization
Earth Tech Canada Inc.
No. 730 Expiry: April 30, 2006

B.M.
ELEV.

NO.	REVISIONS	DATE	BY
01	166-2005 ADDENDUM 1	05/05/06	C.T.
00	ISSUED FOR TENDER	05/04/17	C.T.

CH2MHILL
Frederickson Cooper ARCHITECTS
EarthTech A Tyco International Ltd. Company

DESIGNED BY	FK	CHECKED BY	MK
DRAWN BY	C.T.	APPROVED BY	AHL
HOR. SCALE: AS NOTED VERTICAL SCALE:		RELEASED FOR CONSTRUCTION BY:	R. SOROKOWSKI
DATE	2005/03/09	DATE	2005-04-17

ENGINEER'S SEAL
ORIGINAL SIGNED BY
F.A. KEMP
2005/04/17

CONSULTANT DRAWING NO.
WT-S011

Winnipeg
THE CITY OF WINNIPEG
WATER AND WASTE DEPARTMENT
ENGINEERING DIVISION

WATER TREATMENT PLANT
CLEARWELL CONSTRUCTION

CITY FILE NUMBER
SHEET OF

STRUCTURAL
ROOF FRAMING PLAN

CITY DRAWING NUMBER
1-0601T-A-S0011-001-01D

05/06/05 09:31am corey.thiessen L:\work\79000\79538\02a-CAD\IND\CONTR\WT-S011.dwg Layout:Layout1