


**FOUNDATION PLAN**  
1:200

- DRAWING NOTES:**
- REFER TO DRAWING WT-S001 FOR GENERAL NOTES.
  - REFER TO DRAWING WT-S002 FOR GRID LINE DIMENSIONS.
  - REFER TO DRAWING WT-S020 FOR EXPANSION AND CONSTRUCTION JOINT DETAILS.
  - CONSTRUCTION JOINT SPACING FOR THE BAFFLE WALLS IS 3000±.

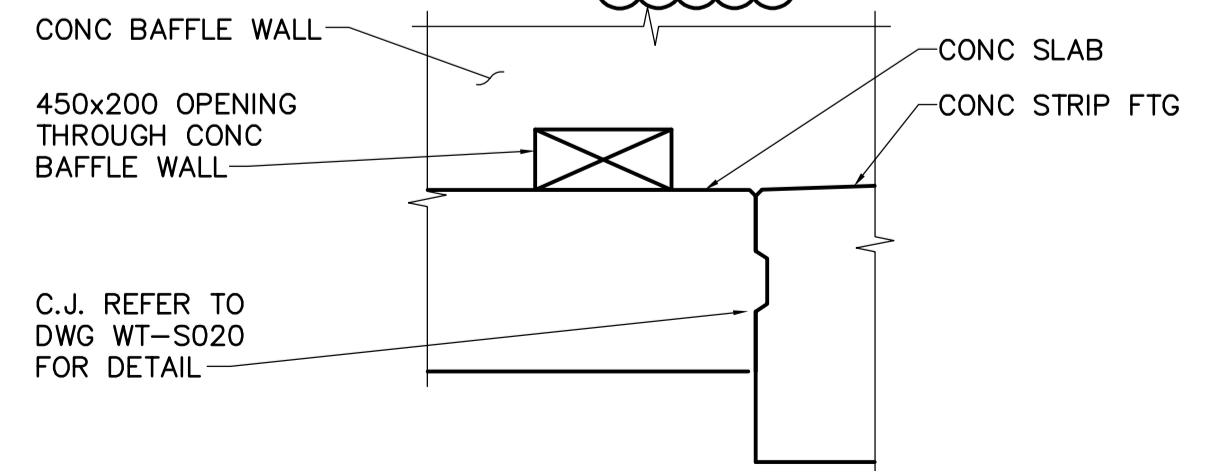

**APECM**  
Certificate of Authorization  
Earth Tech Canada Inc.  
No. 730 Expiry: April 30, 2006

B.M. ELEV.			
DESIGNED BY	FK	CHECKED BY	MK
DRAWN BY	C.T.	APPROVED BY	AHL
HOR. SCALE:	AS NOTED	RELEASED FOR CONSTRUCTION BY:	R. SOROKOWSKI
VERTICAL SCALE:		DATE	2005-04-17
NO. REVISIONS		DATE	2005/02/15
		DATE	2005-04-17

**CH2M HILL**  
Frederickson Cooper  
ARCHITECTS

**EarthTech**  
A Tyco International Ltd. Company

ENGINEER'S SEAL  
ORIGINAL SIGNED BY  
F.A. KEMP  
2005/04/17  
CONSULTANT DRAWING NO.  
WT-S007

**THE CITY OF WINNIPEG**  
WATER AND WASTE DEPARTMENT  
ENGINEERING DIVISION

**WATER TREATMENT PLANT CLEARWELL CONSTRUCTION**

STRUCTURAL FOUNDATION FRAMING PLAN

CITY FILE NUMBER  
SHEET OF  
CITY DRAWING NUMBER  
1-060TT-B-S0007-001-01D