



A DETAIL
 WT-S038 1:10


GEOTEXTILE A
 2 METERS INTO ROOF AT PERIMETER
 2 LAYERS 6 MIL POLY SLIP SHEET
 2 METERS INTO ROOF AT PERIMETER
 GEOTEXTILE 'B'

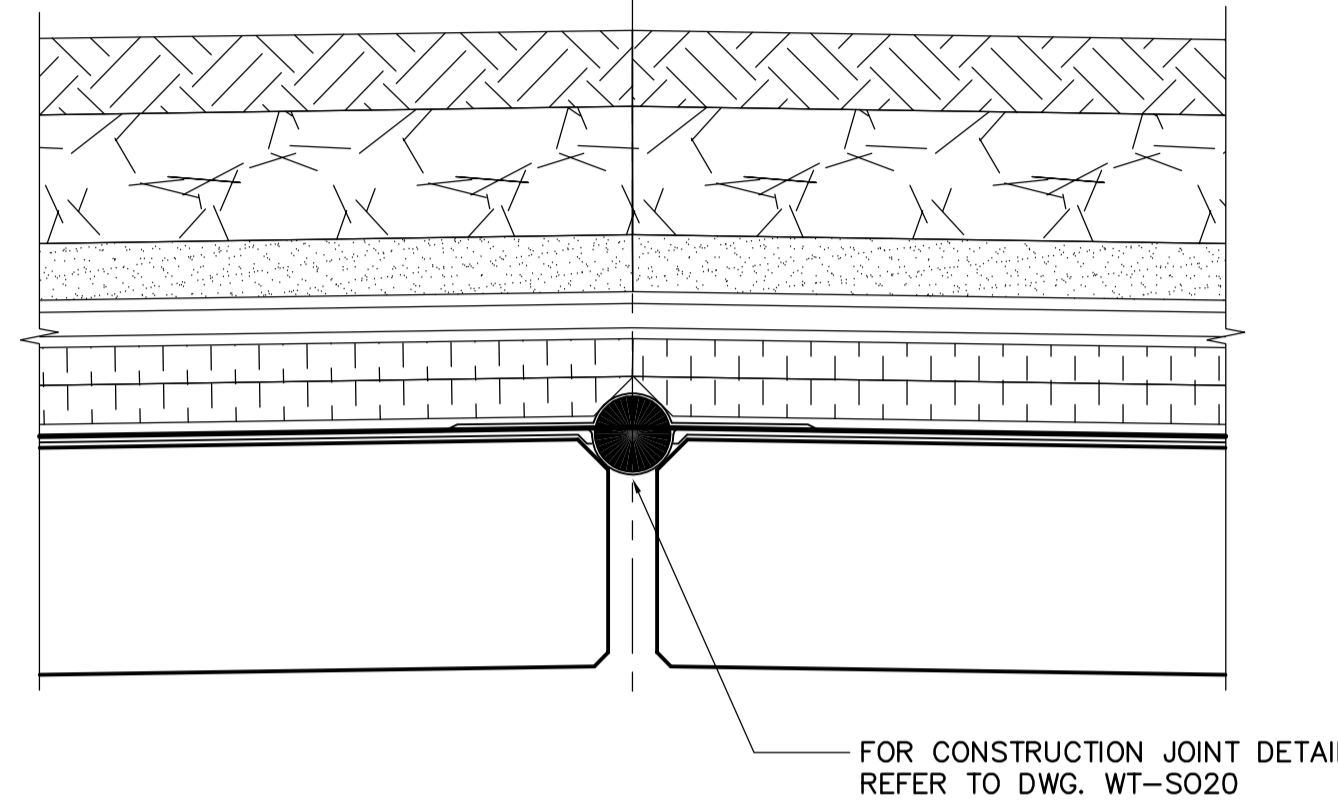

2 SECTION
 WT-S038 1:10

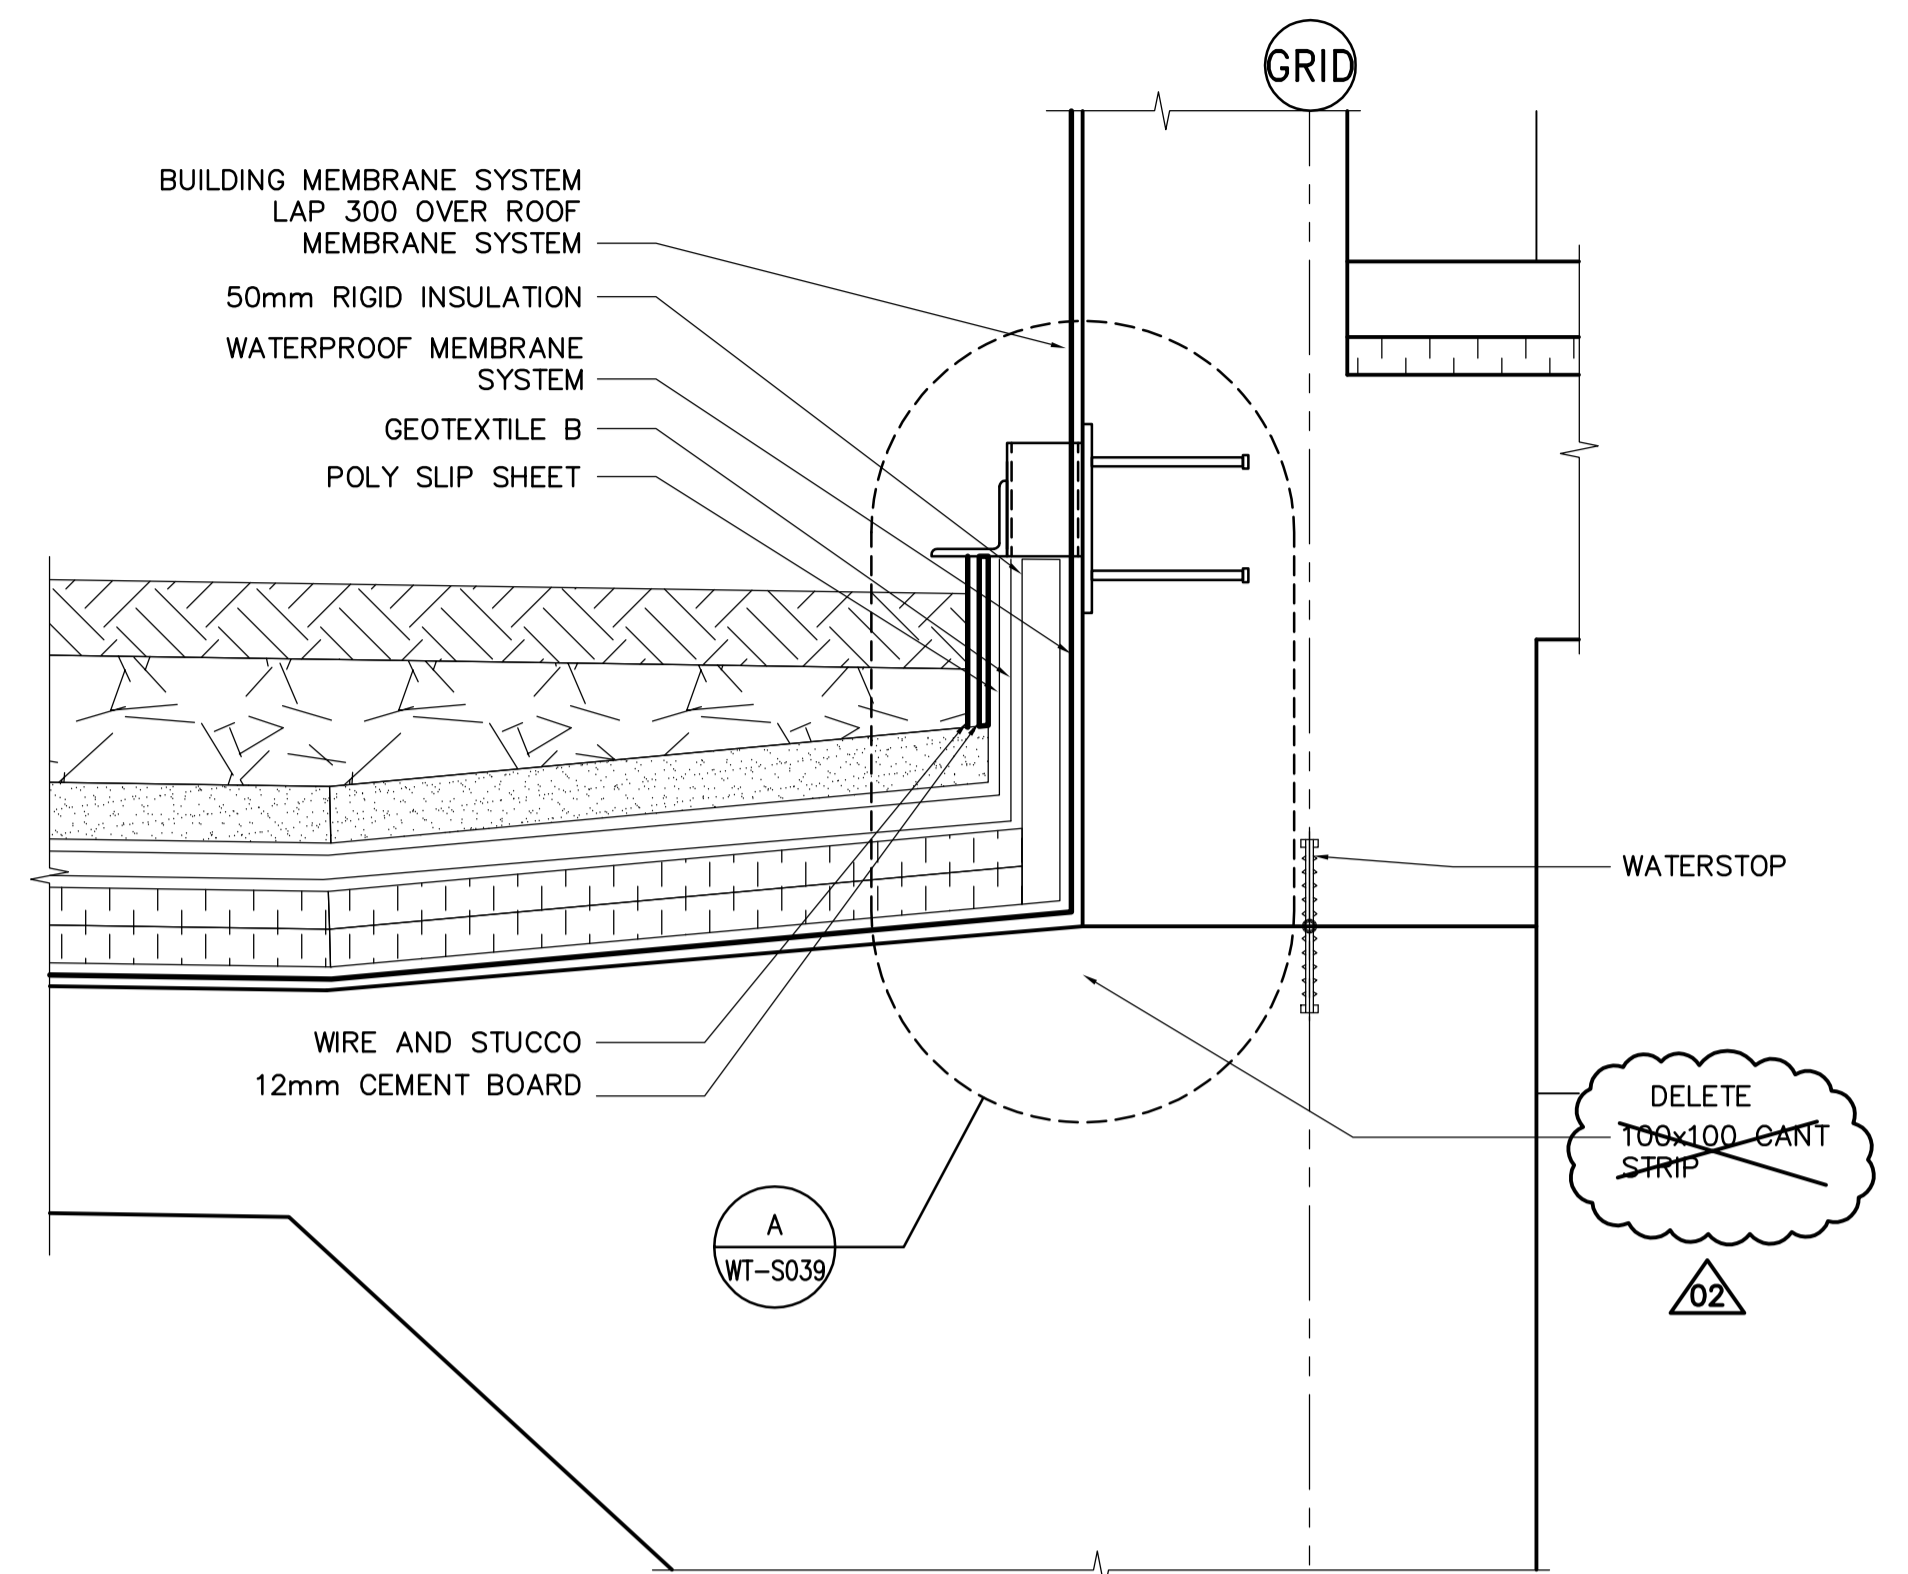

3 SECTION
 WT-S038 1:10

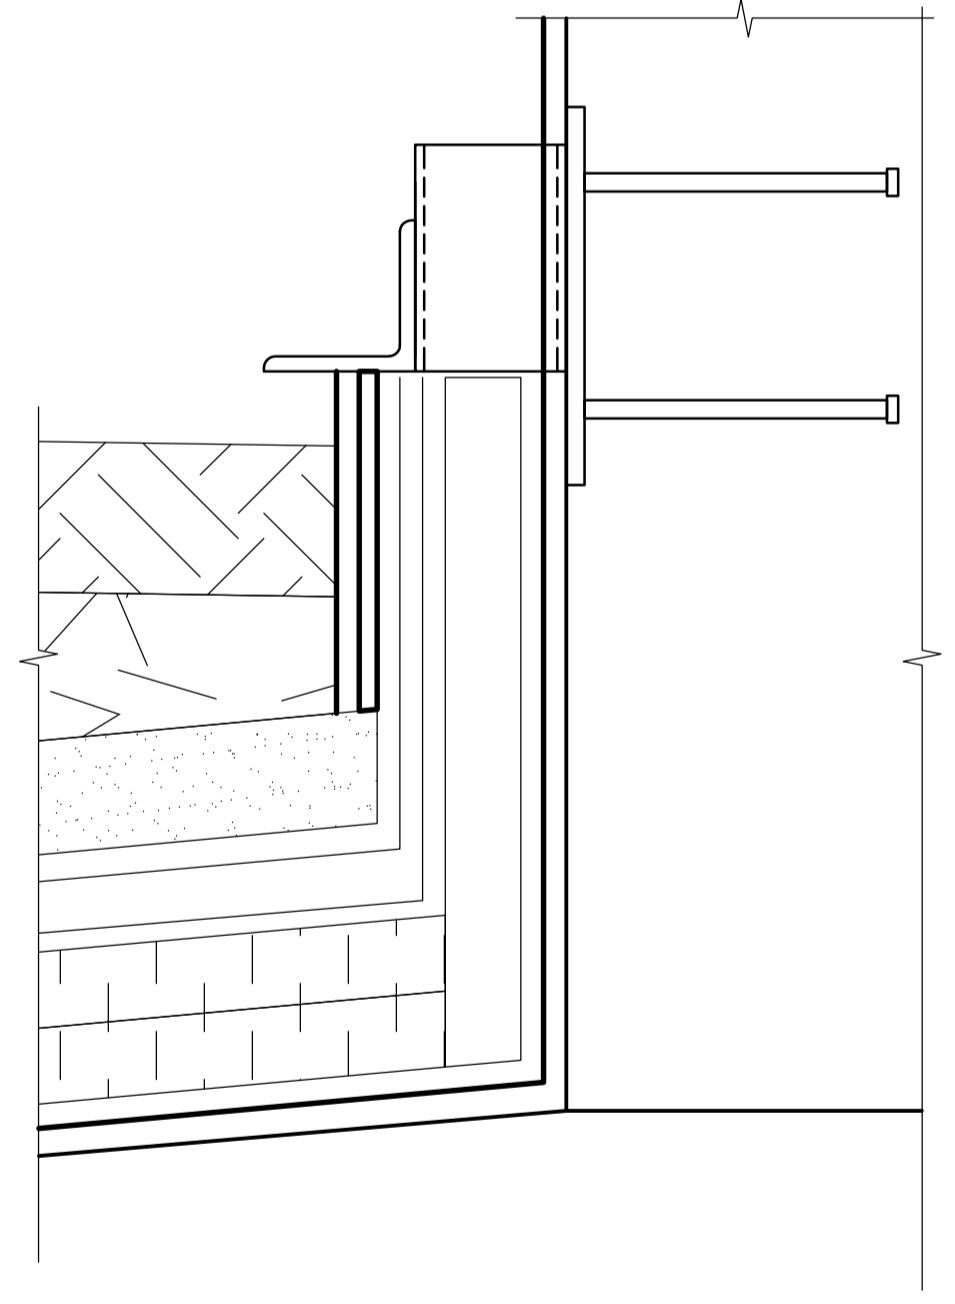

A DETAIL
 WT-S038 1:5

APEGM
 Certificate of Authorization
 Earth Tech Canada Inc.
 No. 730 Expiry: April 30, 2006

NO.	REVISIONS	DATE	BY
02	166-2005 ADDENDUM 2	05/05/12	C.T.
01	166-2005 ADDENDUM 1	05/05/06	C.T.
00	ISSUED FOR TENDER	05/04/17	C.T.

DESIGNED BY	FK	CHECKED BY	MK
DRAWN BY	C.T. / WDB	APPROVED BY	AHL
HOR. SCALE: AS NOTED		RELEASED FOR CONSTRUCTION BY:	
VERTICAL SCALE:		R. SOROKOWSKI	
DATE	2005/03/09	DATE	2005-04-17

ENGINEER'S SEAL
 ORIGINAL SIGNED BY
 F.A. KEMP
 2005/04/17
 CONSULTANT DRAWING NO.
 WT-S039

THE CITY OF WINNIPEG
 WATER AND WASTE DEPARTMENT
 ENGINEERING DIVISION

WATER TREATMENT PLANT CLEARWELL CONSTRUCTION

STRUCTURAL ROOF DRAINAGE SECTIONS AND DETAILS

CITY FILE NUMBER
 SHEET OF
 CITY DRAWING NUMBER
 1-0601T-A-S0039-001-02D