

# **Winnipeg Water Treatment Program**

**Test Pile Driving Records** 

Set 1



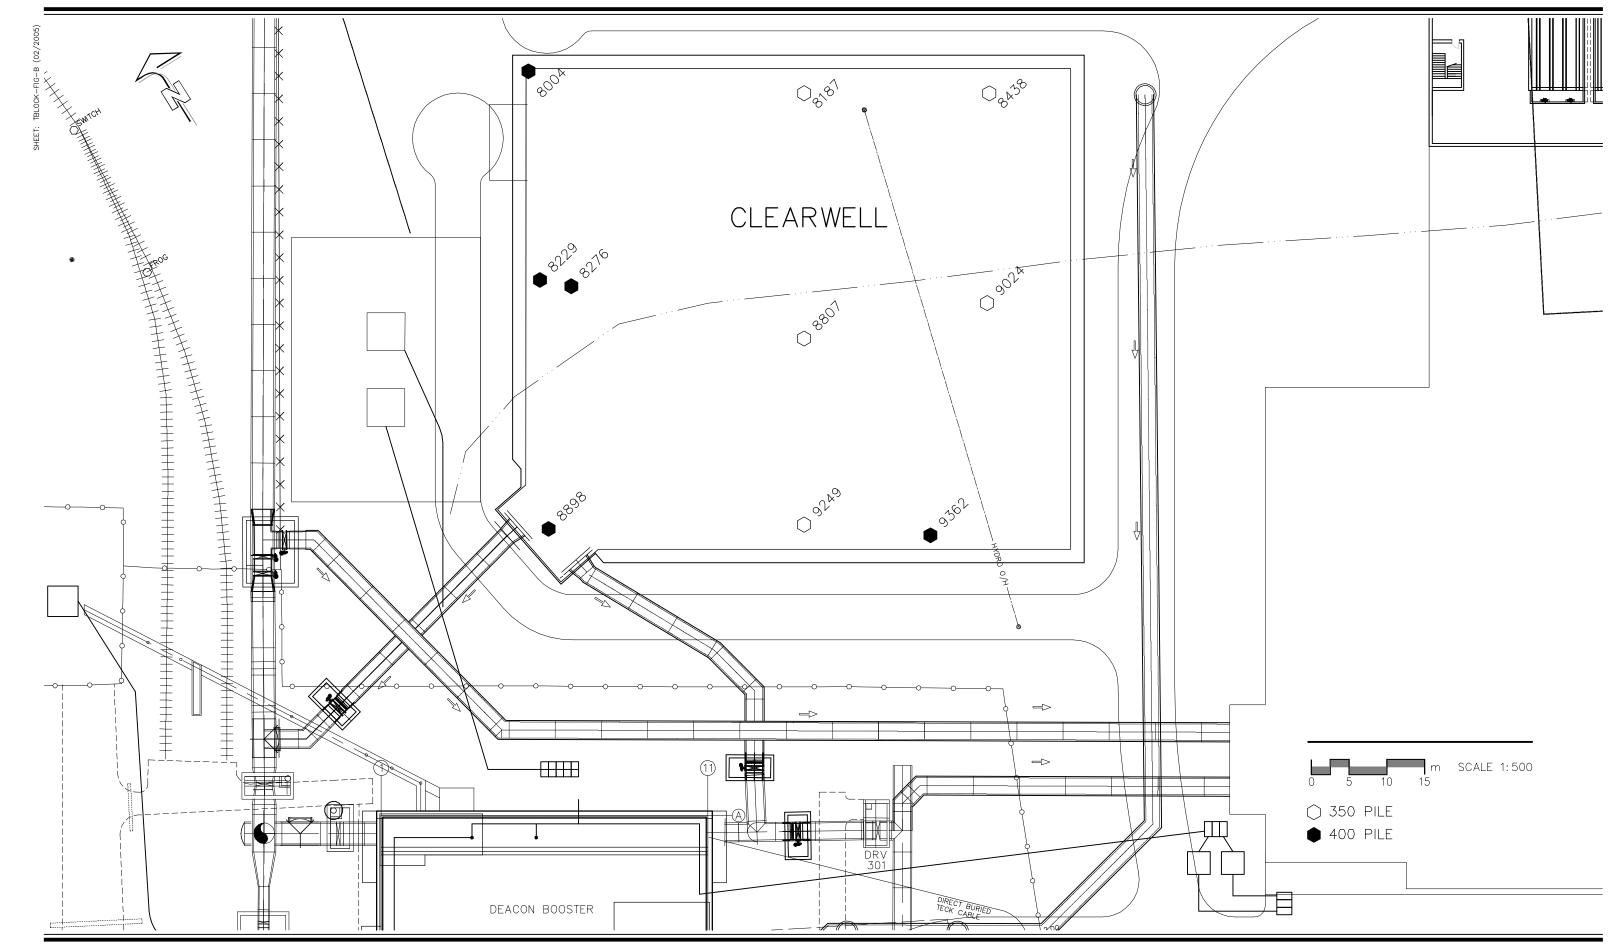

 







# **Test Pile Driving Summary**

Project: City of Winnipeg Water Treatment Plant Client: City of Winnipeg

Contractor: Subterranean (Manitoba) Ltd. Project Number: 3398-055-00

Location: Proposed Clearwell Driving Date: March 2, 2005

Driving Hammer: Link Belt 520 Personnel: Nelson Ferreira, M.Sc., EIT

Follower 8.2m Pile Length: 19.0m

Pile #	Northing (m)	Easting (m)	Ground Elevation (m)	Top of Pile (m)	Tip Elevation (m)	Pile Diameter (mm)	Refusal Criteria*	Final Set (mm)
9362	5524079.56	647811.39	237.20	233.55	214.55	400	15	22/19/13
8276	5524132.64	647788.49	236.95	233.65	214.65	400	15	19/13/13
8004	5524159.76	647798.73	237.02	235.04	216.04	400	15	25/20/20
8229	5524135.53	647785.42	236.90	233.95	214.95	400	15	25/19/19
8898	5524106.99	64776897	236.13	234.50	215.50	400	15	15/15/15
9249	5524089.58	647797.95	236.54	234.59	215.59	350	10	25/25/10
9024	5524101.65	647833.99	238.47	234.49	215.49	350	10	19/19/13
8807	5524110.47	647810.96	237.57	233.91	214.91	350	10	20/10/10
8187	5524137.99	647828.13	238.20	234.58	215.58	350	10	23/19/10
8438	5524125.03	647848.92	239.07	234.39	215.39	350	10	8/6/0

<sup>\*</sup>Refusal criteria increased 25% due to Follower.












Project: Water Treatment Client: City of Winnipeg Location: ClearWell

Plant Test Pile Prgm

Contractor: Subterranean Ltd. Project No: 3398-055-00 Personel: Nelson Ferreira, M.Sc., EIT

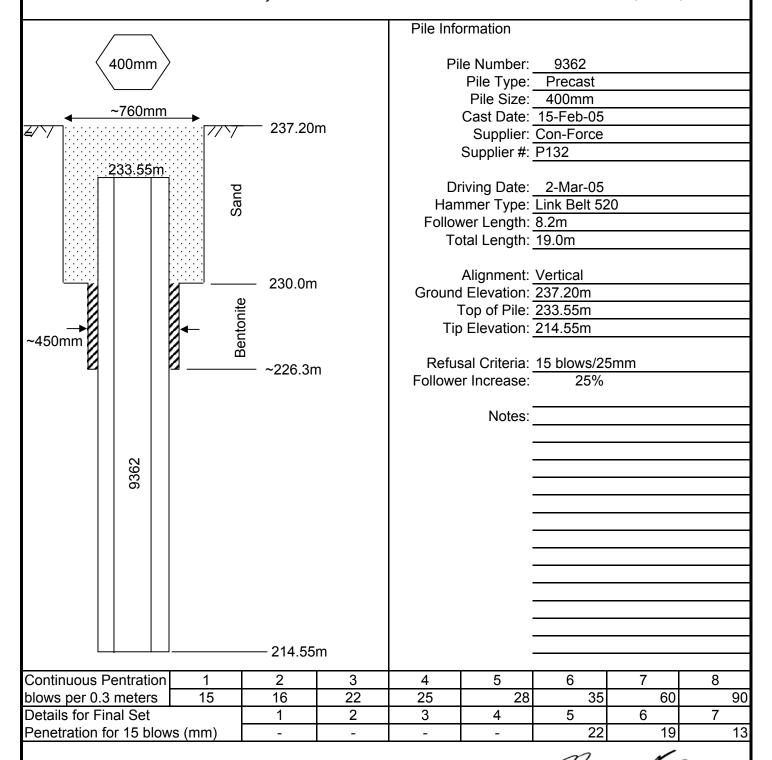

Does Pile Meet Specifications?



Ν

Per:



Project: Water Treatment

Plant Test Pile Prgm


Contractor: Subterranean Ltd.

Client: City of Winnipeg

Location: ClearWell

Project No: 3398-055-00

Personel: Nelson Ferreira, M.Sc., EIT

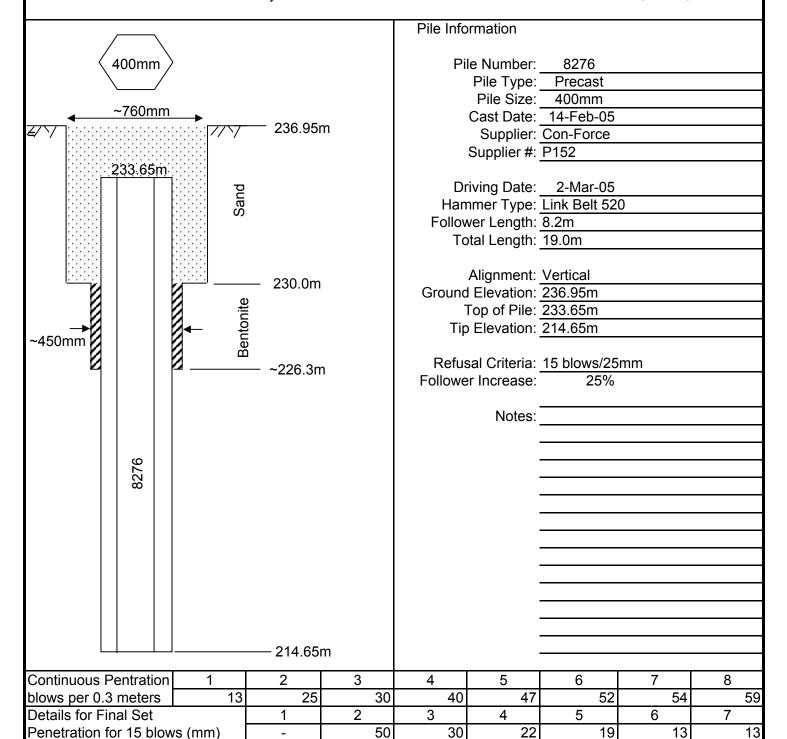

Does Pile Meet Specifications?



Ν


Per:



Project: Water Treatment Client: City of Winnipeg Location: ClearWell

Plant Test Pile Prgm

Contractor: Subterranean Ltd. Project No: 3398-055-00 Personel: Nelson Ferreira, M.Sc., EIT

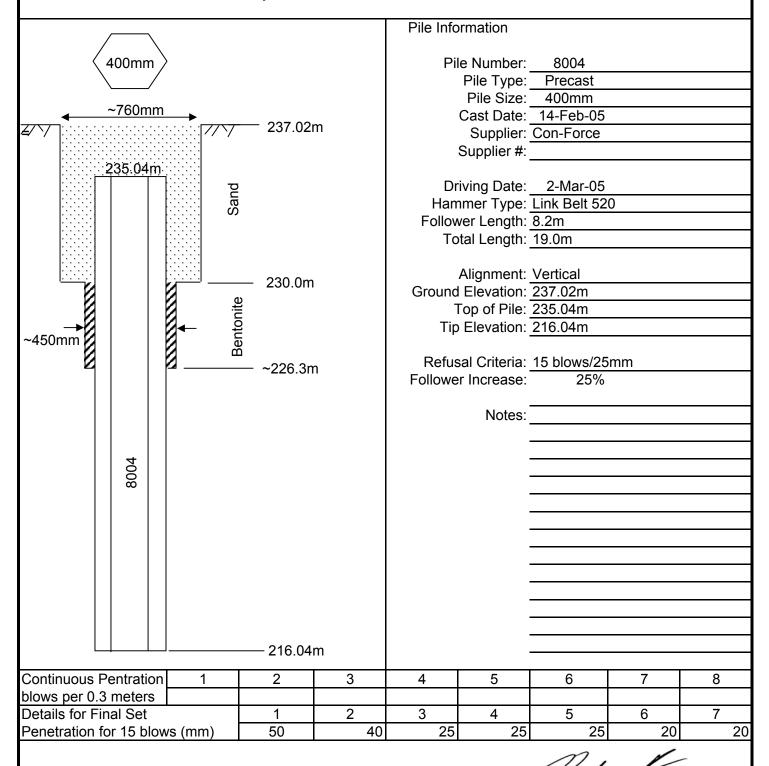

Does Pile Meet Specifications?



Ν

Per:



Project: Water Treatment

Plant Test Pile Prgm


Contractor: Subterranean Ltd.

Client: City of Winnipeg

Location: ClearWell

Project No: 3398-055-00 Persone

Personel: Nelson Ferreira, M.Sc., EIT

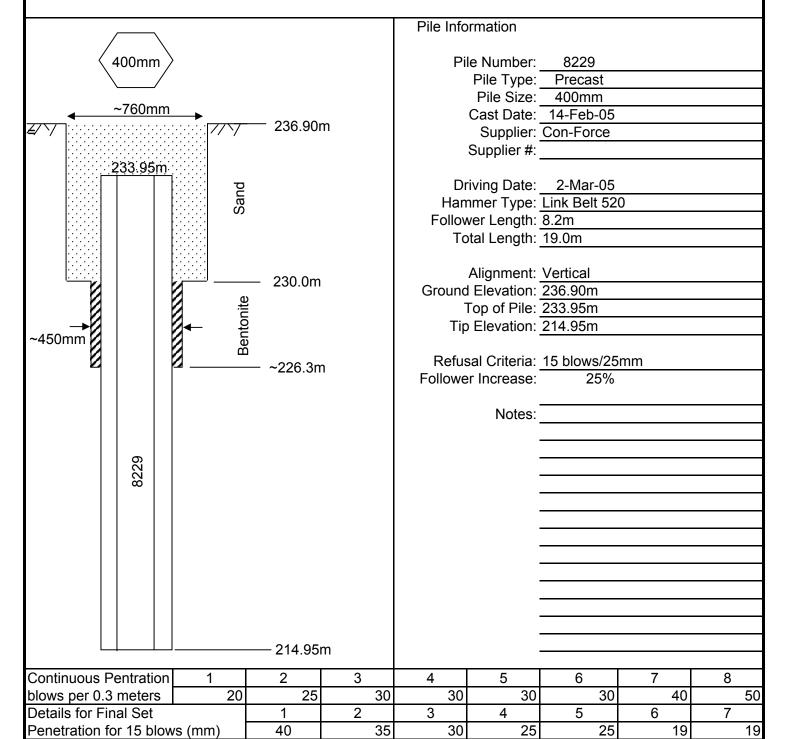

Does Pile Meet Specifications?

(Y)

Ν


Per:



Project: Water Treatment Client: City of Winnipeg Location: ClearWell

Plant Test Pile Prgm

Contractor: Subterranean Ltd. Project No: 3398-055-00 Personel: Nelson Ferreira, M.Sc., EIT

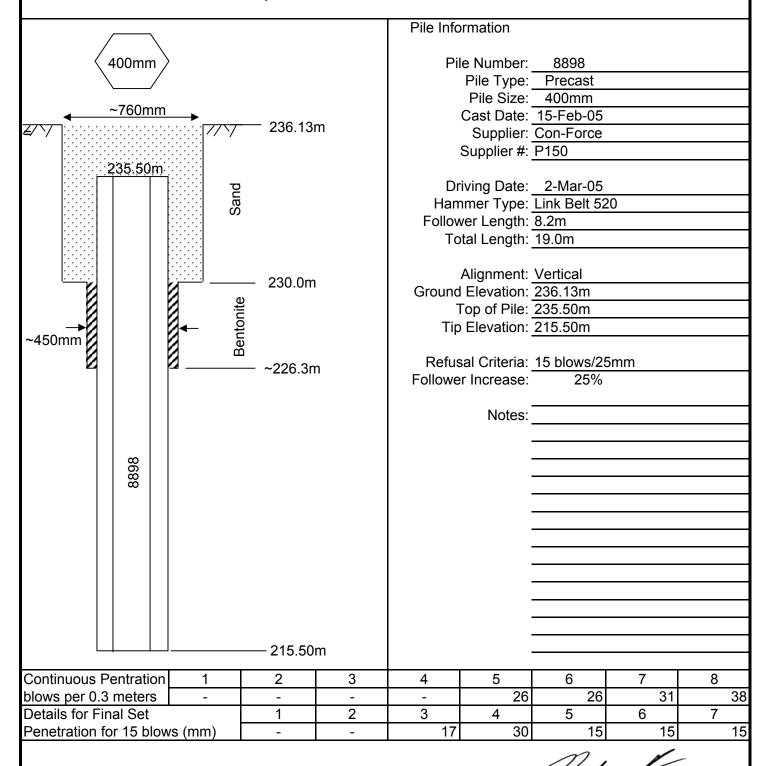

Does Pile Meet Specifications?



Ν


Per:



Project: Water Treatment Client: City of Winnipeg Location: ClearWell

Plant Test Pile Prgm

Contractor: Subterranean Ltd. Project No: 3398-055-00 Personel: Nelson Ferreira, M.Sc., EIT

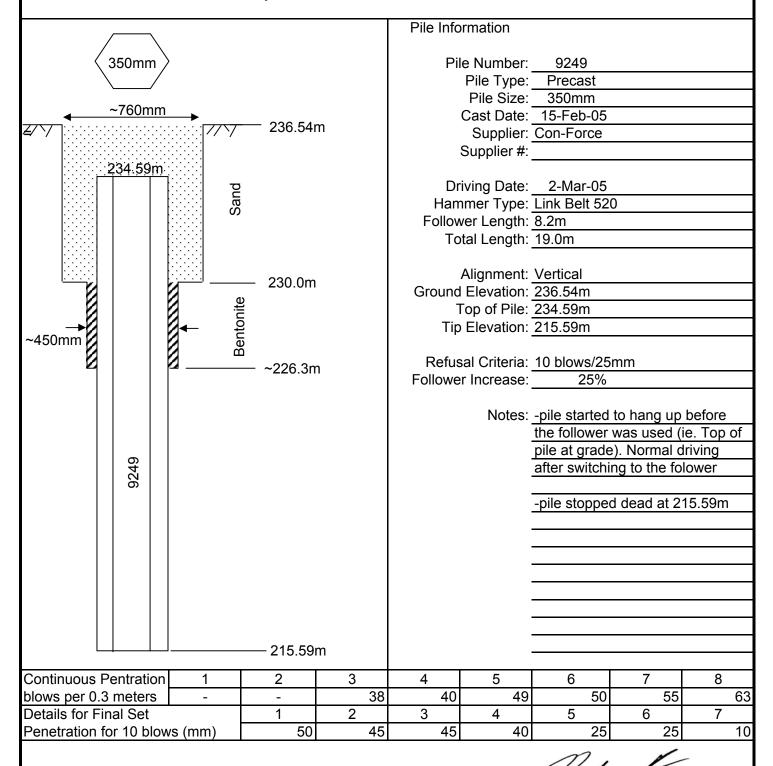

Does Pile Meet Specifications?



Ν


Per:



Project: Water Treatment Client: City of Winnipeg Location: ClearWell

Plant Test Pile Prgm

Contractor: Subterranean Ltd. Project No: 3398-055-00 Personel: Nelson Ferreira, M.Sc., EIT

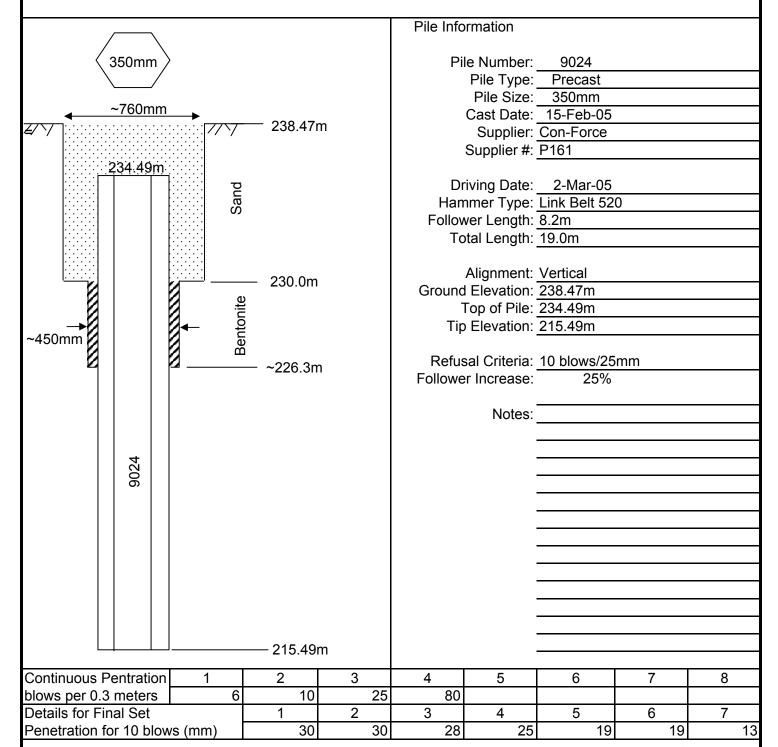

Does Pile Meet Specifications?



Ν


Per:



Project: Water Treatment Client: City of Winnipeg Location: ClearWell

Plant Test Pile Prgm

Contractor: Subterranean Ltd. Project No: 3398-055-00 Personel: Nelson Ferreira, M.Sc., EIT

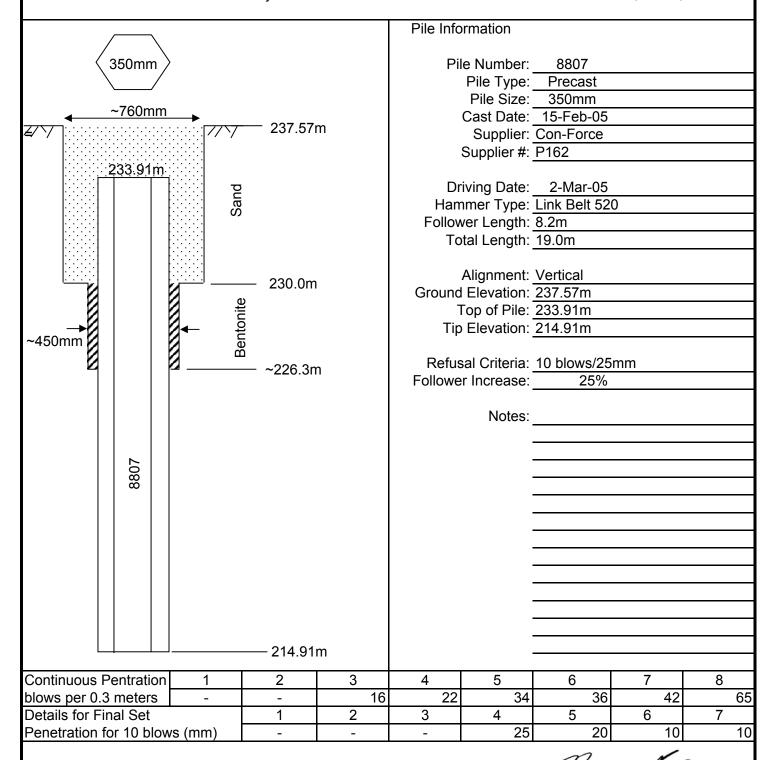

Does Pile Meet Specifications?



Ν


Per:



Project: Water Treatment Client: City of Winnipeg Location: ClearWell

Plant Test Pile Prgm

Contractor: Subterranean Ltd. Project No: 3398-055-00 Personel: Nelson Ferreira, M.Sc., EIT

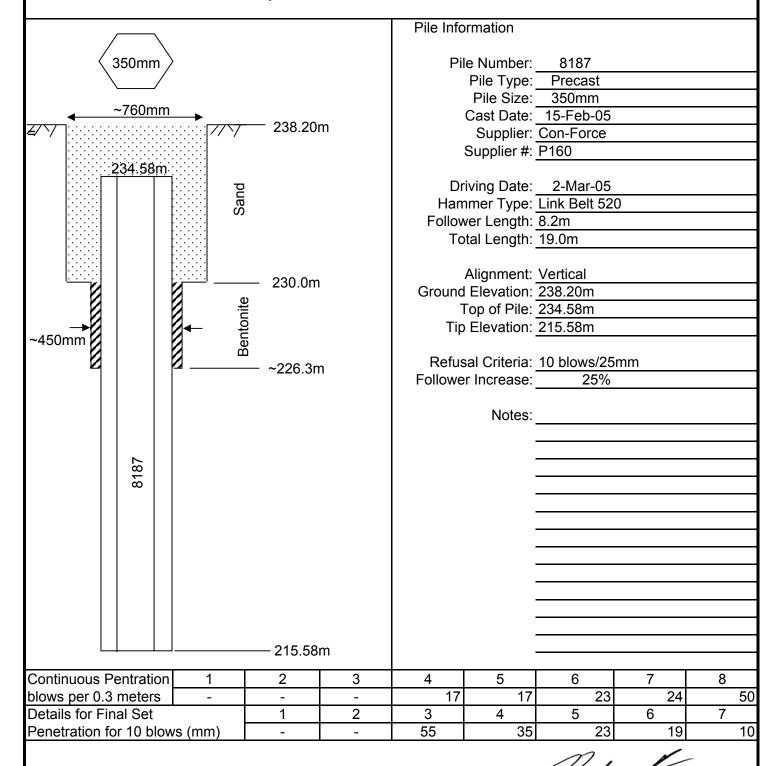

Does Pile Meet Specifications?



Ν


Per:



Project: Water Treatment Client: City of Winnipeg Location: ClearWell

Plant Test Pile Prgm

Contractor: Subterranean Ltd. Project No: 3398-055-00 Personel: Nelson Ferreira, M.Sc., EIT

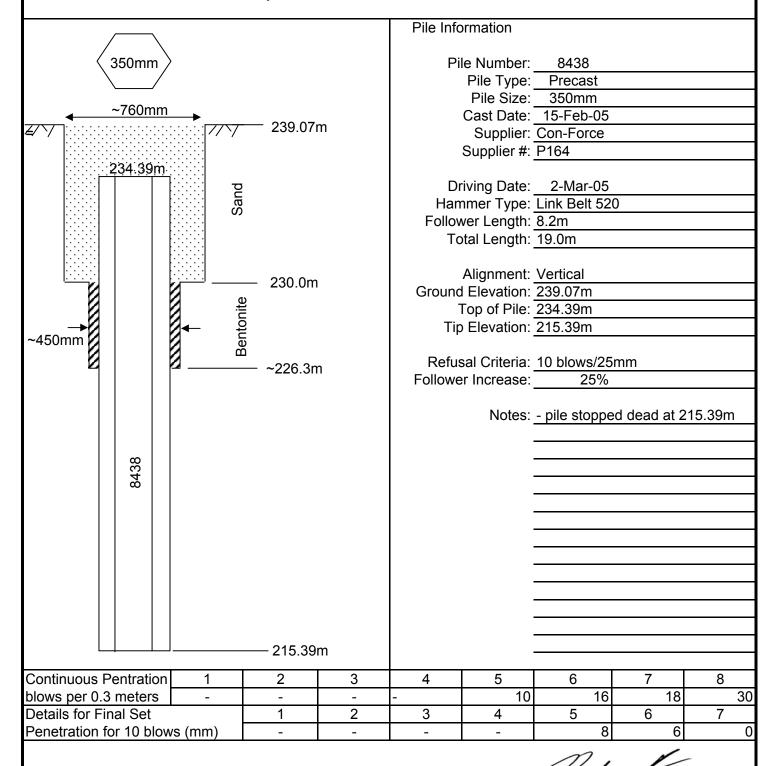

Does Pile Meet Specifications?



Ν

Per: