

2. Up dated by Pto. Plan 17.05.83 WEA

NO.	PARTICULARS	DATE	BY
1	EXIT DOORS & LANDING	21.03.80 J.B.R.L.	

REVISIONS

CHECKED FOR:
 DESIGN
 DETAILS
 STRUCTURE
 MECHANICAL
 ELECTRICAL

PRINTING DATE
 17 MAR 80

DRAWN BY BR
 17 MAR 80



Drawings and specifications, as instruments of service are the property of the architect, the copyright in the same being reserved by them. No reproduction may be made without the permission of the architect and when made, must bear their names. All prints to be returned.
 The contractor is to verify dimensions and data noted herein with conditions on the site and is held responsible for reporting any discrepancy to the architect for adjustment.
 This drawing is not to be used for building purposes until countersigned by

The
WINNIPEG ARENA ARCHITECTS
 A consortium of
 I.R.D. Turner Architect
 The LM Architectural Group
 453 Qu'Appelle Winnipeg
 204 942-1303

WINNIPEG ARENA EXPANSION PROJECT

For
THE WINNIPEG ENTERPRISES CORP.
FLOOR PLAN LEVEL #1
 0'-0" ELEV.

DA2

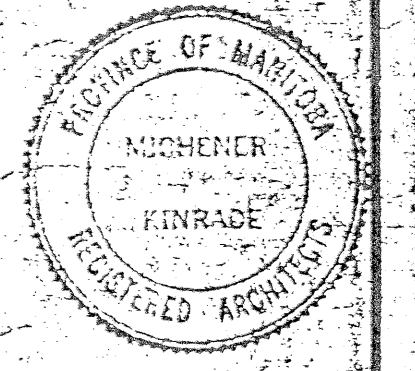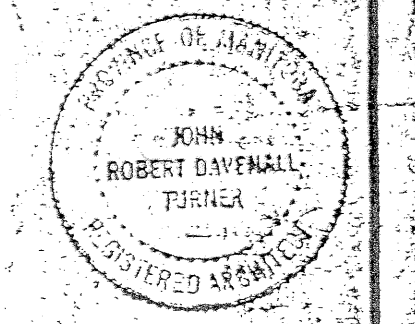

LEVEL 0-0
 SCALE 1/8" = 1'-0"

