


- UP DATE OF PRO-PLAN 18.02.88 - WEA
- DOOR RELOCATED 15.44-80 C.W.D.
- HANDRAIL ADDED 15.44-80 C.W.D.
- VESTIBULE ADDED 15.44-80 C.W.D.
- FIREPROOF LANDING 15.44-80 C.W.D.
- BEER GARDENS 15.44-80 C.W.D.
- EXIT DOORS LANDING 15.44-80 C.W.D.
- STAIRS 15.44-80 C.W.D.
- FRONT EXIT DOOR 15.44-80 C.W.D.
- DATE: BY:

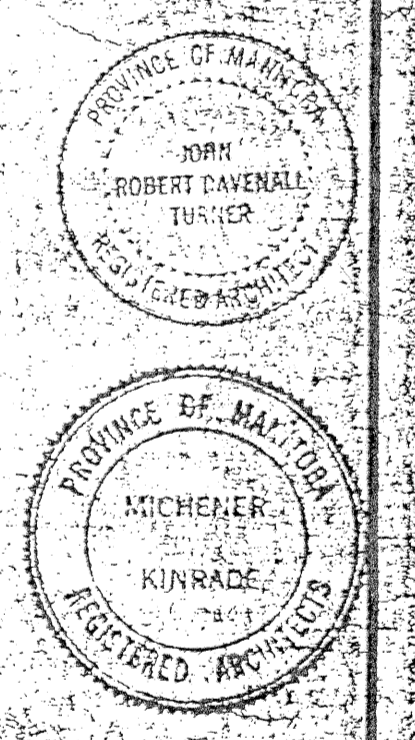

Drawings and specifications, as instruments of service, are the property of the architect. The copyright in the same being reserved to them. No reproduction may be made without the permission of the architect. All when made, must bear their names. All prices to be returned.

The contractor is to verify dimensions and data noted herein, with conditions on the site and is held responsible for reporting any discrepancy to the architect for adjustment.

This drawing is not to be used for building purposes until counterchecked by:

**WINNIPEG ARENA ARCHITECTS**  
 A consortium of  
 J.R.D. Turner Architect  
 The LM Architectural Group  
 453 Our Appelle Winnipeg  
 204-942-1303

**WINNIPEG ARENA EXPANSION PROJECT**

For  
**THE WINNIPEG ENTERPRISES GROUP**  
**FLOOR PLAN LEVEL #2**  
 15'-0 1/2" ELEV.  
**DA3**

NOTE:  
 ALL EXIT DOORS SHALL BE EQUIPPED WITH PANIC HARDWARE AND OPEN IN THE DIRECTION OF TRAVEL WITHOUT THE USE OF KEYS BOTH EXISTING & NEW DOORS.

SEE LARGE SCALE PLAN DRWG # A16

CONC STEPS AS AT OPP END

CONC STEPS & LANDING 2 RISERS @ 7 1/2" x 5'-0" 77 RISES @ 10" x 5'-10" SEE SHEET A-5 FOR ELEVATION OF STEPS AND HAND RAIL.

FIREPROOF W/S OF LANDING & UP TO DOWNWELL WITH 7/8" FIREGUARD 4 1/2" TO FLOOR 1 1/2" H.C.

LEVEL 15'-0 1/2"  
 BEARING 116° 1' 0"

HIGH VOLTAGE LINE UNDERGROUND

FIREPROOF CONCRETE TOWER