
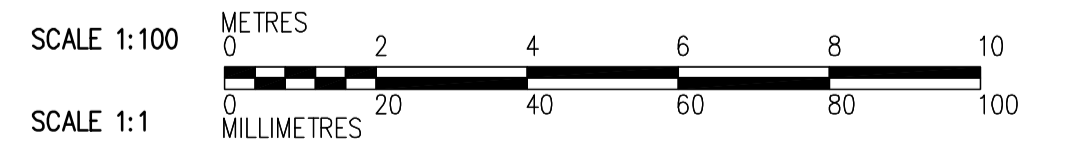
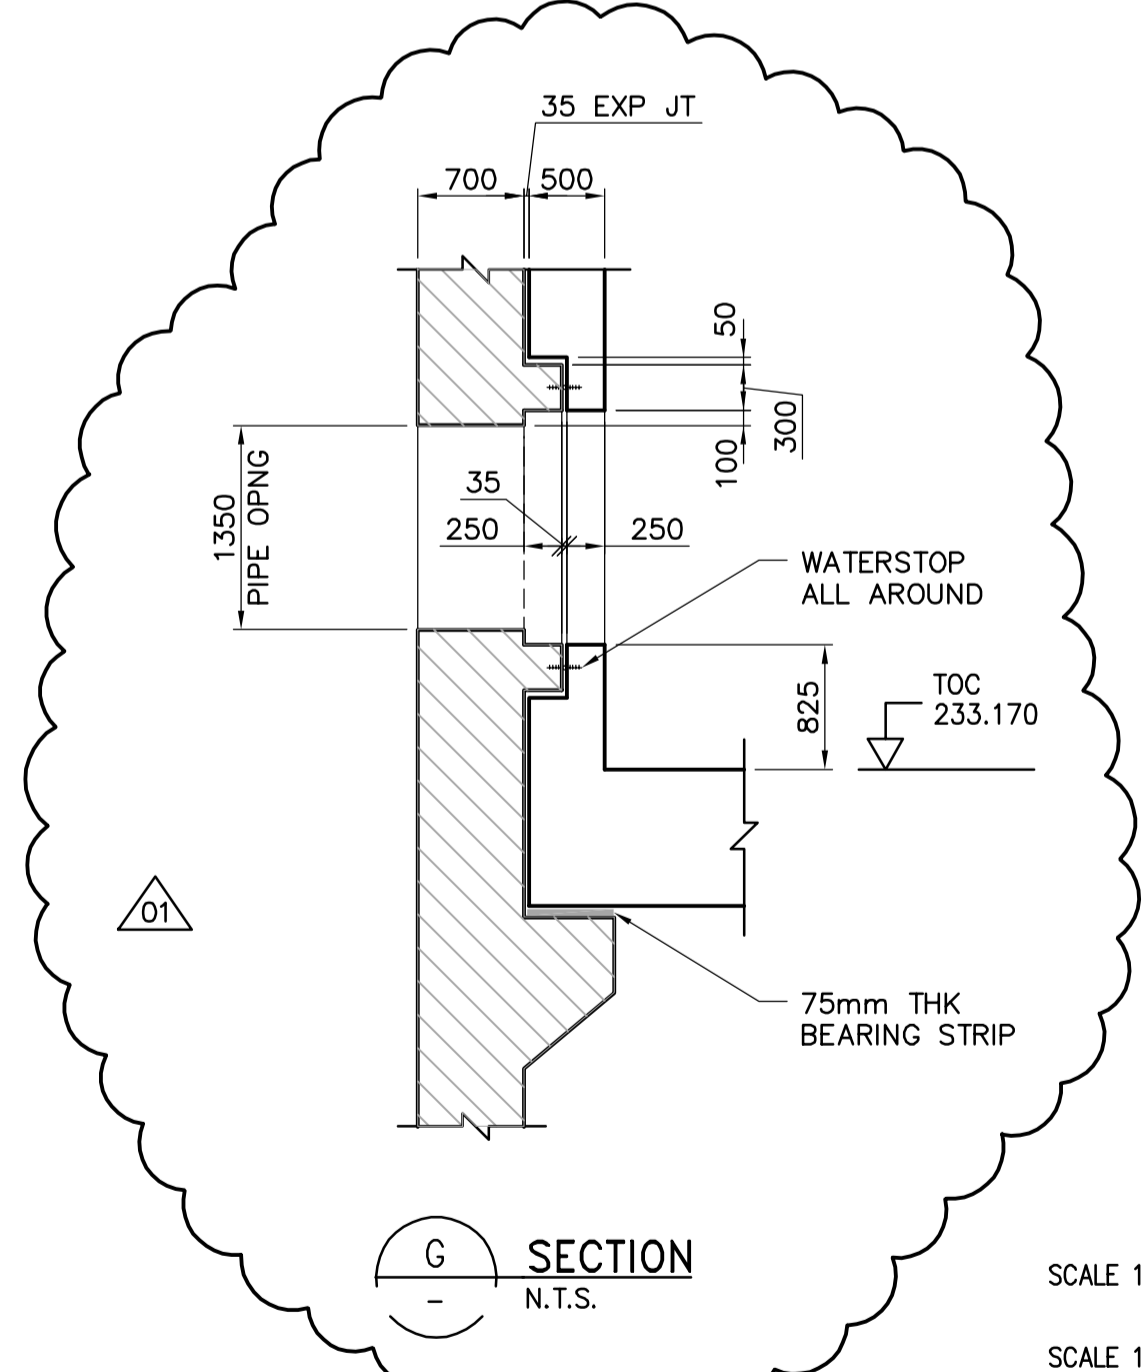


- NOTES:**
- DESIGN LIVE LOAD IS 4.8 kPa UNO.
 - FOR COLUMN AND BEAM SCHEDULE SEE DWG WA-S0515.
 - FOR WALL CORNERS REINF, SEE DWG WA-S0101.

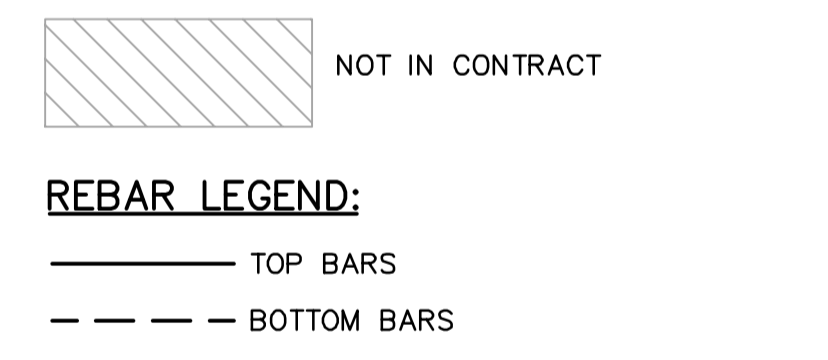

FIRST FLOOR PLAN
1:100

<p>APEGN Certificate of Authorization CH2M HILL Canada Ltd. No. 1441 Expiry: April 30, 2006</p>	<p>Frederickson Cooper ARCHITECTS</p>		<p>EarthTech A Tyco International Ltd. Company</p>		<p>ENGINEER'S SEAL</p> <p>ORIGINAL SIGNED BY D. KRUGER 2006/02/06</p>	<p>THE CITY OF WINNIPEG WATER AND WASTE DEPARTMENT ENGINEERING DIVISION</p> <p>WATER TREATMENT PLANT ADMINISTRATION FOUNDATIONS AND CONCRETE STRUCTURES</p> <p>STRUCTURAL ADMINISTRATION AREA FIRST FLOOR PLAN</p>	<p>CITY FILE NUMBER</p>																												
	<table border="1"> <tr> <th>B.M.</th> <th>ELEV.</th> <th>DATE</th> <th>BY</th> </tr> <tr> <td>01</td> <td>583-2005 ADDENDUM 3</td> <td>06/03/10</td> <td>EL</td> </tr> <tr> <td>00</td> <td>ISSUED FOR TENDER</td> <td>2006/02/03</td> <td>MC</td> </tr> <tr> <td>NO.</td> <td>REVISIONS</td> <td>DATE</td> <td>BY</td> </tr> </table>	B.M.	ELEV.	DATE	BY		01	583-2005 ADDENDUM 3	06/03/10	EL	00	ISSUED FOR TENDER	2006/02/03	MC	NO.	REVISIONS	DATE	BY	<table border="1"> <tr> <td>DESIGNED BY</td> <td>MC</td> <td>CHECKED BY</td> <td>AP</td> </tr> <tr> <td>DRAWN BY</td> <td>RL</td> <td>APPROVED BY</td> <td>DJT</td> </tr> <tr> <td>SCALE:</td> <td>1:100</td> <td>RELEASED FOR CONSTRUCTION BY:</td> <td>R. SOROKOWSKI</td> </tr> <tr> <td>DATE</td> <td>2005/07/04</td> <td>DATE</td> <td>2006/02/08</td> </tr> </table>	DESIGNED BY	MC	CHECKED BY	AP	DRAWN BY	RL	APPROVED BY	DJT	SCALE:	1:100	RELEASED FOR CONSTRUCTION BY:	R. SOROKOWSKI	DATE	2005/07/04	DATE	2006/02/08
B.M.	ELEV.	DATE	BY																																
01	583-2005 ADDENDUM 3	06/03/10	EL																																
00	ISSUED FOR TENDER	2006/02/03	MC																																
NO.	REVISIONS	DATE	BY																																
DESIGNED BY	MC	CHECKED BY	AP																																
DRAWN BY	RL	APPROVED BY	DJT																																
SCALE:	1:100	RELEASED FOR CONSTRUCTION BY:	R. SOROKOWSKI																																
DATE	2005/07/04	DATE	2006/02/08																																