
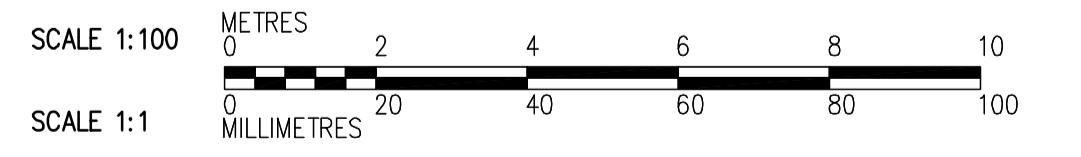


- NOTES:**
- DESIGN LIVE LOAD IS 14.4kPa.
 - FOR BEAM AND COLUMN SCHEDULE SEE DWG WC-S0515.
 - PROVIDE CURBS FOR CMU WALLS INSTALLED IN SEPARATE CONTRACT. COORDINATE CURB WIDTH WITH CMU WALL WIDTH. FOR BIDDING PURPOSES ASSUME CURBS ARE 210mm WIDE.

REBAR LEGEND:

—— TOP BARS
 - - - - BOTTOM BARS

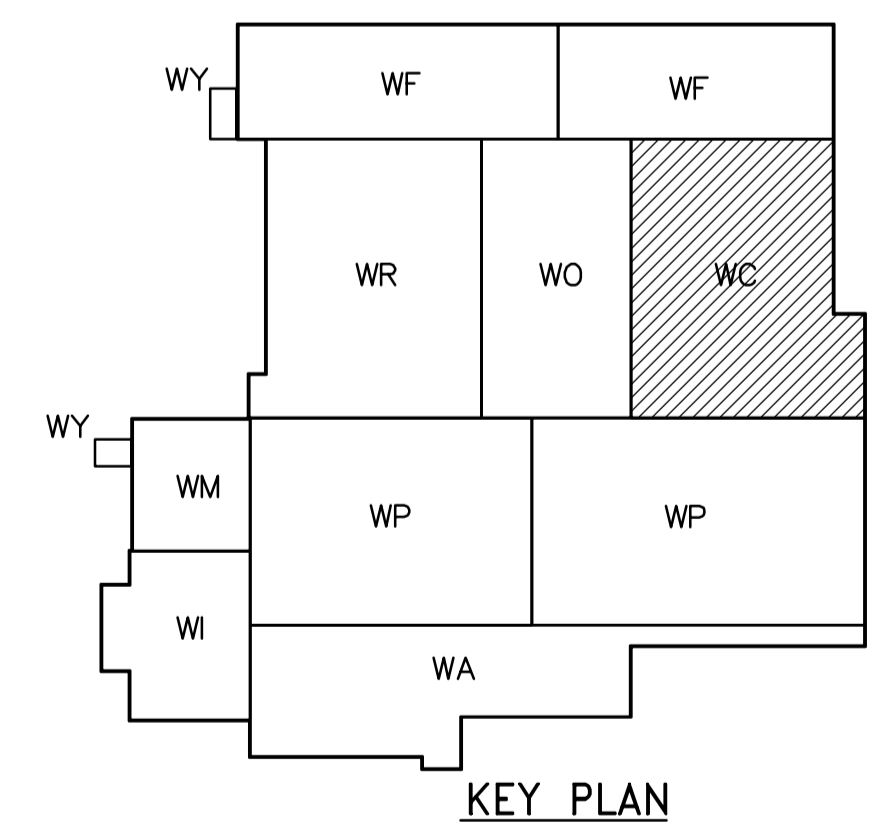

PLAN AT ELEVATION 241.700
 1:100

APECA
 Certificate of Authorization
 CH2M HILL Canada Ltd.
 No. 1441 Expiry: April 30, 2006

NO.	REVISIONS	DATE	BY
01	583-2005 ADDENDUM 3	06/03/10	EL
00	ISSUED FOR TENDER	2006/02/03	EL

CH2MHILL Frederickson Cooper ARCHITECTS		EarthTech A Tyco International Ltd. Company	
DESIGNED BY	EL	CHECKED BY	AP
DRAWN BY	RL/DJ	APPROVED BY	DJT
SCALE:	1:100	RELEASED FOR CONSTRUCTION BY:	R. SOROKOWSKI
DATE	2005/07/06	DATE	2006/02/08

ENGINEER'S SEAL
 ORIGINAL SIGNED BY
 D. KRUGER
 2006/02/06
 CONSULTANT DRAWING NO.
 WC-S0121

THE CITY OF WINNIPEG
 WATER AND WASTE DEPARTMENT
 ENGINEERING DIVISION

WATER TREATMENT PLANT
 CHEMICAL FEED SYSTEMS
 FOUNDATIONS AND CONCRETE STRUCTURES

STRUCTURAL
 INSTRUMENT ROOM AREA
 UPPER PLAN

CITY FILE NUMBER
 SHEET OF
 CITY DRAWING NUMBER
1-0601C-A-S0121-001-0D