


NOTES:
 1. BACKGROUND REVISED FOR CLARITY.

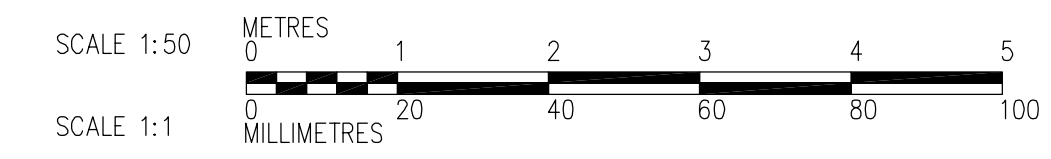

| | | | | | | |
|--|------------------------------------|---|---|---|---|------------------|
| Certificate of Authorization CH2M HILL Canada Ltd. No. 1441 Expiry: April 30, 2006 | B.M. ELEV. | Frederickson Cooper ARCHITECTS | A Tyco International Ltd. Company | ENGINEER'S SEAL ORIGINAL SIGNED BY P. WOBMA 2006/02/06 | THE CITY OF WINNIPEG WATER AND WASTE DEPARTMENT ENGINEERING DIVISION WATER TREATMENT PLANT FILTRATION FOUNDATION AND CONCRETE STRUCTURES PROCESS MECHANICAL PIPE EMBEDS FILTRATION AREA SECTION | CITY FILE NUMBER |
| | DESIGNED BY TB/PW CHECKED BY LS | | | CONSULTANT DRAWING NO. WF-M9201 | | SHEET OF |
| | DRAWN BY TAR/EK APPROVED BY DJT | RELEASED FOR CONSTRUCTION BY: R. SOROKOWSKI DATE 2006/02/08 | CITY DRAWING NUMBER 1-060F-A-M9201-001-01D | | | |
| | SCALE: 1:50 | DATE 2005/08/15 | DATE 2006/02/08 | | | |