


H SECTION
WF-M9103 1:50

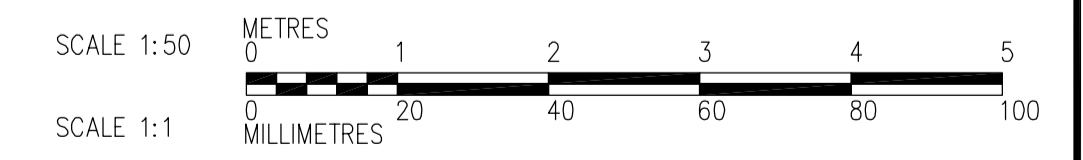

<p>APEGN Certificate of Authorization CH2M HILL Canada Ltd. No. 1441 Expiry: April 30, 2006</p>	<p>Frederickson Cooper ARCHITECTS</p>	<p>EarthTech A Tyco International Ltd. Company</p>	ENGINEER'S SEAL	<p>THE CITY OF WINNIPEG WATER AND WASTE DEPARTMENT ENGINEERING DIVISION</p>																			
			DESIGNED BY: TB/PW		CHECKED BY: LS	ORIGINAL SIGNED BY: P. WOBMA																	
			DRAWN BY: TAR/EK		APPROVED BY: DJT	2006/02/06																	
			SCALE: 1:50		RELEASED FOR CONSTRUCTION BY: R. SOROKOWSKI	CONSULTANT DRAWING NO. WF-M9208																	
<table border="1"> <thead> <tr> <th>NO.</th> <th>REVISIONS</th> <th>DATE</th> <th>BY</th> <th>DATE</th> <th>BY</th> </tr> </thead> <tbody> <tr> <td>01</td> <td>583-2005 ADDENDUM 3</td> <td>06/03/10</td> <td>PW</td> <td></td> <td></td> </tr> <tr> <td>00</td> <td>ISSUED FOR TENDER</td> <td>2006/02/03</td> <td>PW</td> <td></td> <td></td> </tr> </tbody> </table>			NO.	REVISIONS	DATE	BY	DATE	BY	01	583-2005 ADDENDUM 3	06/03/10	PW			00	ISSUED FOR TENDER	2006/02/03	PW			<p>WATER TREATMENT PLANT FILTRATION FOUNDATION AND CONCRETE STRUCTURES</p>		<p>CITY FILE NUMBER</p> <p>SHEET OF</p> <p>CITY DRAWING NUMBER</p> <p>1-060F-A-M9208-001-01D</p>
NO.	REVISIONS	DATE	BY	DATE	BY																		
01	583-2005 ADDENDUM 3	06/03/10	PW																				
00	ISSUED FOR TENDER	2006/02/03	PW																				
<p>B.M. ELEV.</p>			<p>PROCESS MECHANICAL PIPE EMBEDS FILTRATION AREA SECTION</p>																				