
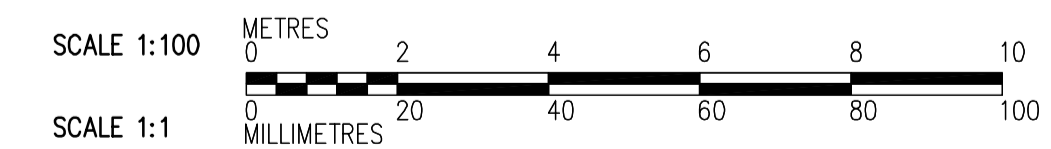
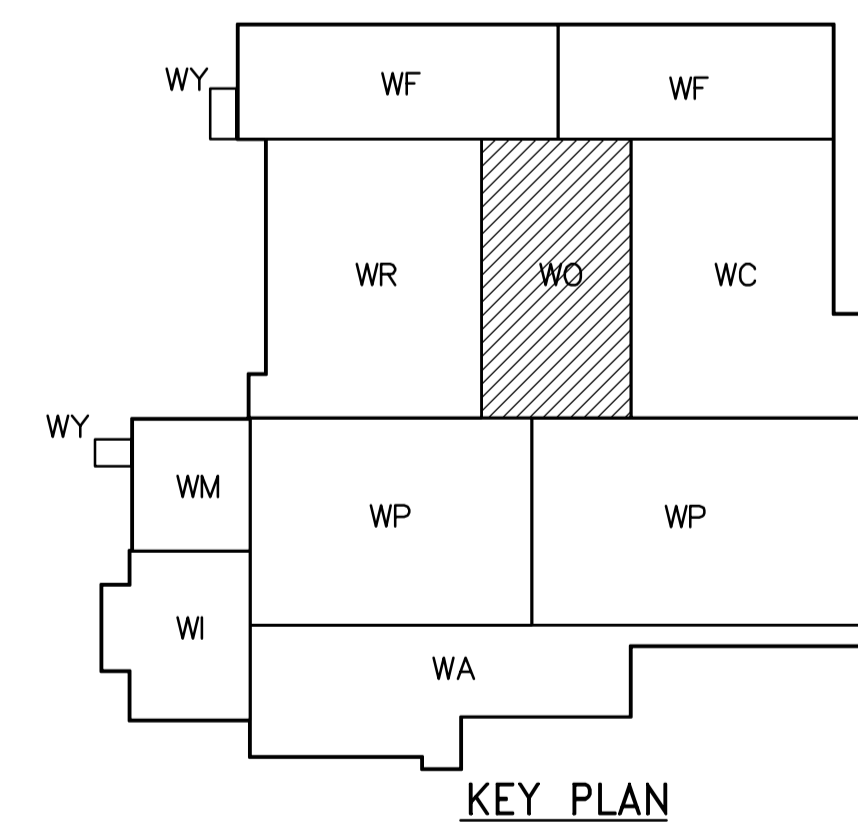


PLAN AT ELEVATION 236.170
1:100

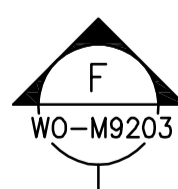

APECA
Certificate of Authorization
CH2M HILL Canada Ltd.
No. 1441 Expiry: April 30, 2006

NO.	REVISIONS	DATE	BY
01	583-2005 ADDENDUM 3	06/03/10	CE
00	ISSUED FOR TENDER	2006/02/03	DP

CH2MHILL
Frederickson Cooper
ARCHITECTS

EarthTech
A Tyco International Ltd. Company

DESIGNED BY	CBE/DP	CHECKED BY	EM
DRAWN BY	EK	APPROVED BY	DJT
SCALE:	1:100	RELEASED FOR CONSTRUCTION BY:	R. SOROKOWSKI
DATE	2005/09/19	DATE	2006/02/08

ENGINEER'S SEAL
ORIGINAL SIGNED BY
D.J. PERNITSKY
2006/02/06
CONSULTANT DRAWING NO.
WO-M9121

THE CITY OF WINNIPEG
WATER AND WASTE DEPARTMENT
ENGINEERING DIVISION

WATER TREATMENT PLANT
OZONE
FOUNDATIONS AND CONCRETE STRUCTURES

PROCESS MECHANICAL
PIPE EMBEDS
OZONE CONTACTORS UPPER PLAN

CITY FILE NUMBER
SHEET OF
CITY DRAWING NUMBER
1-06010-A-M9121-001-01D