


INSTRUMENT LOOP DIAGRAM

LOOP NO. W695

PROCESS AREA

SYSTEM MARSHALLING PANEL

D.C.S. - PCU 26

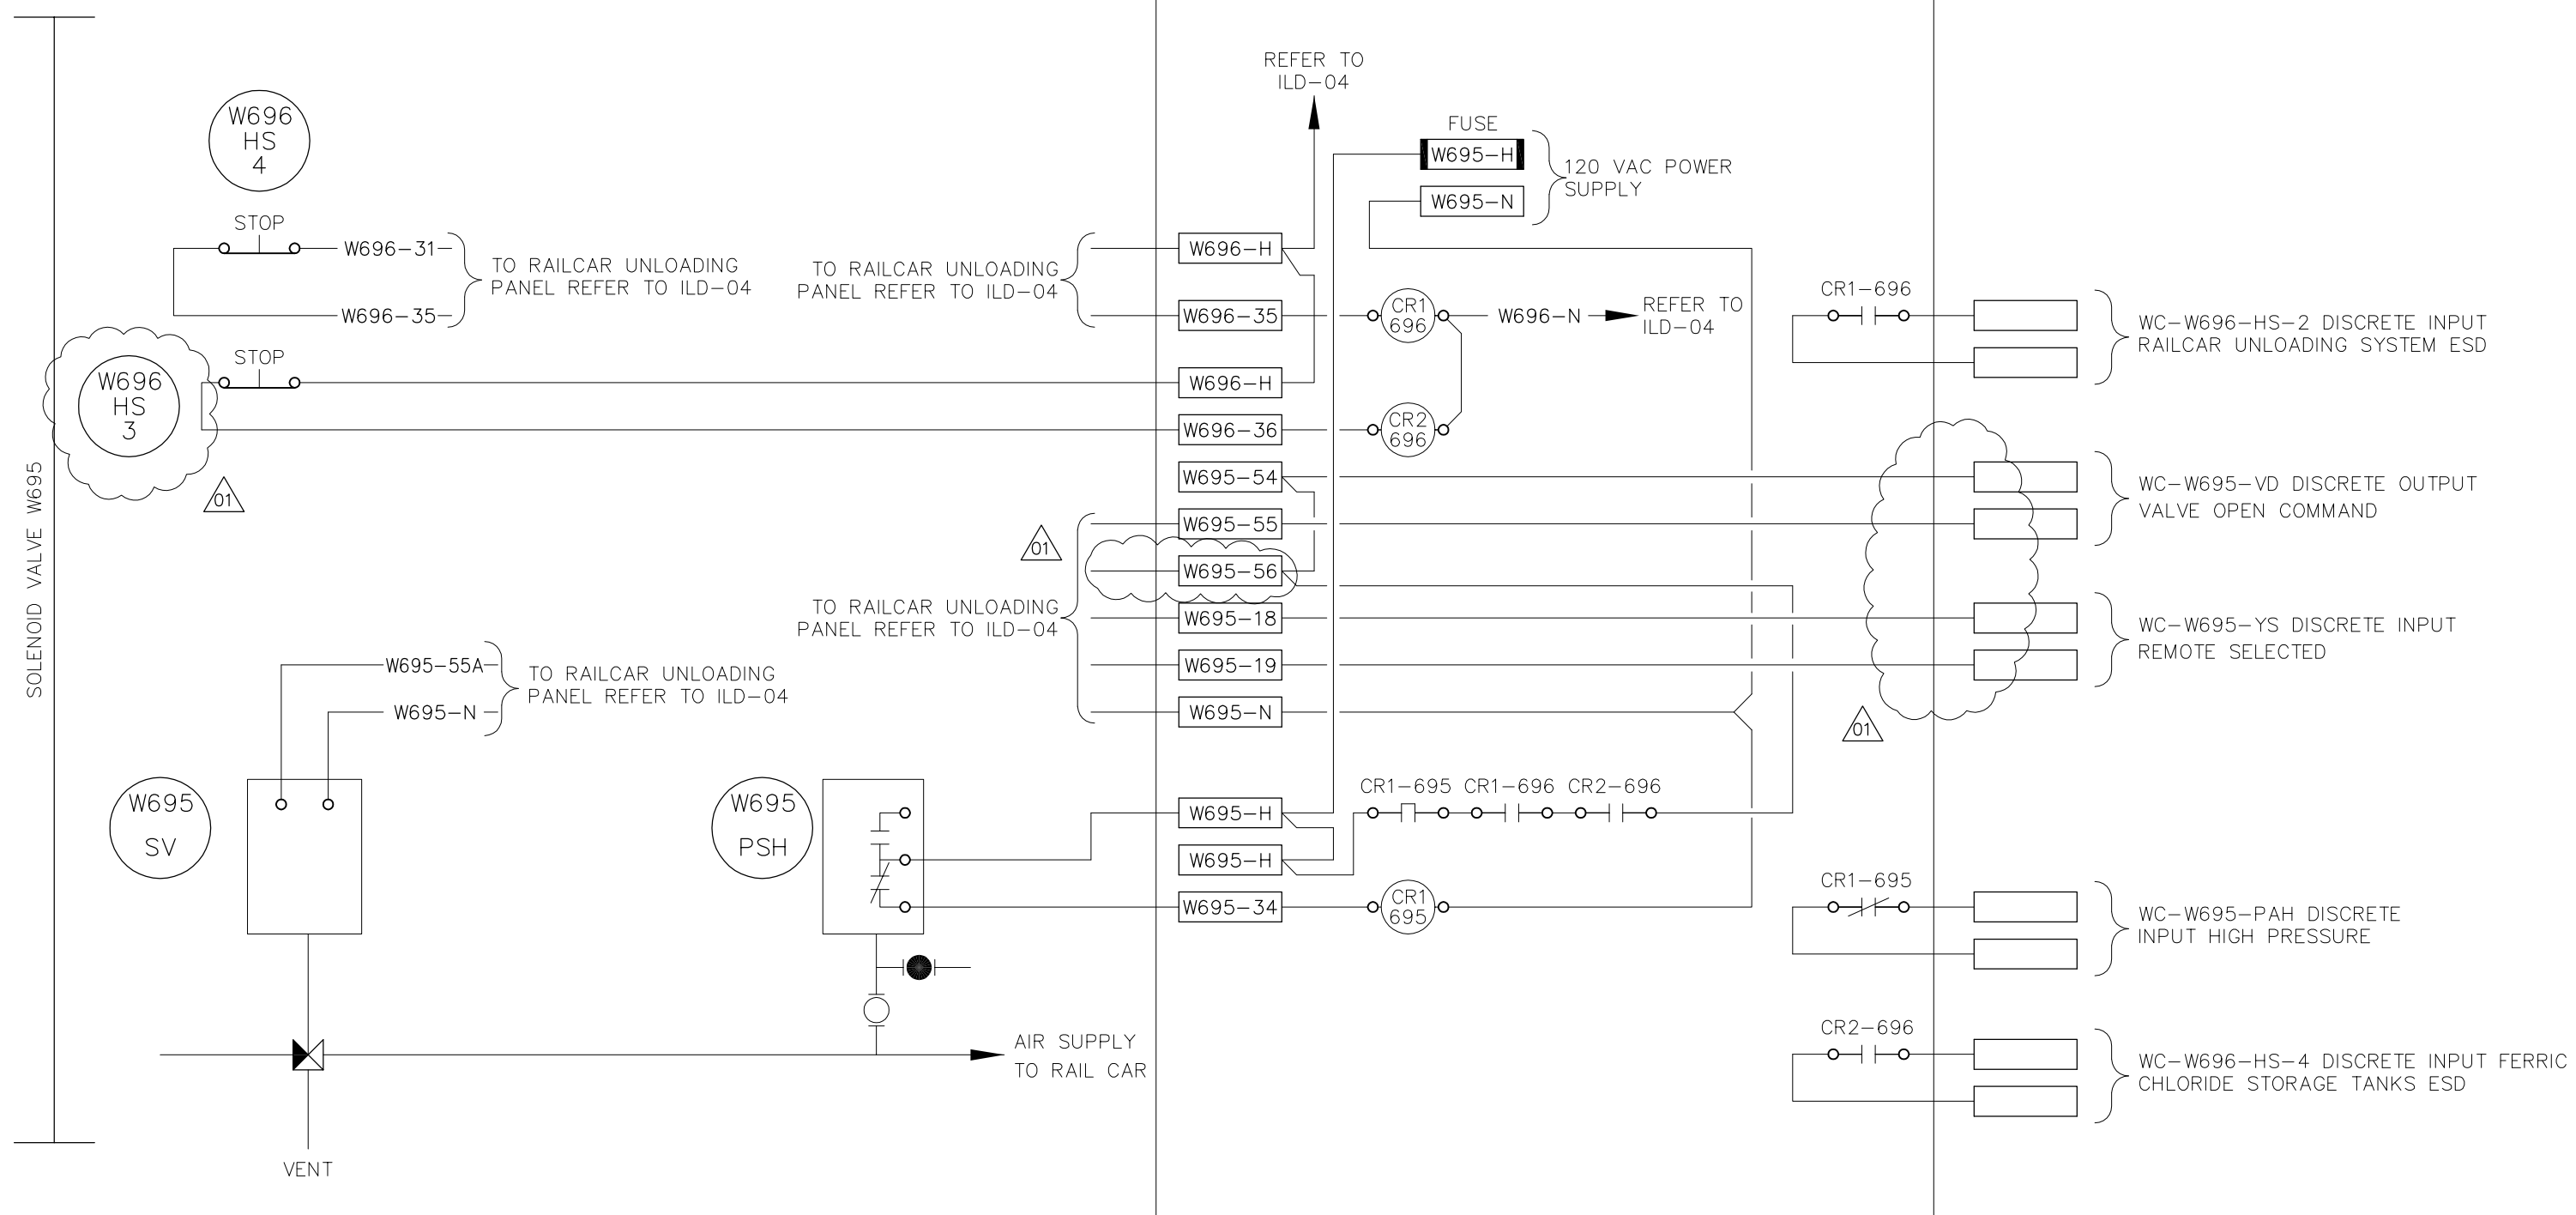

NOTE:
1) STOP BUTTON SHALL BE MAINTAINED. PUSH-PULL TYPE

01



Earth Tech (Canada) Inc. Winnipeg, Manitoba 204.477.5381

DATE	REVISION	APP.
06/01/06	611-2005 ADDENDUM 1	ST
05/12/08	ISSUED FOR TENDER	ST



THE CITY OF WINNIPEG
WATER AND WASTE DEPARTMENT

NEWPCC - CENTRATE NUTRIENT TREATMENT
PHOSPHORUS REMOVAL FACILITY

INSTRUMENT LOOP DIAGRAM
RAIL CAR UNLOADING SOLENOID VALVE

SCALE AS NOTED
DATE 05 10 18
DES DWN
CKD APP

DRAWING NO.
ILD-05