


SHEET: CWP-41-WW (11/2005)

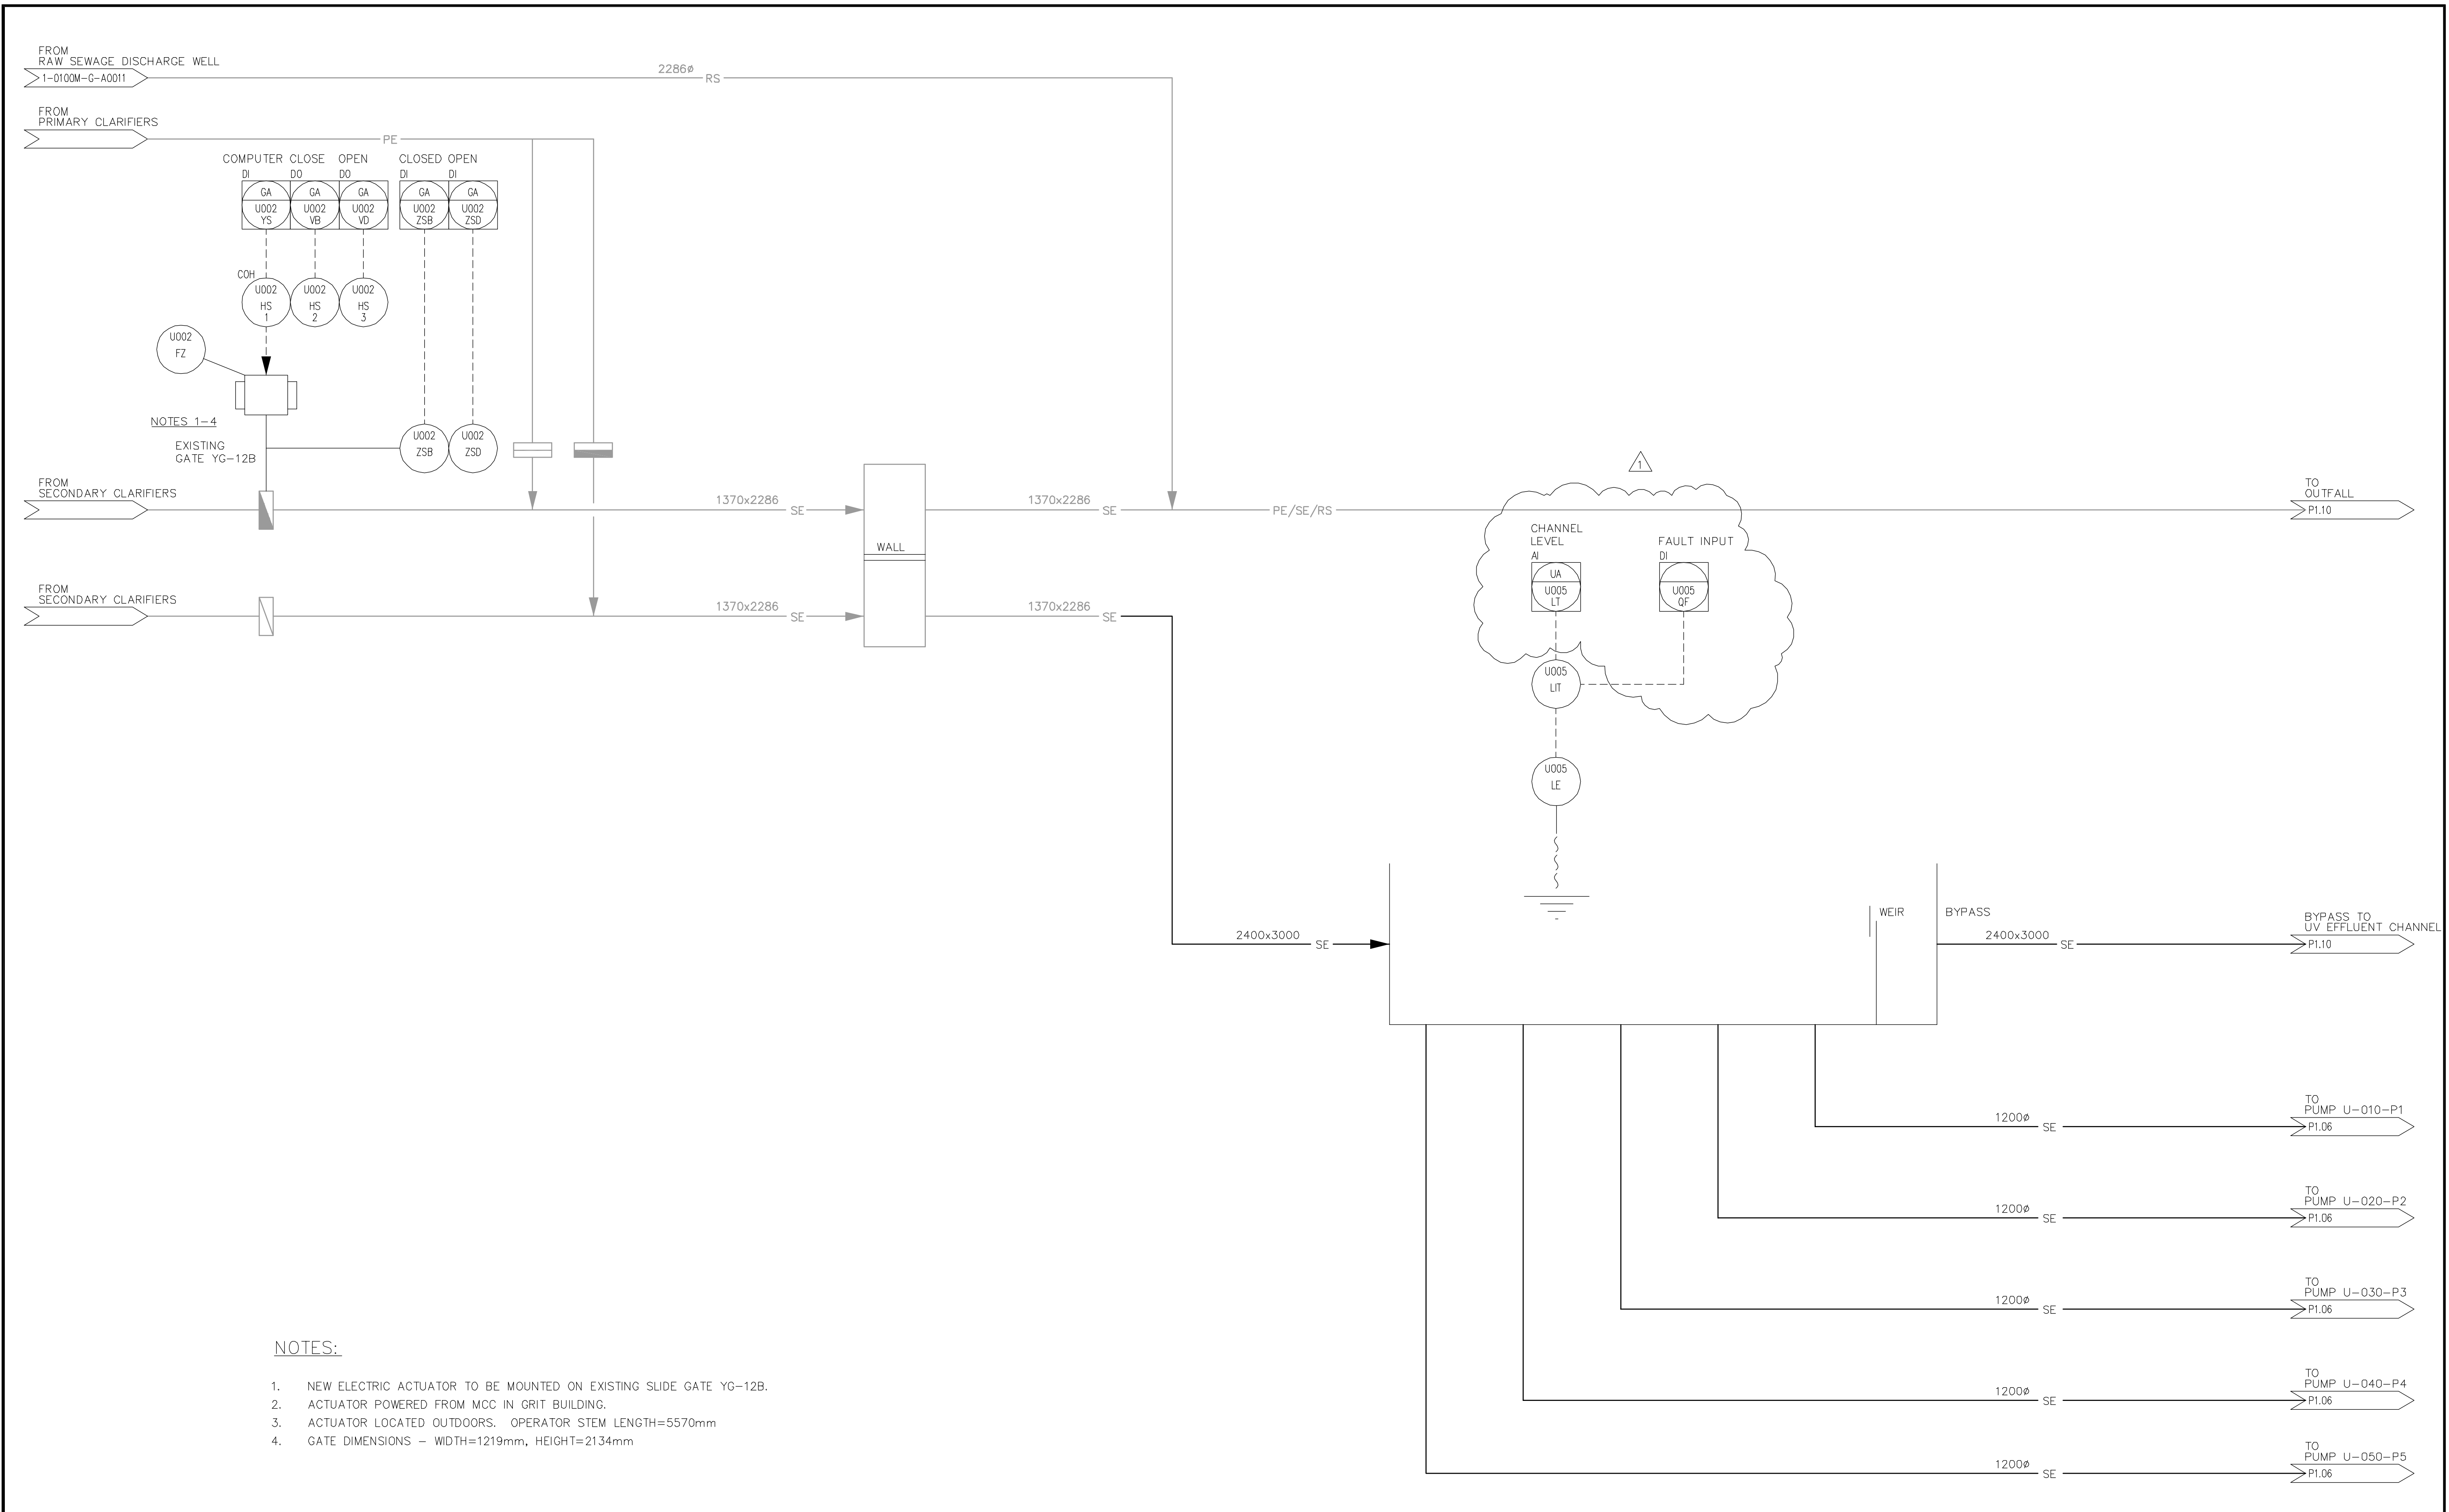

- NOTES:**
1. NEW ELECTRIC ACTUATOR TO BE MOUNTED ON EXISTING SLIDE GATE YG-12B.
 2. ACTUATOR POWERED FROM MCC IN GRIT BUILDING.
 3. ACTUATOR LOCATED OUTDOORS. OPERATOR STEM LENGTH=5570mm
 4. GATE DIMENSIONS - WIDTH=1219mm, HEIGHT=2134mm



B.M. ELEV.		EARTH TECH	
Earth Tech (Canada) Inc. Winnipeg, Manitoba 204-477-2081		ENGINEER'S SEAL	
DESIGNED BY: CGL	CHECKED BY: DT	ORIGINAL SIGNED BY: D.J. TANIGUCHI	
DRAWN BY: KJW	APPROVED BY: DT	FEB. 18/05	
HOR. SCALE:		RELEASED FOR CONSTRUCTION BY: T. KJARTANSON	
VERTICAL SCALE:		CONSULTANT DRAWING NO. 66303D-CP1.04	
1 ISSUED FOR ADDENDUM 1 05/03/11 ERC	2 ISSUED FOR TENDER 05/02/18 JEH	DATE 2004/11/03 DATE 2005-02-18	

THE CITY OF WINNIPEG
Winnipeg WATER AND WASTE DEPARTMENT

NEWPCC - SECONDARY EFFLUENT UV DISINFECTION FACILITY

PROCESS: UV PUMP INFLUENT WETWELL/CHANNEL

CITY FILE NUMBER: _____
 SHEET # OF #S: _____
 CITY DRAWING NUMBER: _____