


SHEET: CWP-11-WW (17/2005)

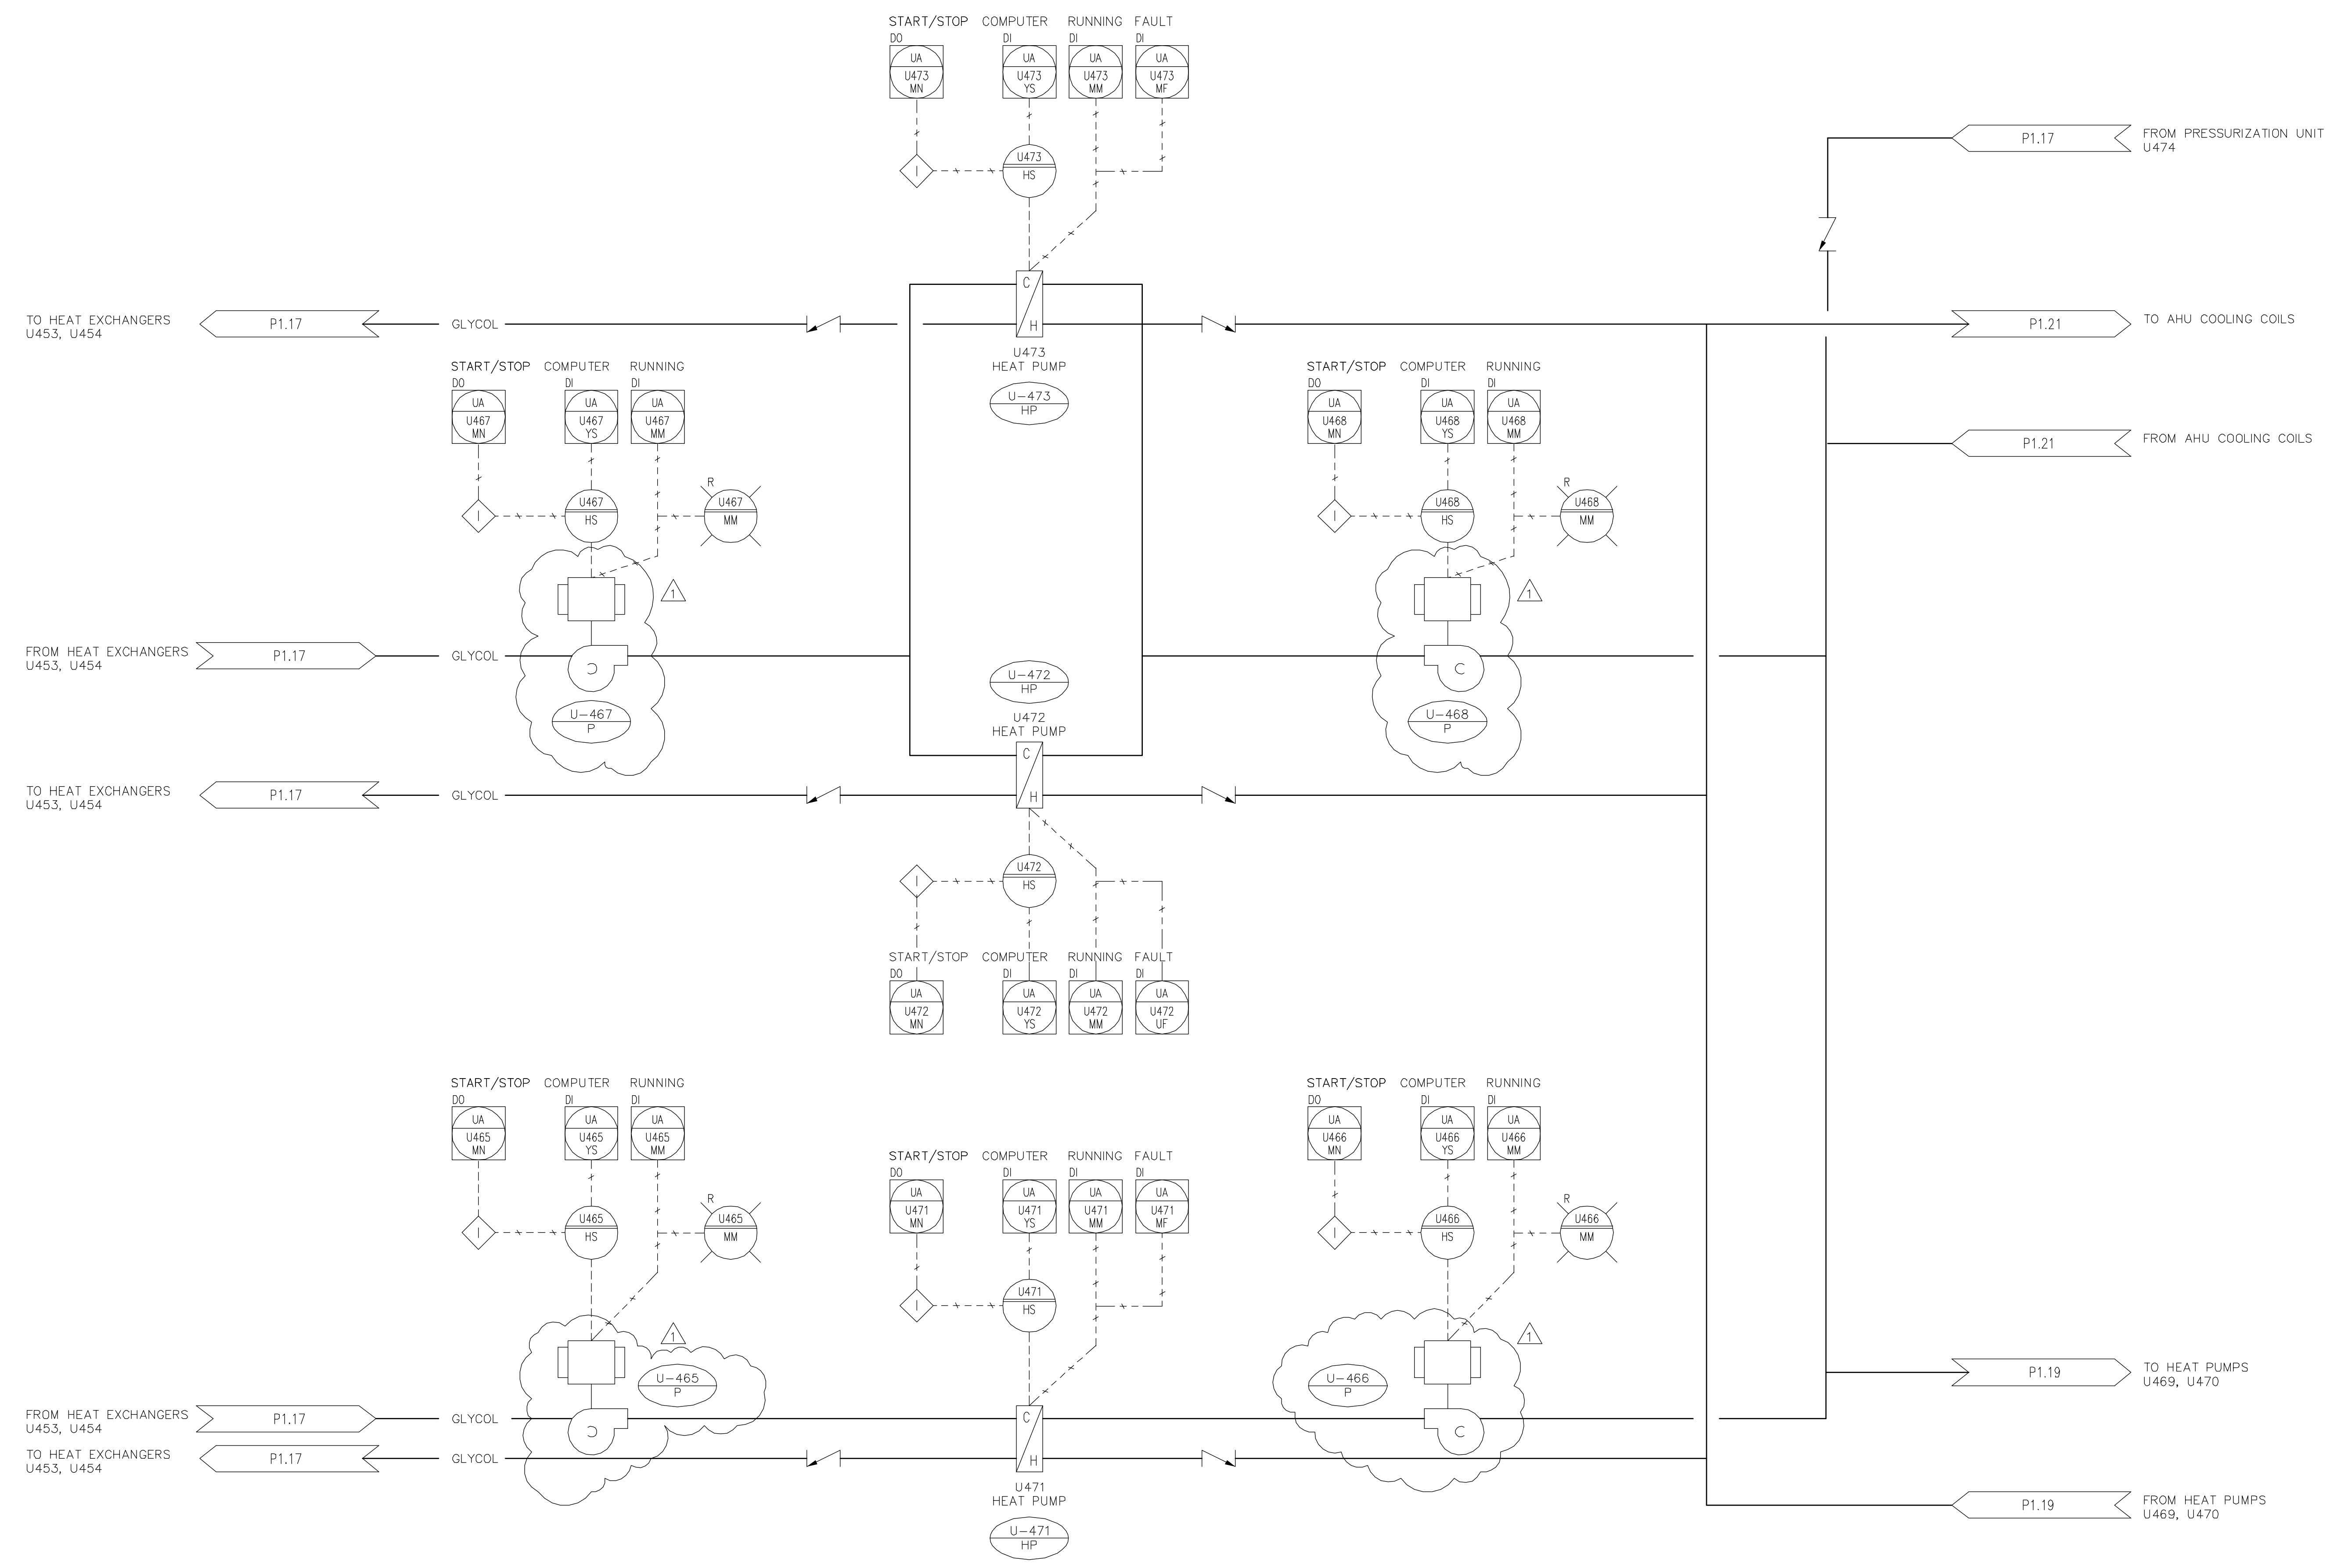

NO.	REVISIONS	DATE	BY
1	ISSUED FOR ADDENDUM 1	05/03/11	ERC
0	ISSUED FOR TENDER	05/02/18	JEH

DESIGNED BY: NT		CHECKED BY: PL	
DRAWN BY: ERC		APPROVED BY: DT	
HOR. SCALE:		RELEASED FOR CONSTRUCTION BY: T. KJAR TANSON	
VERTICAL SCALE:		DATE: 2005-02-15	
		DATE: 2005-02-18	

ENGINEER'S SEAL
 ORIGINAL SIGNED BY
 P.V. LAITINEN
 FEB. 18/05
 CONSULTANT DRAWING NO.
 66303D-CP1.18

THE CITY OF WINNIPEG
 Winnipeg WATER AND WASTE DEPARTMENT

**NEWPCC - SECONDARY EFFLUENT
 UV DISINFECTION FACILITY**

PROCESS
 U471, U472, U473 HEAT PUMPS

CITY FILE NUMBER	
SHEET # OF #S	
CITY DRAWING NUMBER	