


ALUMINUM LADDER DETAIL
SCALE N.T.S.

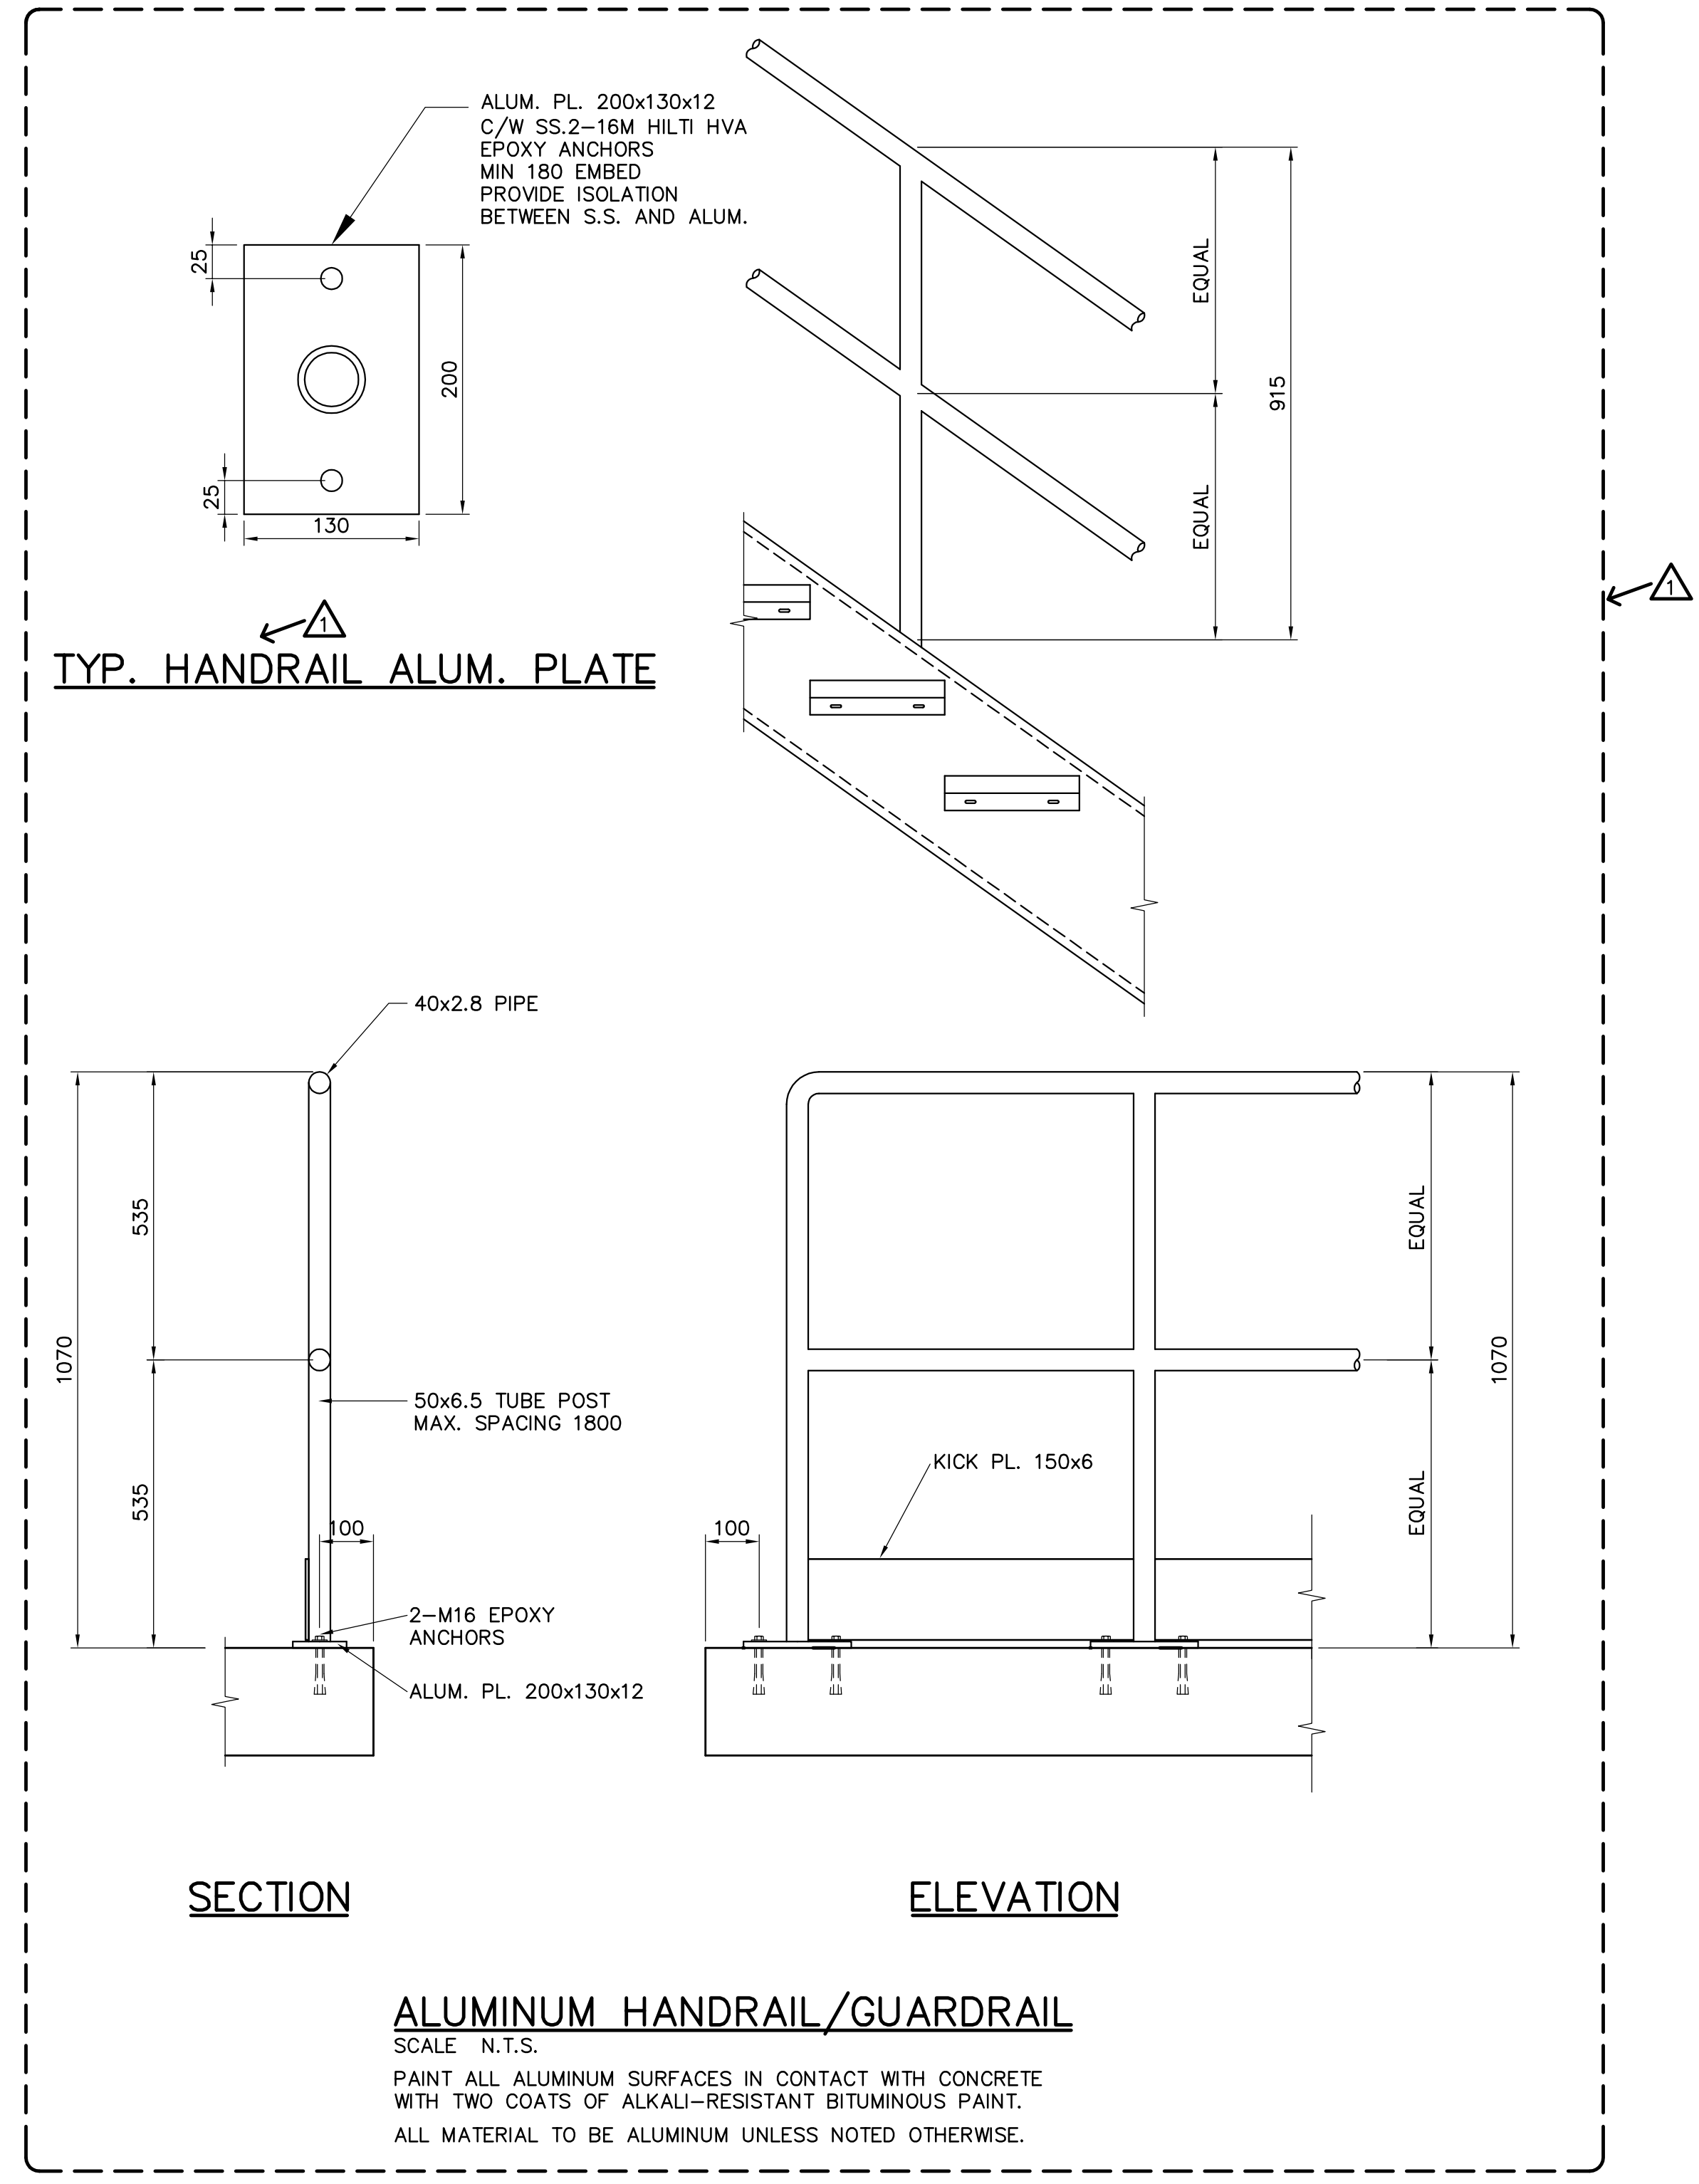

ALUMINUM HANDRAIL/GUARDRAIL
SCALE N.T.S.
PAINT ALL ALUMINUM SURFACES IN CONTACT WITH CONCRETE WITH TWO COATS OF ALKALI-RESISTANT BITUMINOUS PAINT.
ALL MATERIAL TO BE ALUMINUM UNLESS NOTED OTHERWISE.



B.M. ELEV.			
1	ISSUED FOR ADDENDUM 1	05/03/04	JEH
0	ISSUED FOR TENDER	05/02/18	JEH
NO.	REVISIONS	DATE	BY

EARTH TECH			
<small>Earth Tech (Canada) Inc. Winnipeg, Manitoba 204.477.5381</small>			
DESIGNED BY	RE, MK	CHECKED BY	GGP
DRAWN BY	C.T.	APPROVED BY	DT
HOR. SCALE: AS NOTED		RELEASED FOR CONSTRUCTION BY: T. KJARTANSON	
VERTICAL SCALE: AS NOTED		DATE 2005-02-18	
DATE 2004/11/04		DATE 2005-02-18	

ENGINEER'S SEAL
ORIGINAL SIGNED BY
R.B. ERIC
FEB. 18/05
CONSULTANT DRAWING NO.
66303D-CS4.03

THE CITY OF WINNIPEG
Winnipeg WATER AND WASTE DEPARTMENT

**NEWPCC - SECONDARY EFFLUENT
UV DISINFECTION FACILITY**

STRUCTURAL DETAILS

CITY FILE NUMBER
SHEET 11 OF 19
CITY DRAWING NUMBER