

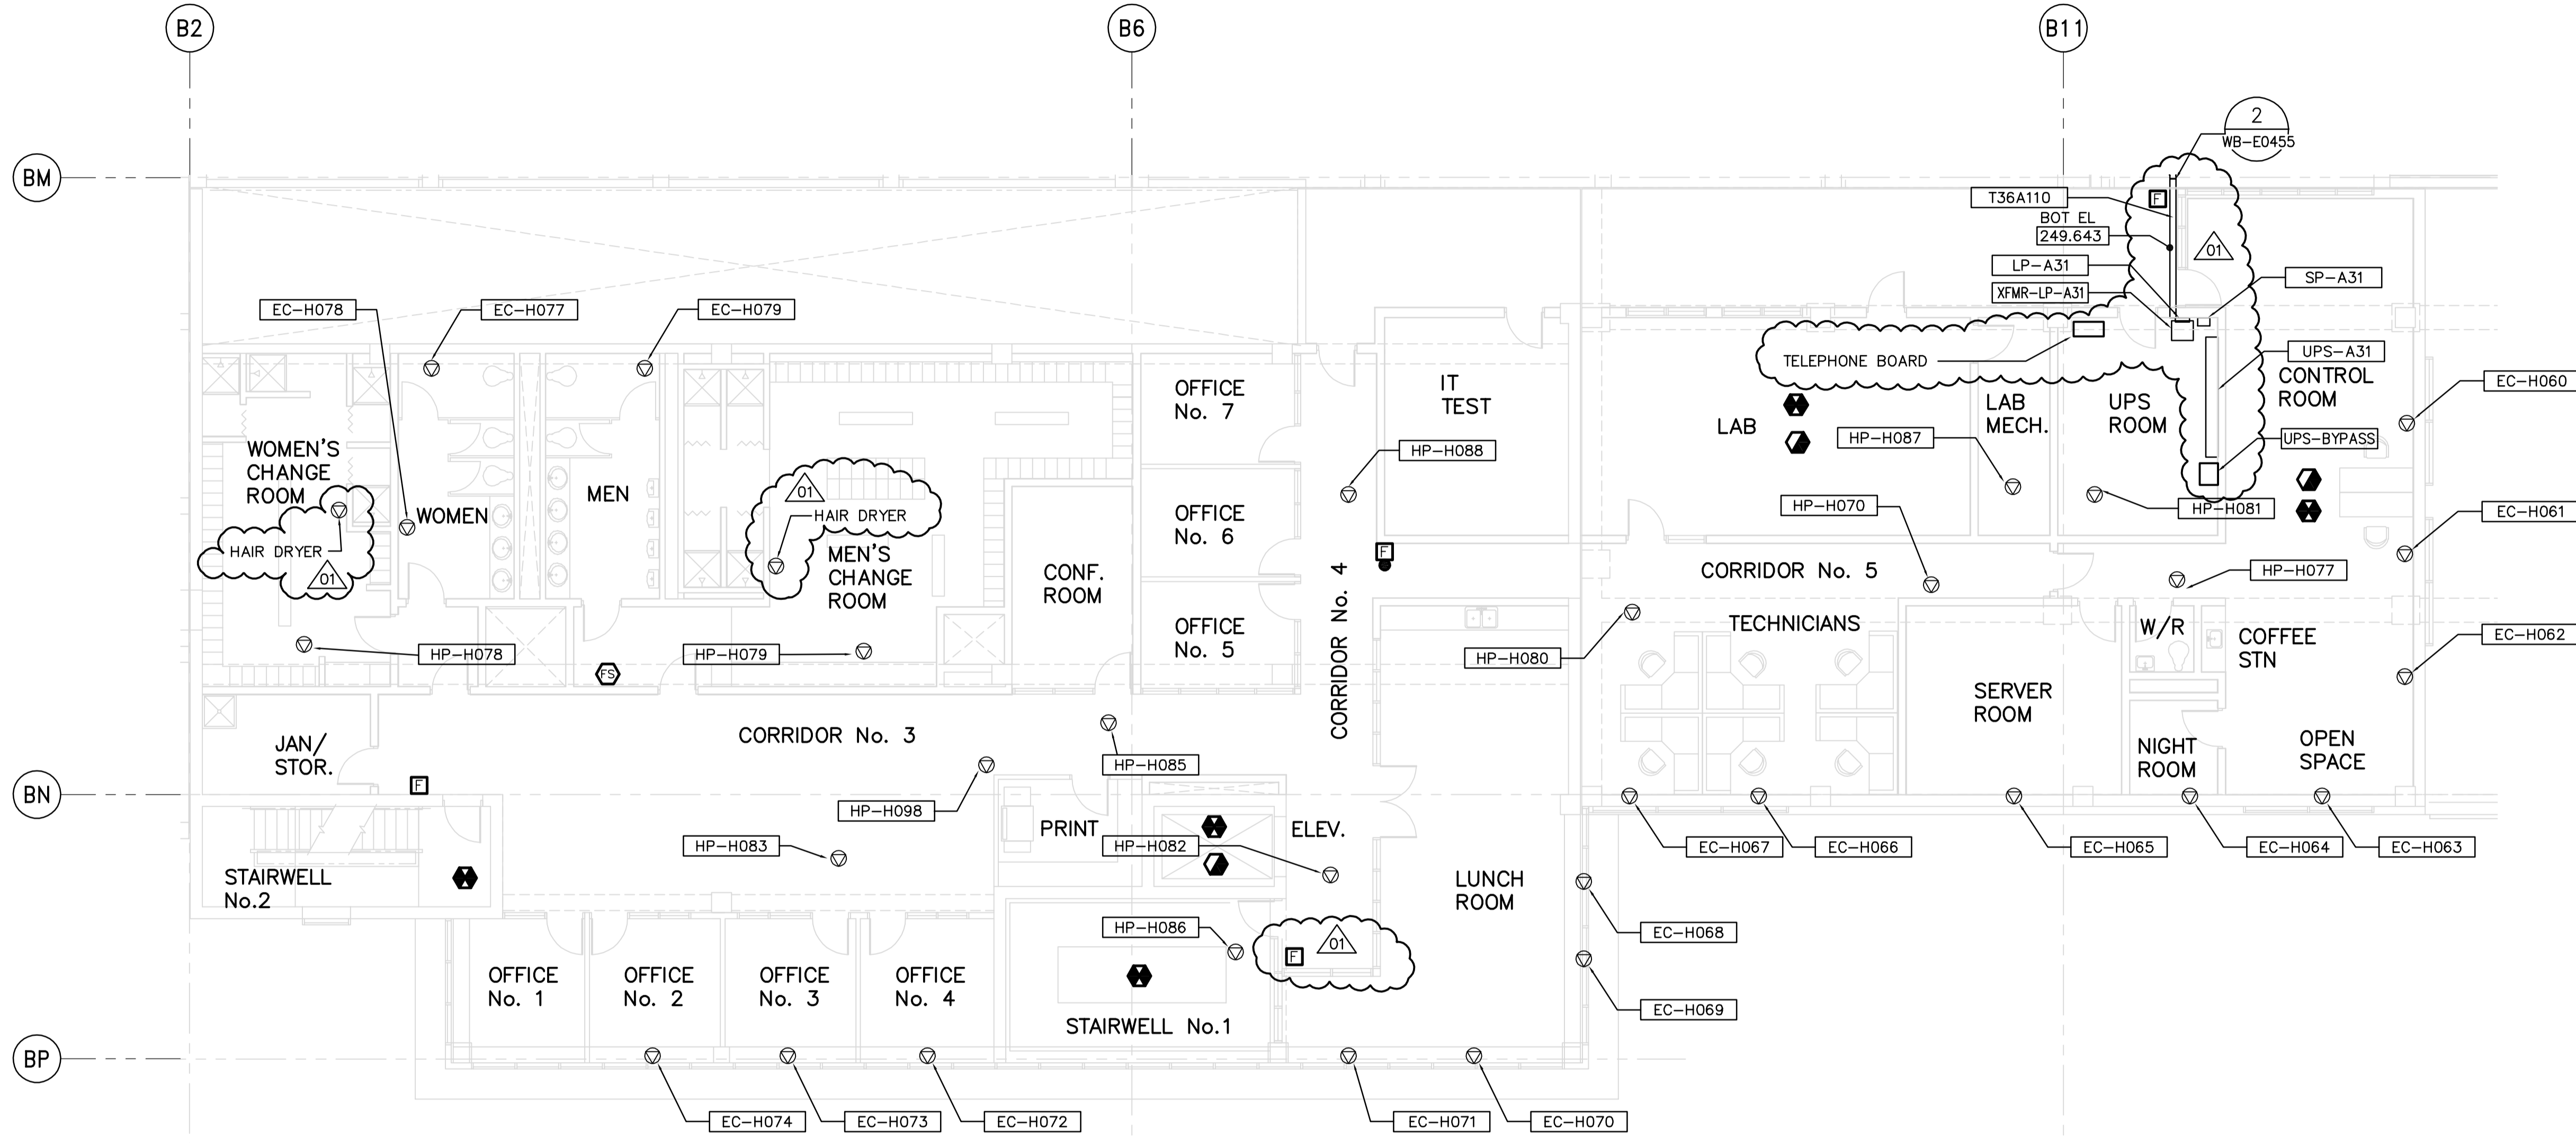


- NOTES:**
1. PROVIDE STAIRWELL SMOKE DETECTORS AS SHOWN ON FIRE PROTECTION DRAWINGS.
 2. ALL 120V AND 208V LOADS ARE FED FROM LP-A31.

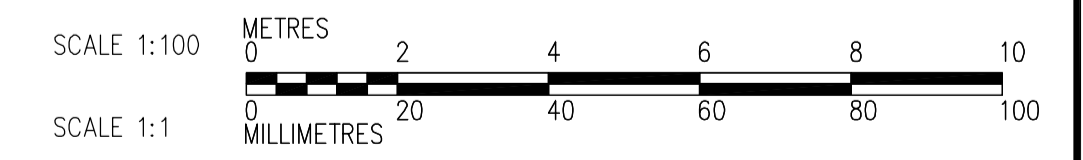

CABLE TRAY TAGGING
SEE DEATL
3
WB-E0455

THIRD FLOOR FACILITY PLAN
1:100

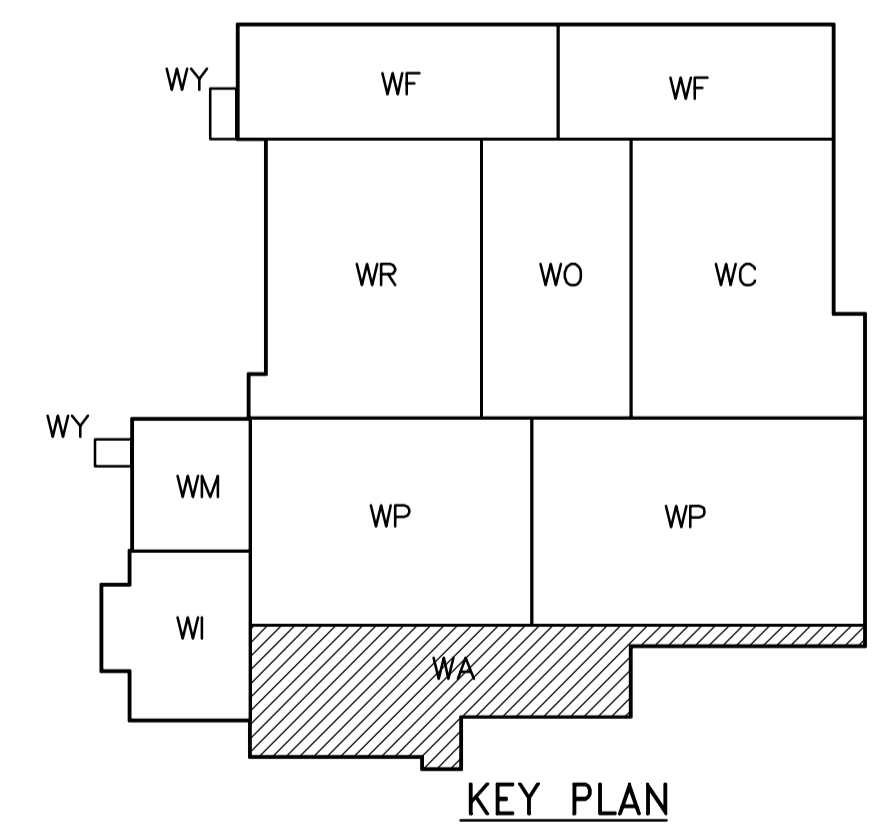

| | | | | | |
|--|---|---|---|--|--|
| <p>APEGN Certificate of Authorization CH2M HILL Canada Ltd. No. 1441 Expiry: April 30, 2007</p> | <p>Frederickson Cooper ARCHITECTS</p> | <p>A 300 International Ltd. Company</p> | ENGINEER'S SEAL ORIGINAL SIGNED BY L.D. LLEWELLYN 2006/03/29 | <p>THE CITY OF WINNIPEG WATER AND WASTE DEPARTMENT ENGINEERING DIVISION</p> | |
| | | | DESIGNED BY: LL CHECKED BY: ND DRAWN BY: TL APPROVED BY: AHL SCALE: 1:100 RELEASED FOR CONSTRUCTION BY: R. SOROKOWSKI CONSULTANT DRAWING NO. WA-E0131 | | WATER TREATMENT PLANT ADMINISTRATION MECHANICAL AND ELECTRICAL CITY FILE NUMBER SHEET OF ELECTRICAL ADMINISTRATION AREA THIRD FLOOR FACILITY PLAN CITY DRAWING NUMBER 1-0601A-A-E0131-001-01D |
| B.M. ELEV. | | NO. REVISIONS DATE BY DATE 2005/08/18 DATE 2006/03/29 | | | |