
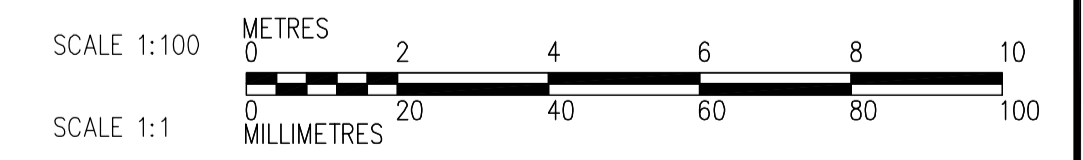


NOTES:

1. PROVIDE STAIRWELL SMOKE DETECTORS AS SHOWN ON FIRE PROTECTION DRAWINGS.
2. SEE MCC 4A & 4B AND PANEL SCHEDULE DP-H31 & DP-H32 FOR 600V DISTRIBUTION.
3. SEE DRAWING WB-E0401 FOR CABLE TRAY MOUNTING DETAILS.

FOR CABLE TRAY TAGGING SEE DETAIL 3 WB-E0455

THIRD FLOOR FACILITY PLAN
1:100

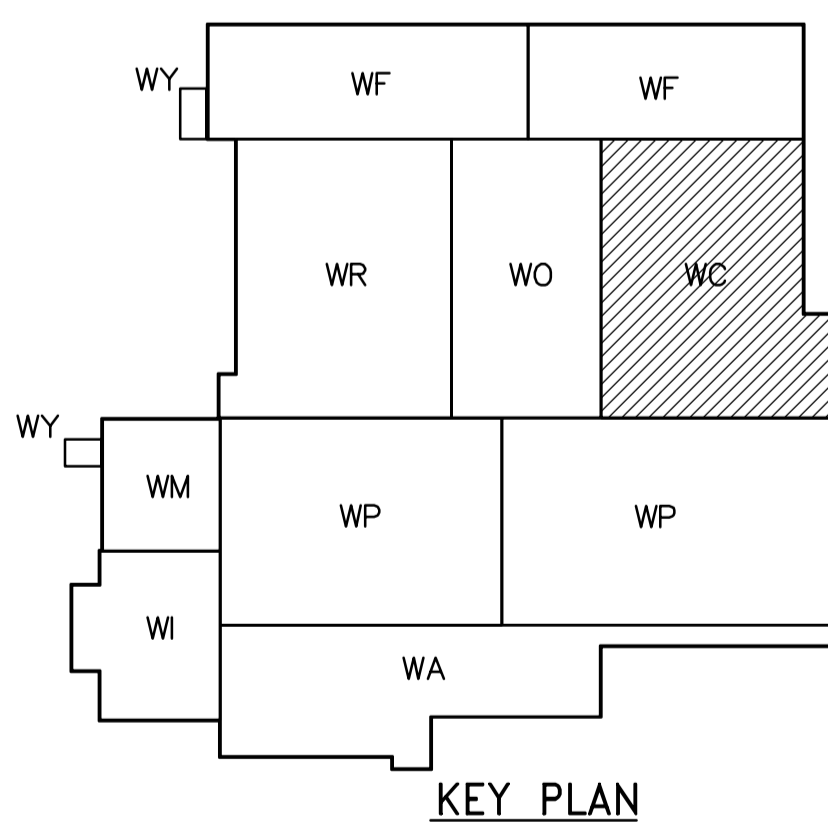

B.M.	ELEV.	DATE	BY
01	742-2005 ADDENDUM 3	06/05/05	LL
00	ISSUED FOR TENDER	06/03/29	LL
NO.	REVISIONS	DATE	BY

CH2MHILL Frederickson Cooper ARCHITECTS		EarthTech A Tyco International Ltd. Company	
DESIGNED BY	LL	CHECKED BY	ND
DRAWN BY	TL	APPROVED BY	AHL
SCALE:	1:100	RELEASED FOR CONSTRUCTION BY:	R. SOROKOWSKI
DATE	2005/07/08	DATE	2006/03/29

ENGINEER'S SEAL
ORIGINAL SIGNED BY
L.D. LLEWELLYN
2006/03/29
CONSULTANT DRAWING NO.
WC-E0131

THE CITY OF WINNIPEG
WATER AND WASTE DEPARTMENT
ENGINEERING DIVISION

WATER TREATMENT PLANT
CHEMICAL FEED SYSTEMS
MECHANICAL AND ELECTRICAL

ELECTRICAL
CHEMICAL AREA
THIRD FLOOR FACILITY PLAN

CITY FILE NUMBER
SHEET OF
CITY DRAWING NUMBER
1-0601C-A-E0131-001-01D