


A STAIRWELL NO.7 LIGHTING
 WC-E0113 1:50
 WC-E0123
 WC-E0133

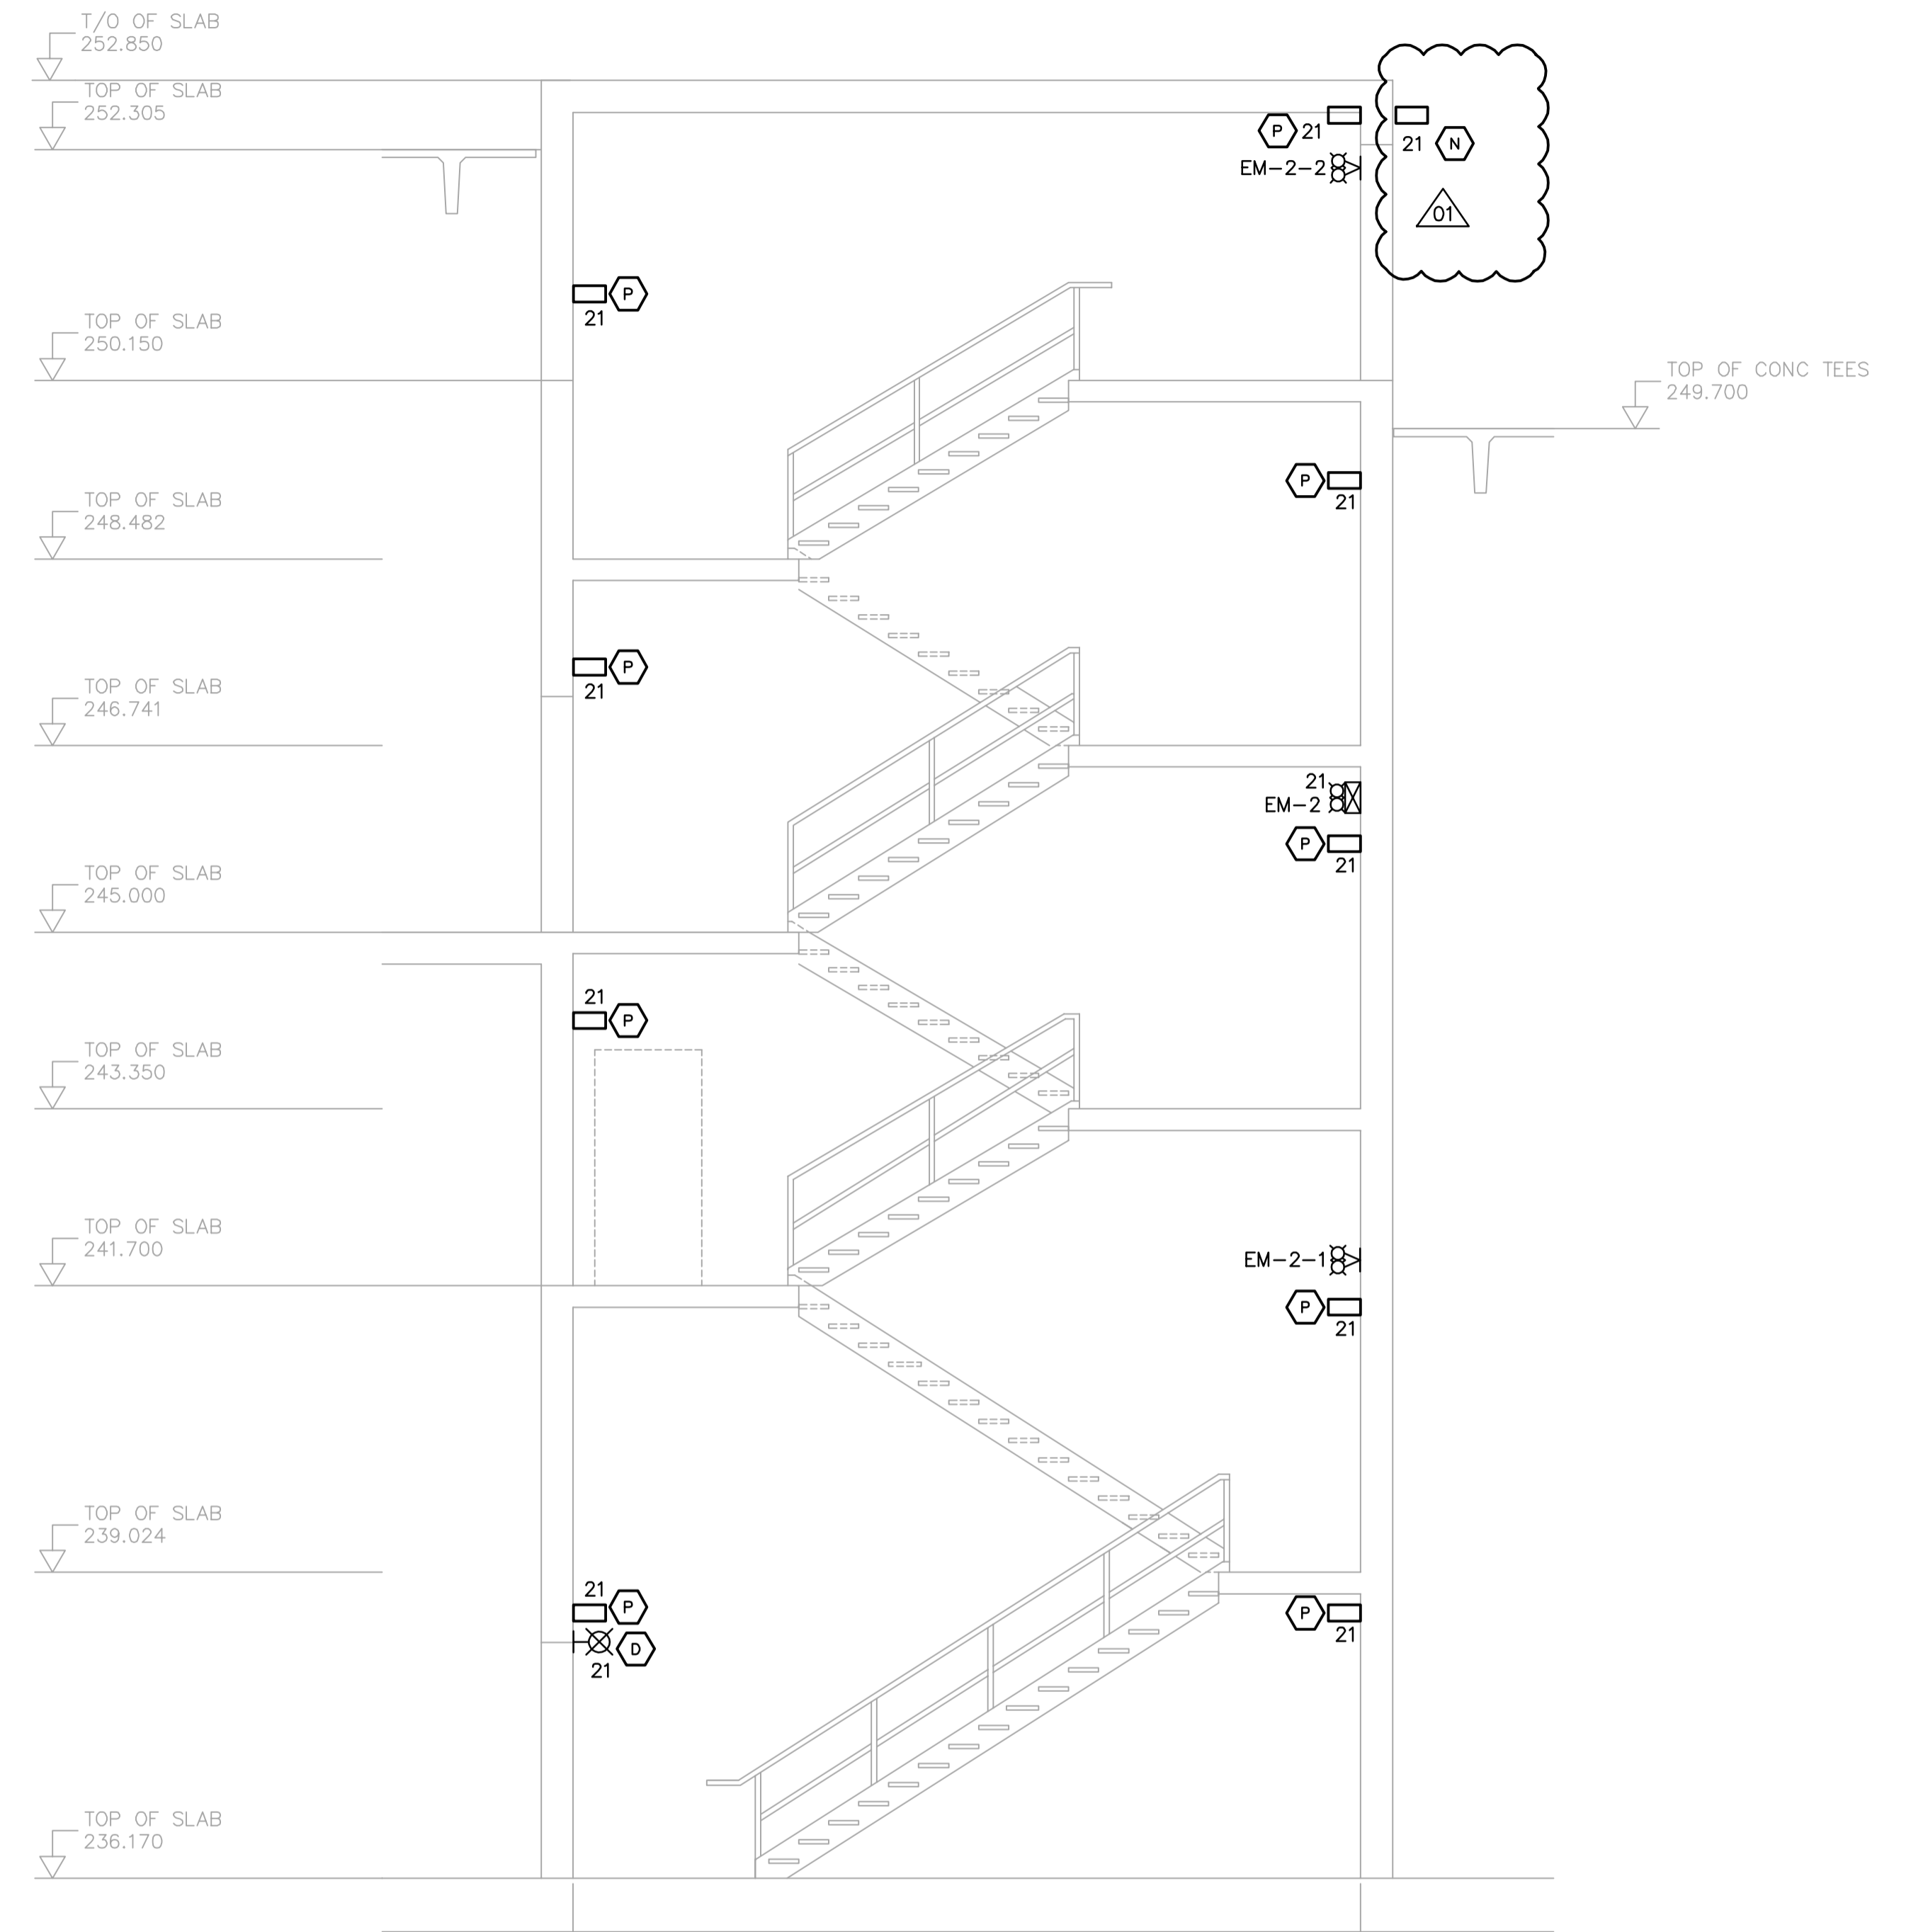

B STAIRWELL NO.8 LIGHTING
 WC-E0113 1:50
 WC-E0123
 WC-E0133
 WC-E0147

NOTES

1. LUMINAIRES ARE FED FROM LP-C11.
2. EMERGENCY LIGHTING EM-X-1, -2 ETC ARE FED FROM BATTERY PACK EM-X.

 Certificate of Authorization CH2M HILL Canada Ltd. No. 1441 Expiry: April 30, 2007	 Frederickson Cooper ARCHITECTS	 A Yoo International Ltd. Company	ENGINEER'S SEAL ORIGINAL SIGNED BY L.D. LLEWELLYN 2006/03/29	 THE CITY OF WINNIPEG WATER AND WASTE DEPARTMENT ENGINEERING DIVISION	
	DESIGNED BY: JT CHECKED BY: ND DRAWN BY: KJ APPROVED BY: AHL	SCALE: 1:50 RELEASED FOR CONSTRUCTION BY: R. SOROKOWSKI	CONSULTANT DRAWING NO. WC-E0201	WATER TREATMENT PLANT CHEMICAL FEED SYSTEMS MECHANICAL AND ELECTRICAL	CITY FILE NUMBER SHEET OF
	NO. REVISIONS DATE BY	DATE 2005/08/03 DATE 2006/03/29	ELECTRICAL CHEMICAL AREA STAIR LIGHTING	CITY DRAWING NUMBER 1-0601C-A-E0201-001-01D	
			ELECTRICAL CHEMICAL AREA STAIR LIGHTING		