



3 DETAIL
WC-M9111 1:50

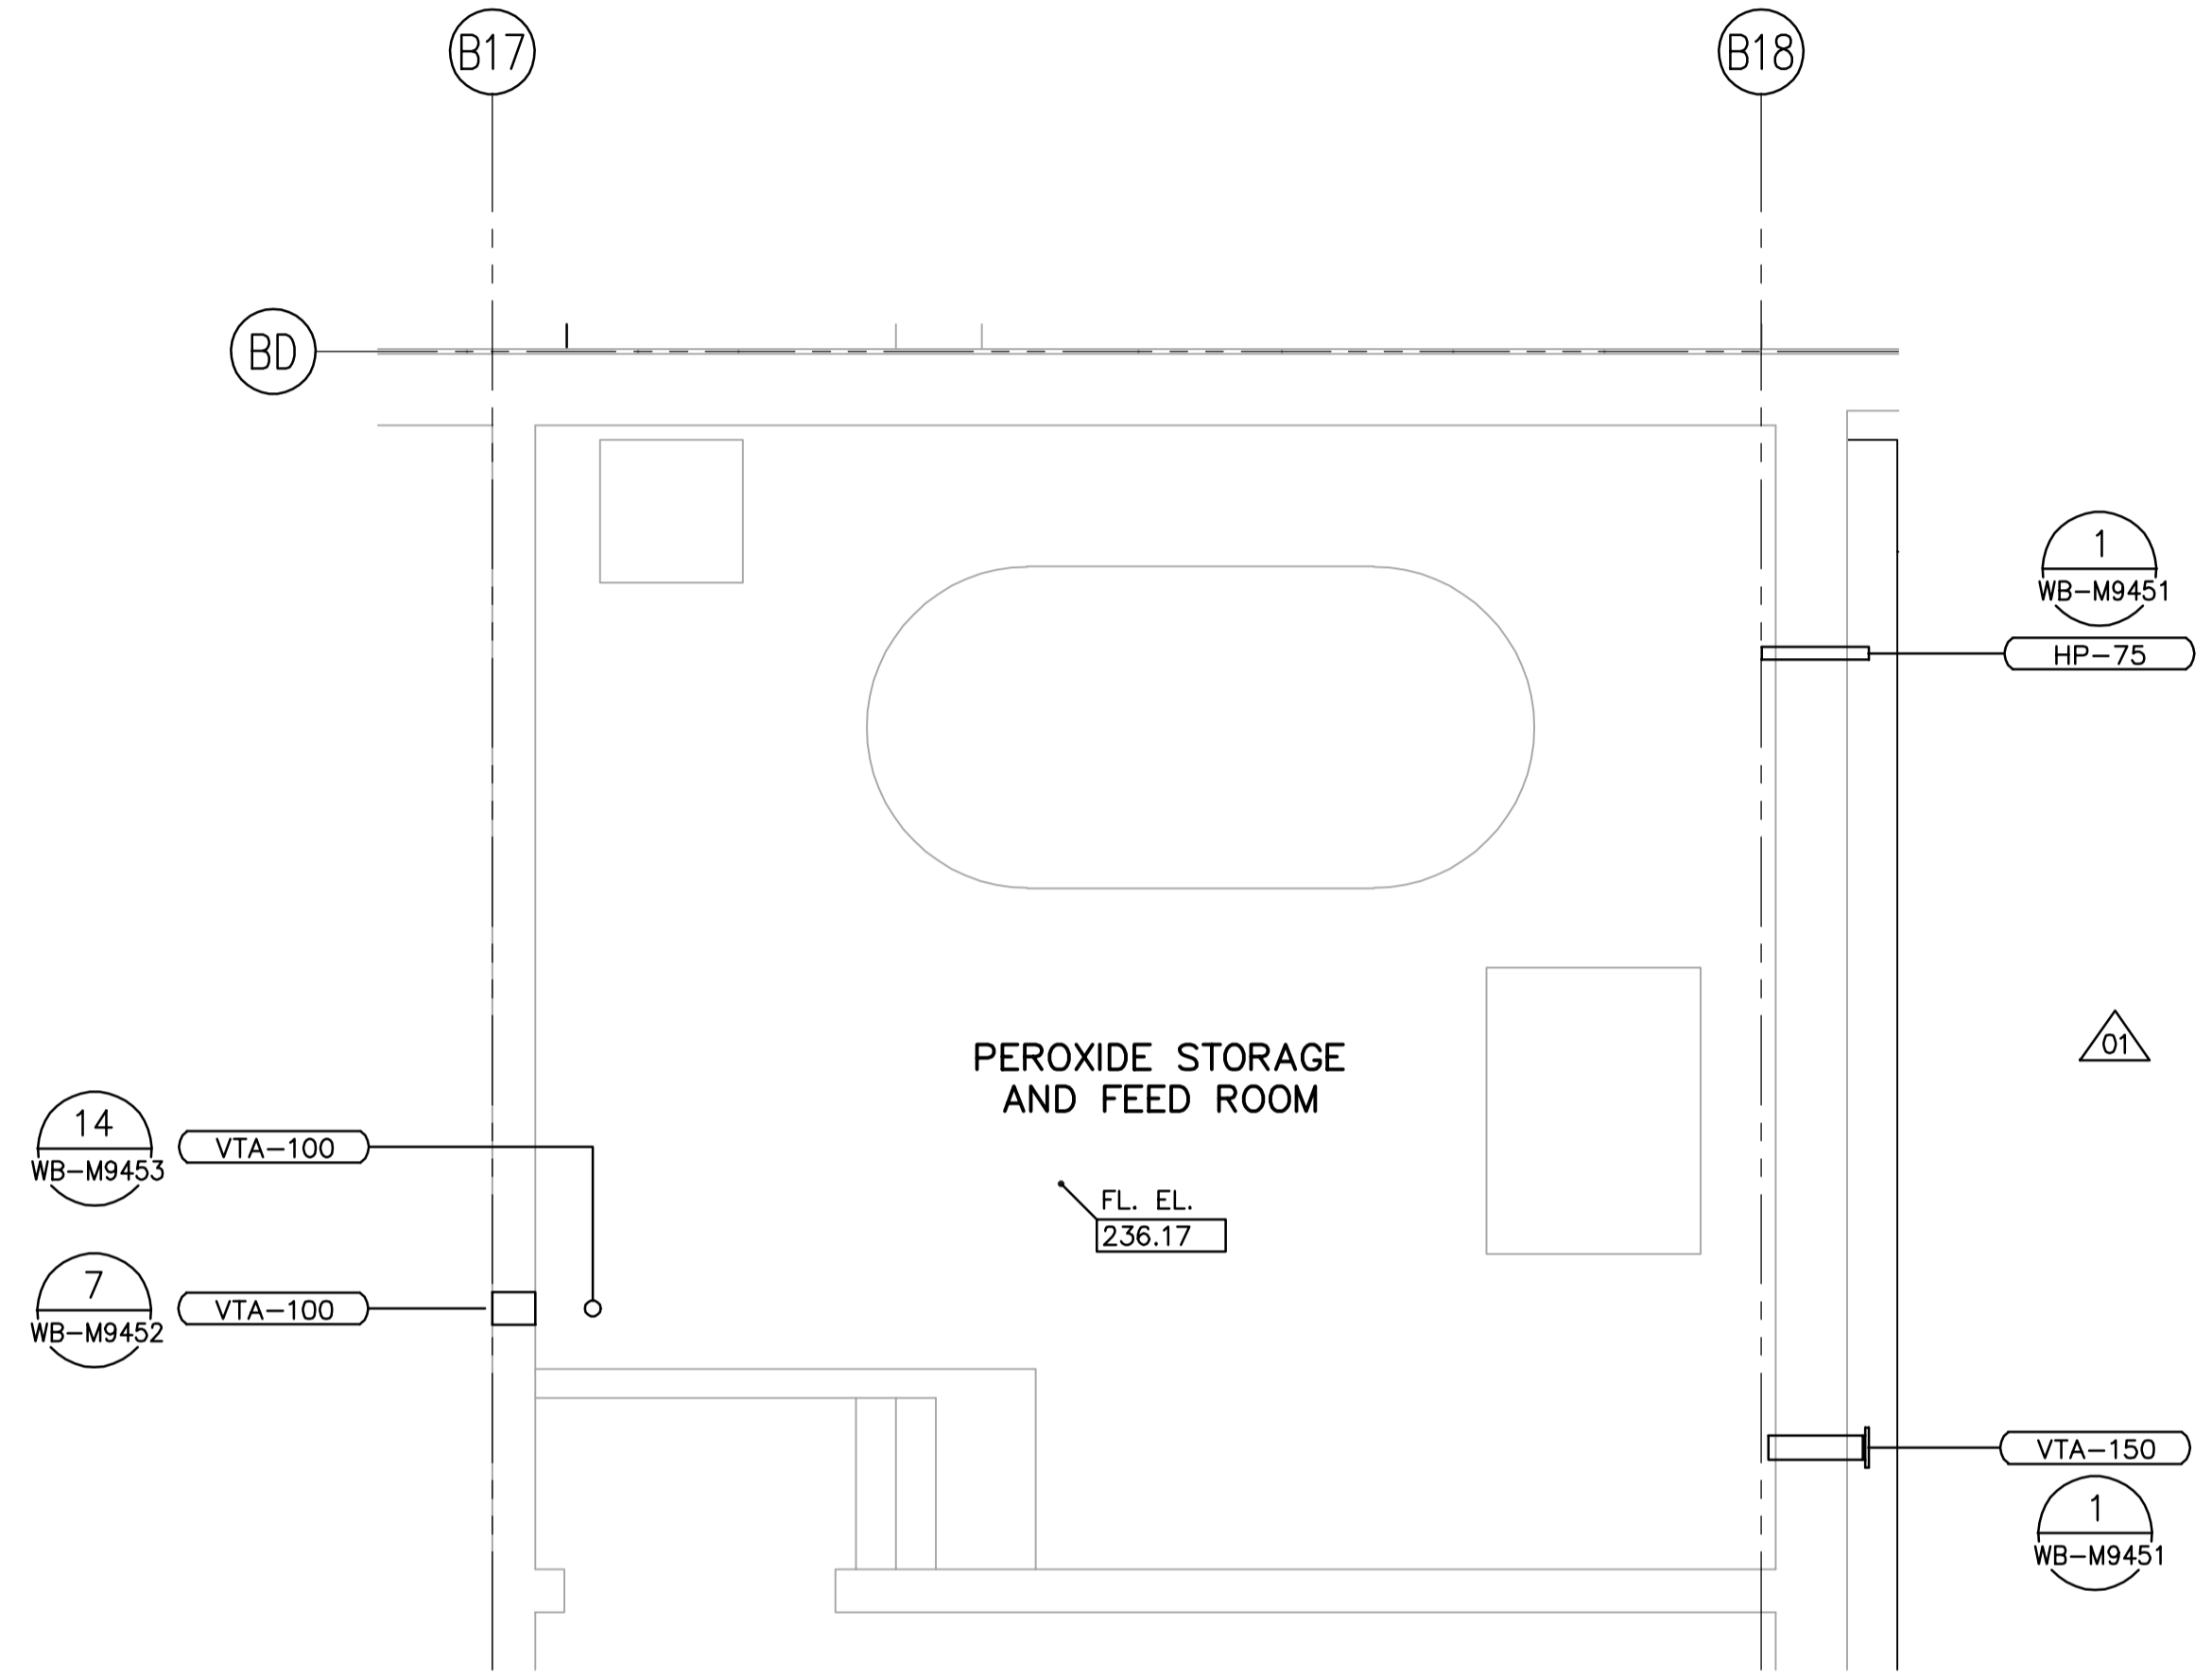

4 DETAIL
WC-M9111 1:50

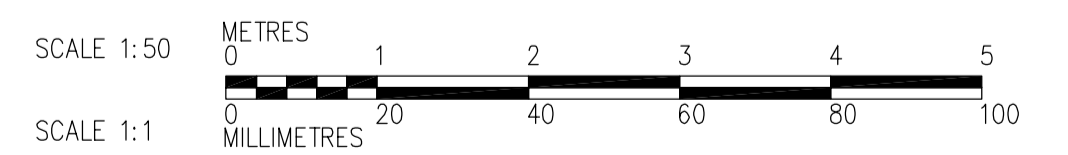

 Certificate of Authorization CH2M HILL Canada Ltd. No. 1441 Expiry: April 30, 2007	B.M. ELEV.	 Frederickson Cooper ARCHITECTS	 A You International Ltd. Company	ENGINEER'S SEAL ORIGINAL SIGNED BY J.W. SINCLAIR 2006/02/06	 THE CITY OF WINNIPEG WATER AND WASTE DEPARTMENT ENGINEERING DIVISION																
	<table border="1" style="width:100%; border-collapse: collapse;"> <tr> <td style="width:5%;">02</td> <td style="width:45%;">742-2005 ADDENDUM 3</td> <td style="width:15%;">06/05/05</td> <td style="width:10%;">KS</td> </tr> <tr> <td>01</td> <td>583-2005 ADDENDUM 3</td> <td>06/03/10</td> <td>KS</td> </tr> <tr> <td>00</td> <td>ISSUED FOR TENDER</td> <td>2006/02/03</td> <td>KS</td> </tr> <tr> <td>NO.</td> <td>REVISIONS</td> <td>DATE</td> <td>BY</td> </tr> </table>	02	742-2005 ADDENDUM 3	06/05/05	KS	01	583-2005 ADDENDUM 3	06/03/10	KS	00	ISSUED FOR TENDER	2006/02/03	KS	NO.	REVISIONS	DATE	BY	DESIGNED BY KS DRAWN BY YFS SCALE: 1:50	CHECKED BY NN APPROVED BY DJT RELEASED FOR CONSTRUCTION BY: R. SOROKOWSKI 2006/02/08	CONSULTANT DRAWING NO. WC-M9403	WATER TREATMENT PLANT CHEMICAL FEED SYSTEMS MECHANICAL AND ELECTRICAL PROCESS MECHANICAL PIPE EMBEDS SBS AND PEROXIDE AREA PLAN DETAILS
	02	742-2005 ADDENDUM 3	06/05/05	KS																	
01	583-2005 ADDENDUM 3	06/03/10	KS																		
00	ISSUED FOR TENDER	2006/02/03	KS																		
NO.	REVISIONS	DATE	BY																		
DATE 2005/10/14	DATE 2006/02/08	CITY FILE NUMBER SHEET OF CITY DRAWING NUMBER 1-0601C-A-M9403-001-020																			