

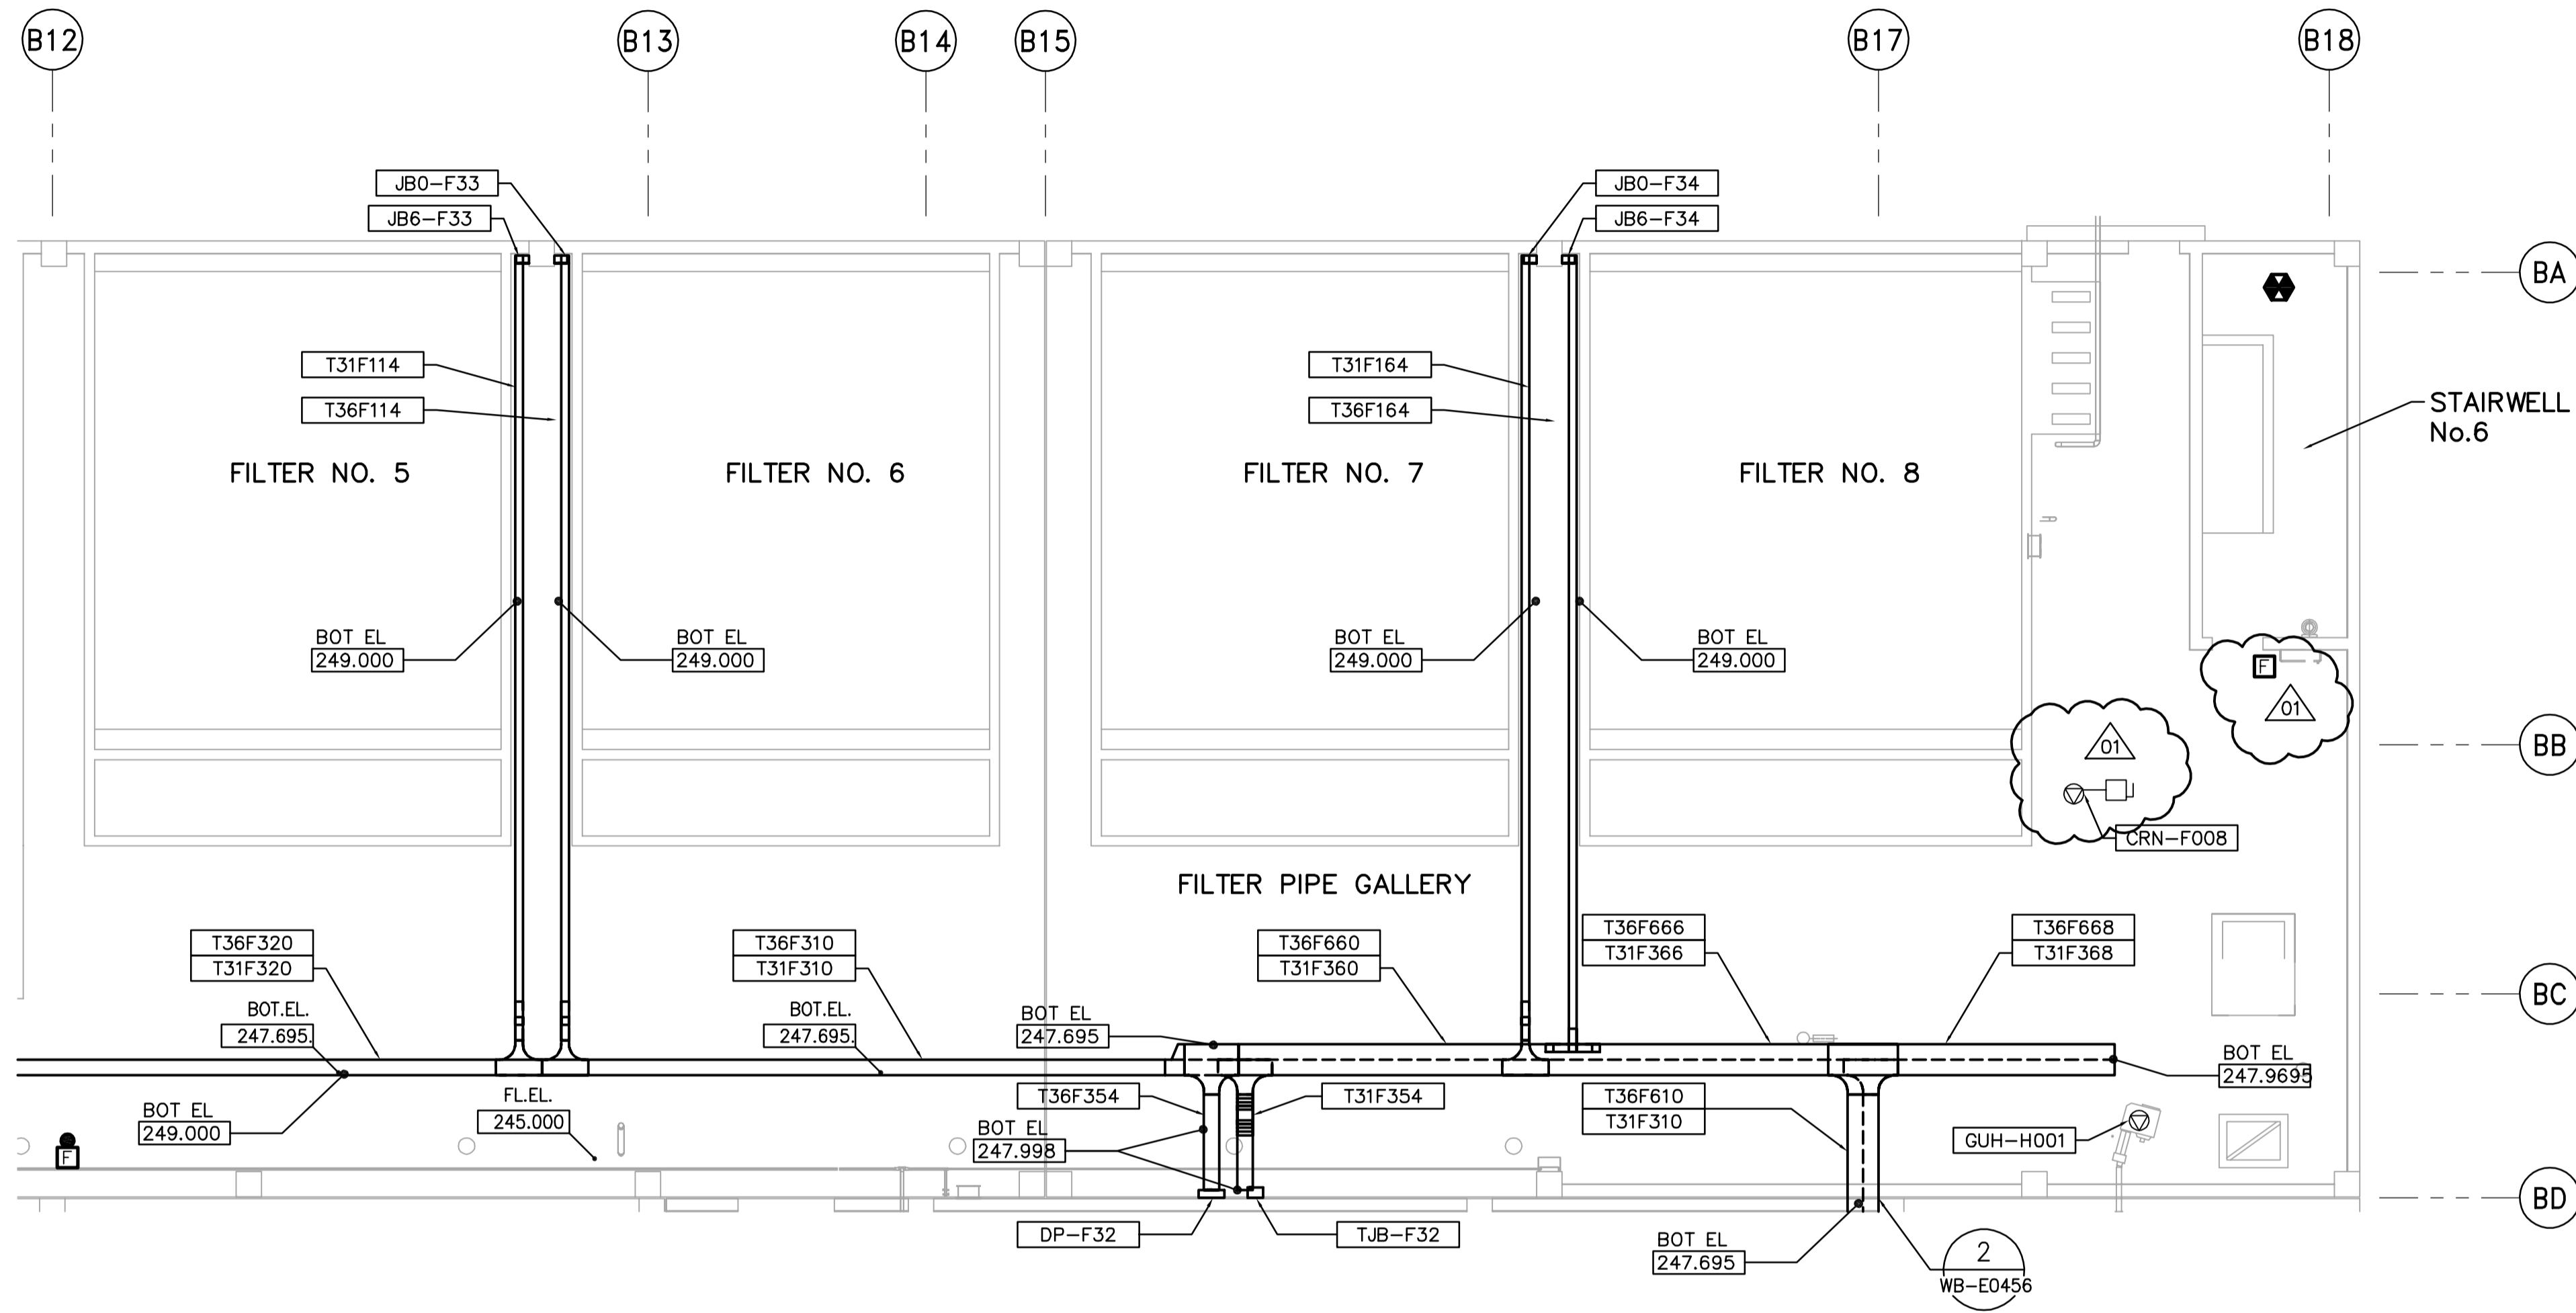


- NOTES:**
- SEE DRAWING WB-E0401 FOR CABLE TRAY MOUNTING DETAILS.
 - ALL 120V LOADS ARE FED FROM LP-H31
 - ALL 600V LOADS ARE FED FROM DP-H32
 - FOR CABLE TRAY TAGGING SEE DET. 3 WB-E0455

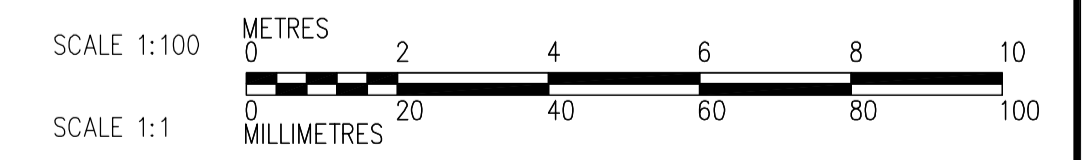

THIRD FLOOR FACILITY PLAN 2
1:100

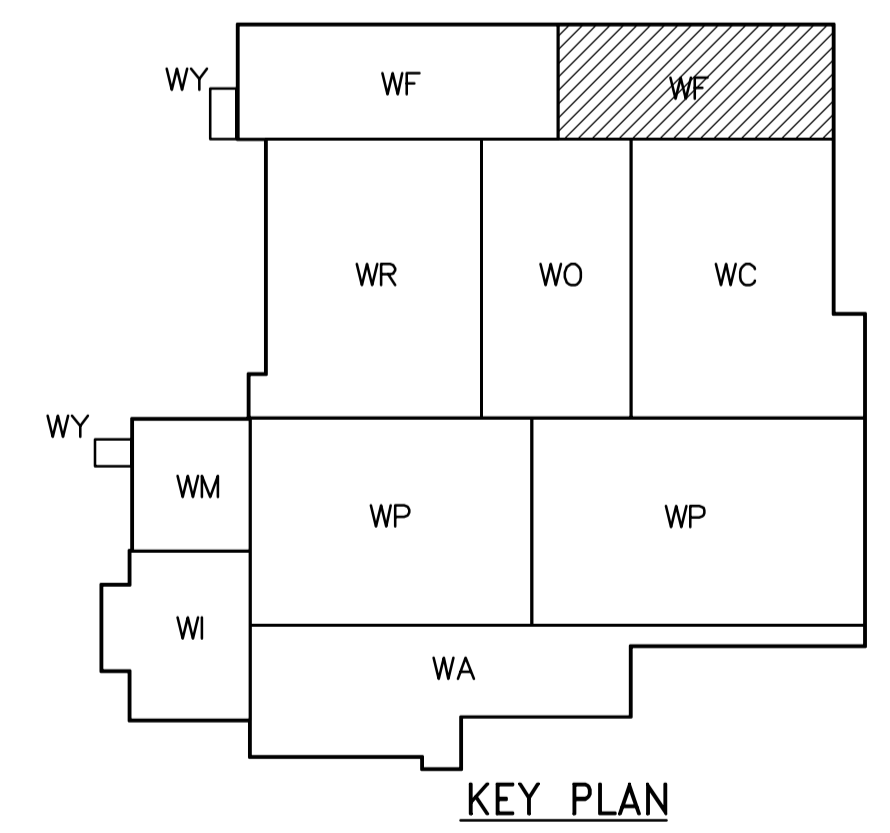

 APEGN Certificate of Authorization CH2M HILL Canada Ltd. No. 1441 Expiry: April 30, 2007	B.M. ELEV.	 Frederickson Cooper ARCHITECTS	 A Tyco International Ltd. Company	ENGINEER'S SEAL ORIGINAL SIGNED BY L.D. LLEWELLYN 2006/03/29	 THE CITY OF WINNIPEG WATER AND WASTE DEPARTMENT ENGINEERING DIVISION WATER TREATMENT PLANT FILTRATION MECHANICAL AND ELECTRICAL	CITY FILE NUMBER SHEET OF
	DESIGNED BY LL CHECKED BY ND DRAWN BY TL APPROVED BY AHL SCALE: 1:100 RELEASED FOR CONSTRUCTION BY: R. SOROKOWSKI CONSULTANT DRAWING NO. WF-E0132			NO. REVISIONS DATE BY DATE 01 742-2005 ADDENDUM 3 06/05/05 LL 00 ISSUED FOR TENDER 06/03/29 LL 2005/07/13 2006/03/29		CITY DRAWING NUMBER 1-0601F-A-E0132-001-01D