

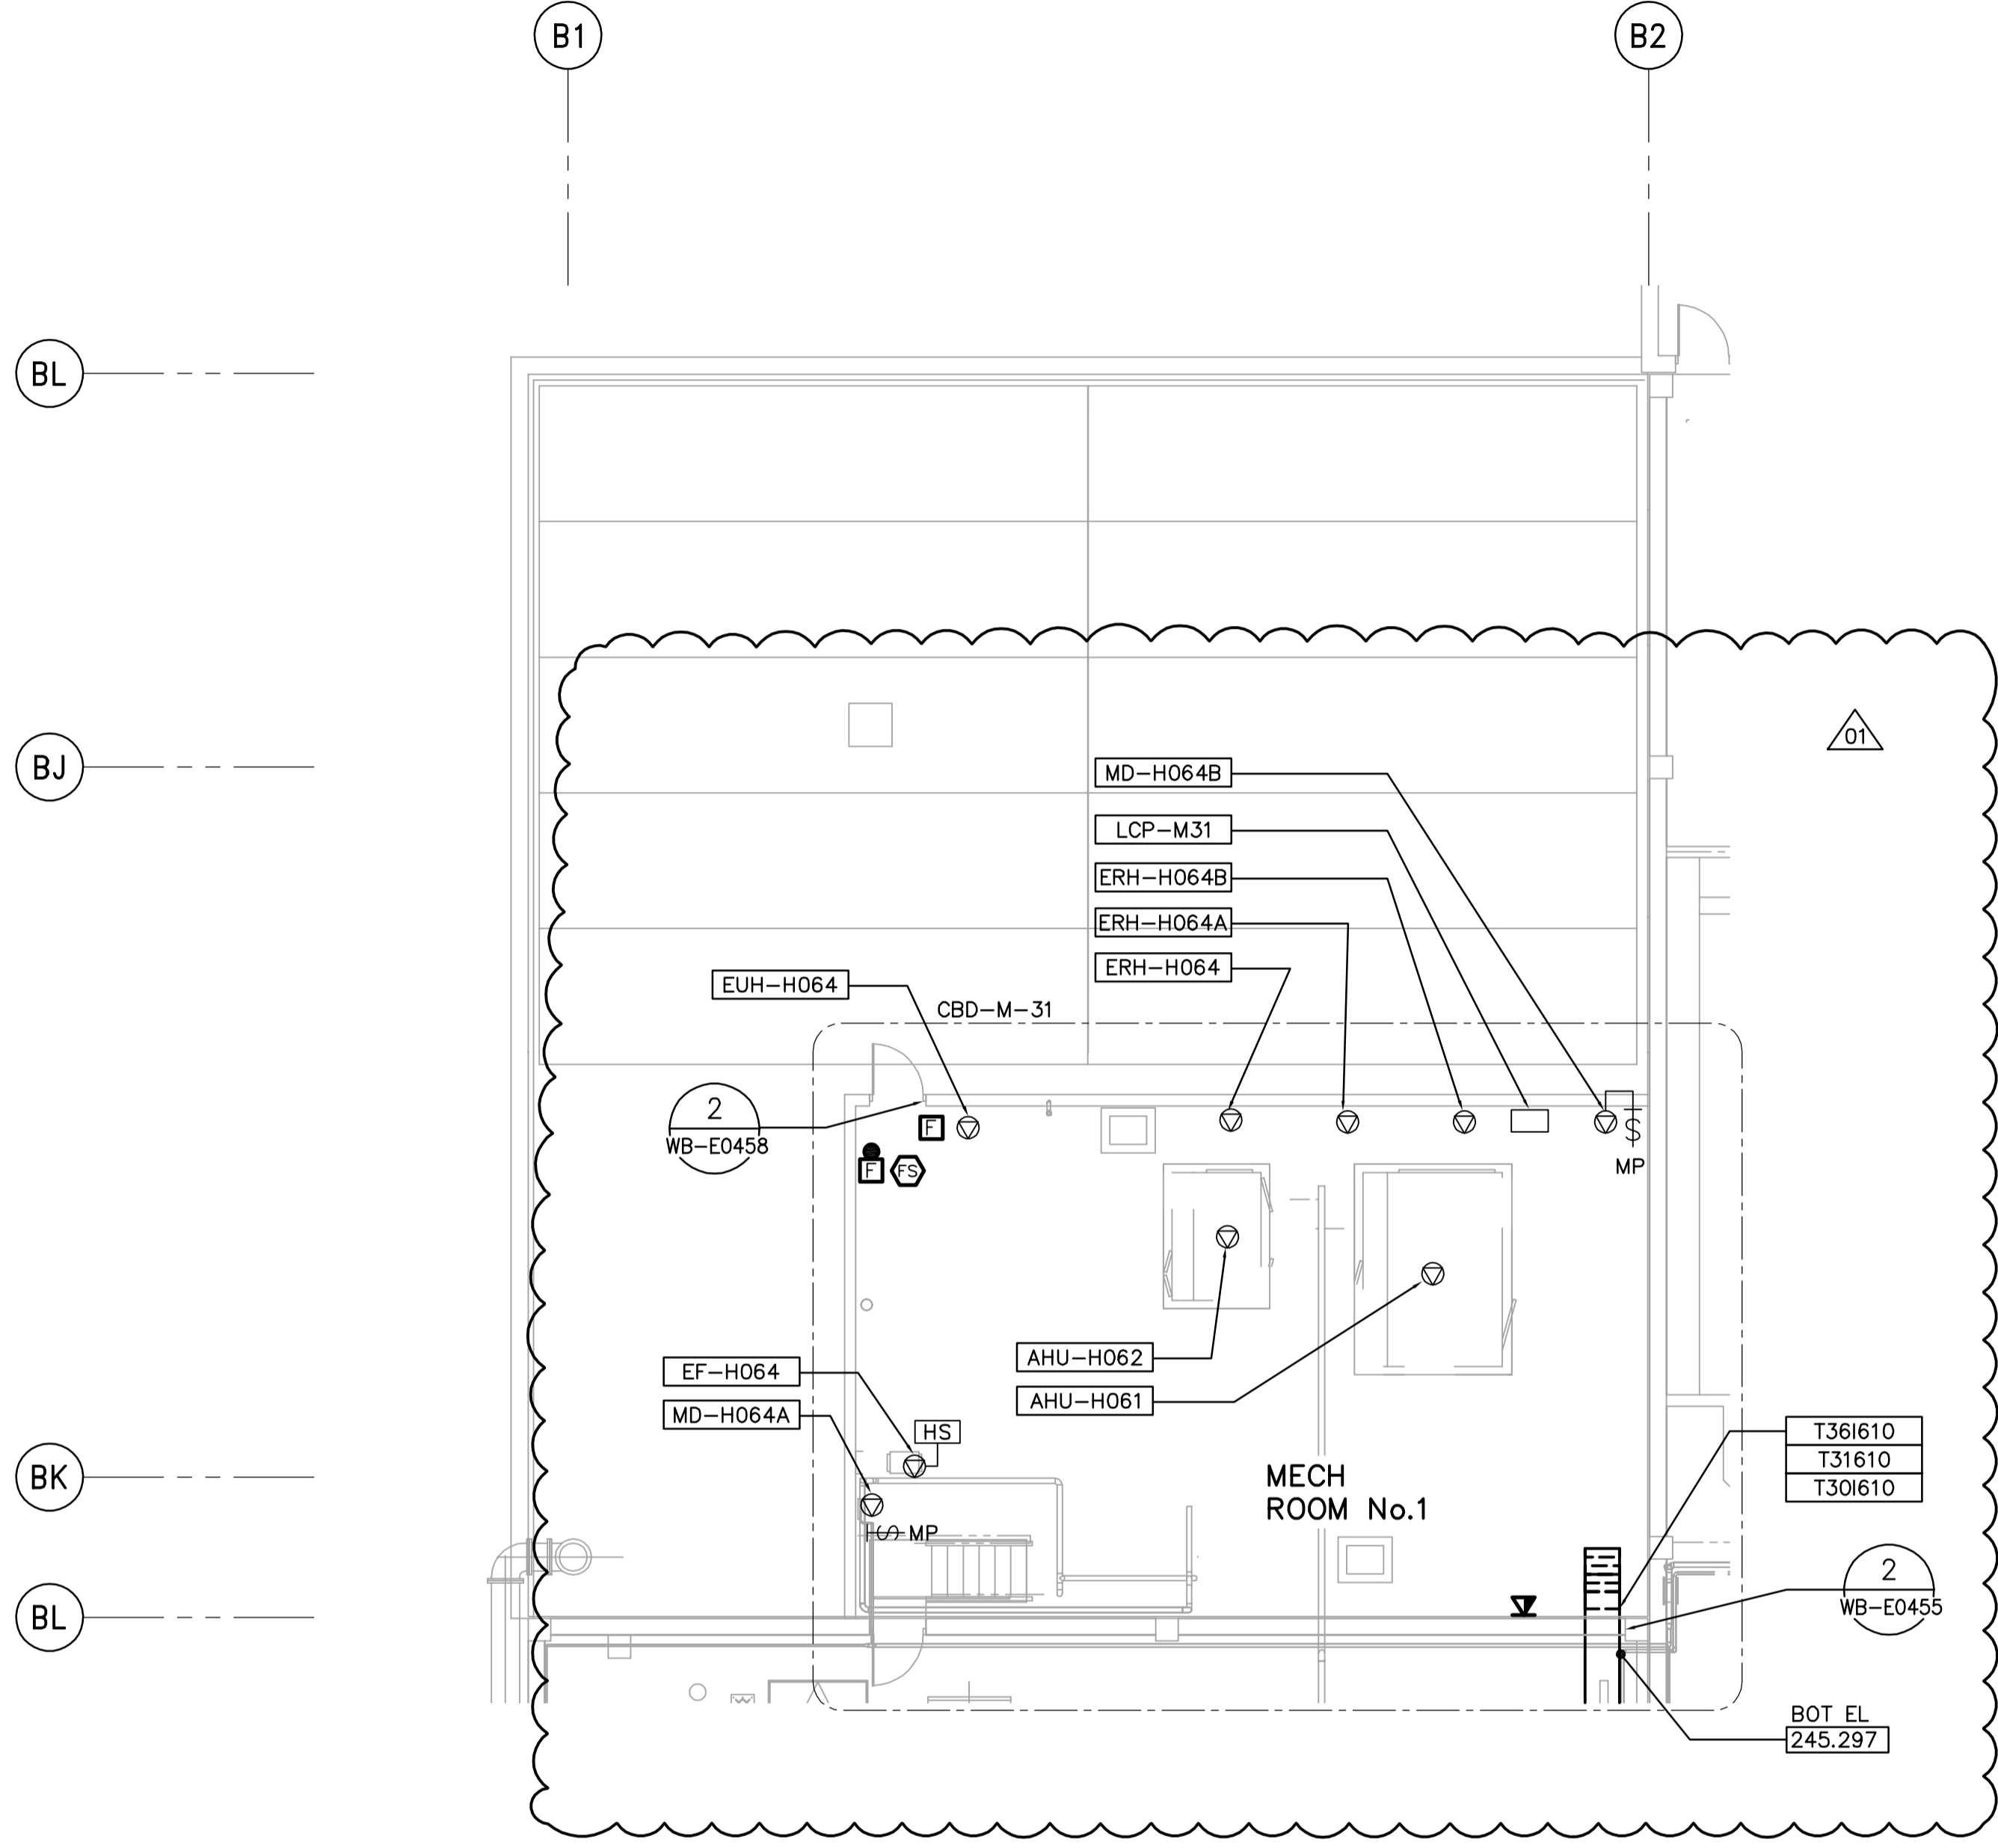


NOTES
 1. PROVIDE STAIRWELL SMOKE DETECTORS AS SHOWN ON FIRE PROTECTION DRAWINGS. 01

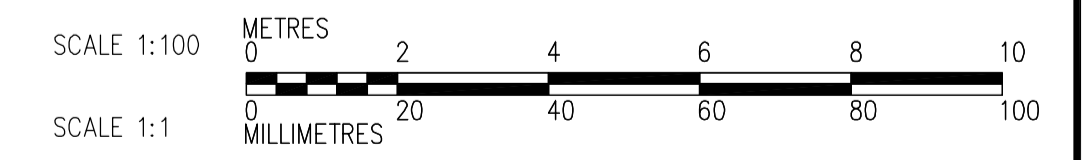

THIRD FLOOR FACILITY PLAN
 1:100

CABLE TRAY TAGGING
 SEE DETAIL 3
 WB-E0455

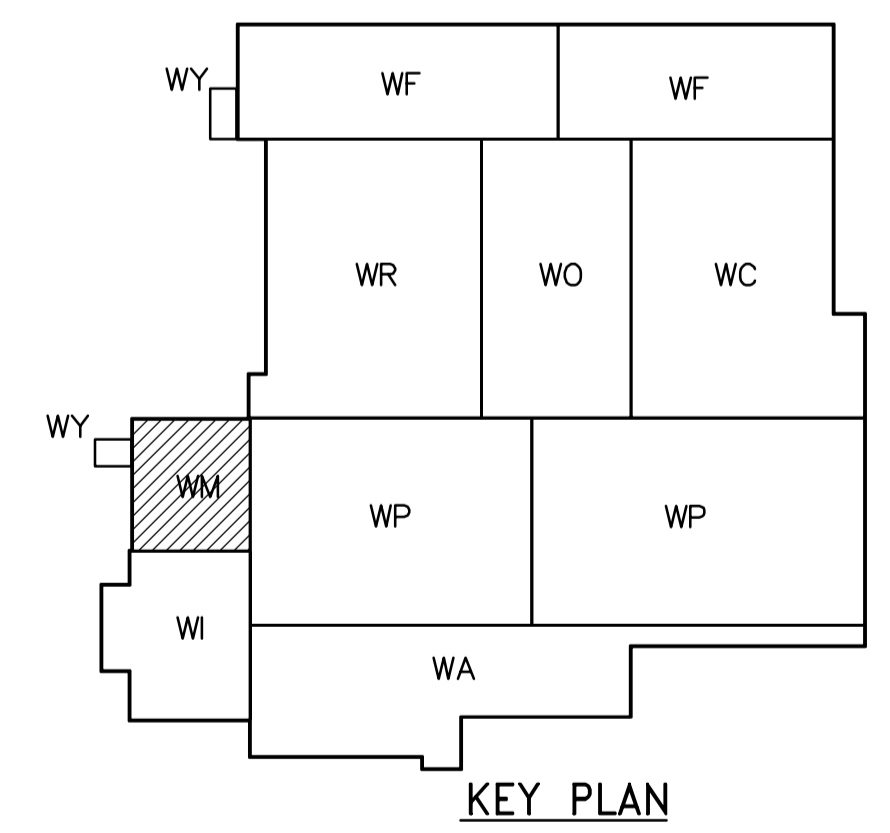

 APEGN Certificate of Authorization CH2M HILL Canada Ltd. No. 1441 Expiry: April 30, 2007	B.M. ELEV.	 Frederickson Cooper ARCHITECTS	 A Terra International Ltd. Company	ENGINEER'S SEAL	 THE CITY OF WINNIPEG WATER AND WASTE DEPARTMENT ENGINEERING DIVISION			
				DESIGNED BY PF		CHECKED BY ND	ORIGINAL SIGNED BY L.D. LLEWELLYN	
				DRAWN BY TL		APPROVED BY AHL	2006/03/29	
				SCALE: 1:100		RELEASED FOR CONSTRUCTION BY: R. SOROKOWSKI	CONSULTANT DRAWING NO. WM-E0131	
	NO. REVISIONS	DATE BY	DATE	2006/02/14	DATE	2006/03/29	WATER TREATMENT PLANT GENERAL PLANT SERVICES/MISCELLANEOUS MECHANICAL AND ELECTRICAL	CITY FILE NUMBER SHEET OF CITY DRAWING NUMBER 1-0601M-A-E0131-001-01D