


FIRST FLOOR PROCESS PLAN
1:100

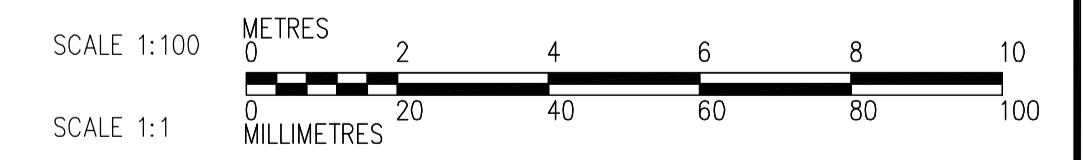

<p>APEGN Certificate of Authorization CH2M HILL Canada Ltd. No. 1441 Expiry: April 30, 2007</p>	<p>Frederickson Cooper ARCHITECTS</p>	<p>EarthTech A Tyco International Ltd. Company</p>	ENGINEER'S SEAL	<p>THE CITY OF WINNIPEG WATER AND WASTE DEPARTMENT ENGINEERING DIVISION</p>																		
			DESIGNED BY: LL		CHECKED BY: ND	ORIGINAL SIGNED BY: L.D. LLEWELLYN																
			DRAWN BY: TLL		APPROVED BY: AHL	2006/03/29																
			SCALE: 1:100		RELEASED FOR CONSTRUCTION BY: R. SOROKOWSKI	CONSULTANT DRAWING NO. WR-E0112																
<table border="1"> <thead> <tr> <th>NO.</th> <th>REVISIONS</th> <th>DATE</th> <th>BY</th> <th>DATE</th> <th>BY</th> </tr> </thead> <tbody> <tr> <td>01</td> <td>742-2005 ADDENDUM 3</td> <td>06/05/05</td> <td>LL</td> <td></td> <td></td> </tr> <tr> <td>00</td> <td>ISSUED FOR TENDER</td> <td>06/03/29</td> <td>LL</td> <td></td> <td></td> </tr> </tbody> </table>			NO.	REVISIONS	DATE	BY	DATE	BY	01	742-2005 ADDENDUM 3	06/05/05	LL			00	ISSUED FOR TENDER	06/03/29	LL			<p>WATER TREATMENT PLANT RESIDUALS HANDLING AREA MECHANICAL AND ELECTRICAL</p>	<p>CITY FILE NUMBER</p> <p>SHEET OF</p> <p>CITY DRAWING NUMBER</p> <p>1-0601R-A-E0112-001-01D</p>
NO.	REVISIONS	DATE	BY	DATE	BY																	
01	742-2005 ADDENDUM 3	06/05/05	LL																			
00	ISSUED FOR TENDER	06/03/29	LL																			
<p>B.M. ELEV.</p>			<p>ELECTRICAL RESIDUALS HANDLING AREA FIRST FLOOR PROCESS PLAN</p>																			