SHEET: COW-A1 (05/2005)

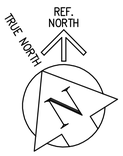

NOTES:

1. SEE MCC #2A & #2B SINGLE LINE DIAGRAM AND DP-P11 & DP-P12 POWER DISTRIBUTION FOR 600V POWER DISTRIBUTION.
2. ALL 120 AND 208V LOADS ARE FED FROM LP-P11 (01)

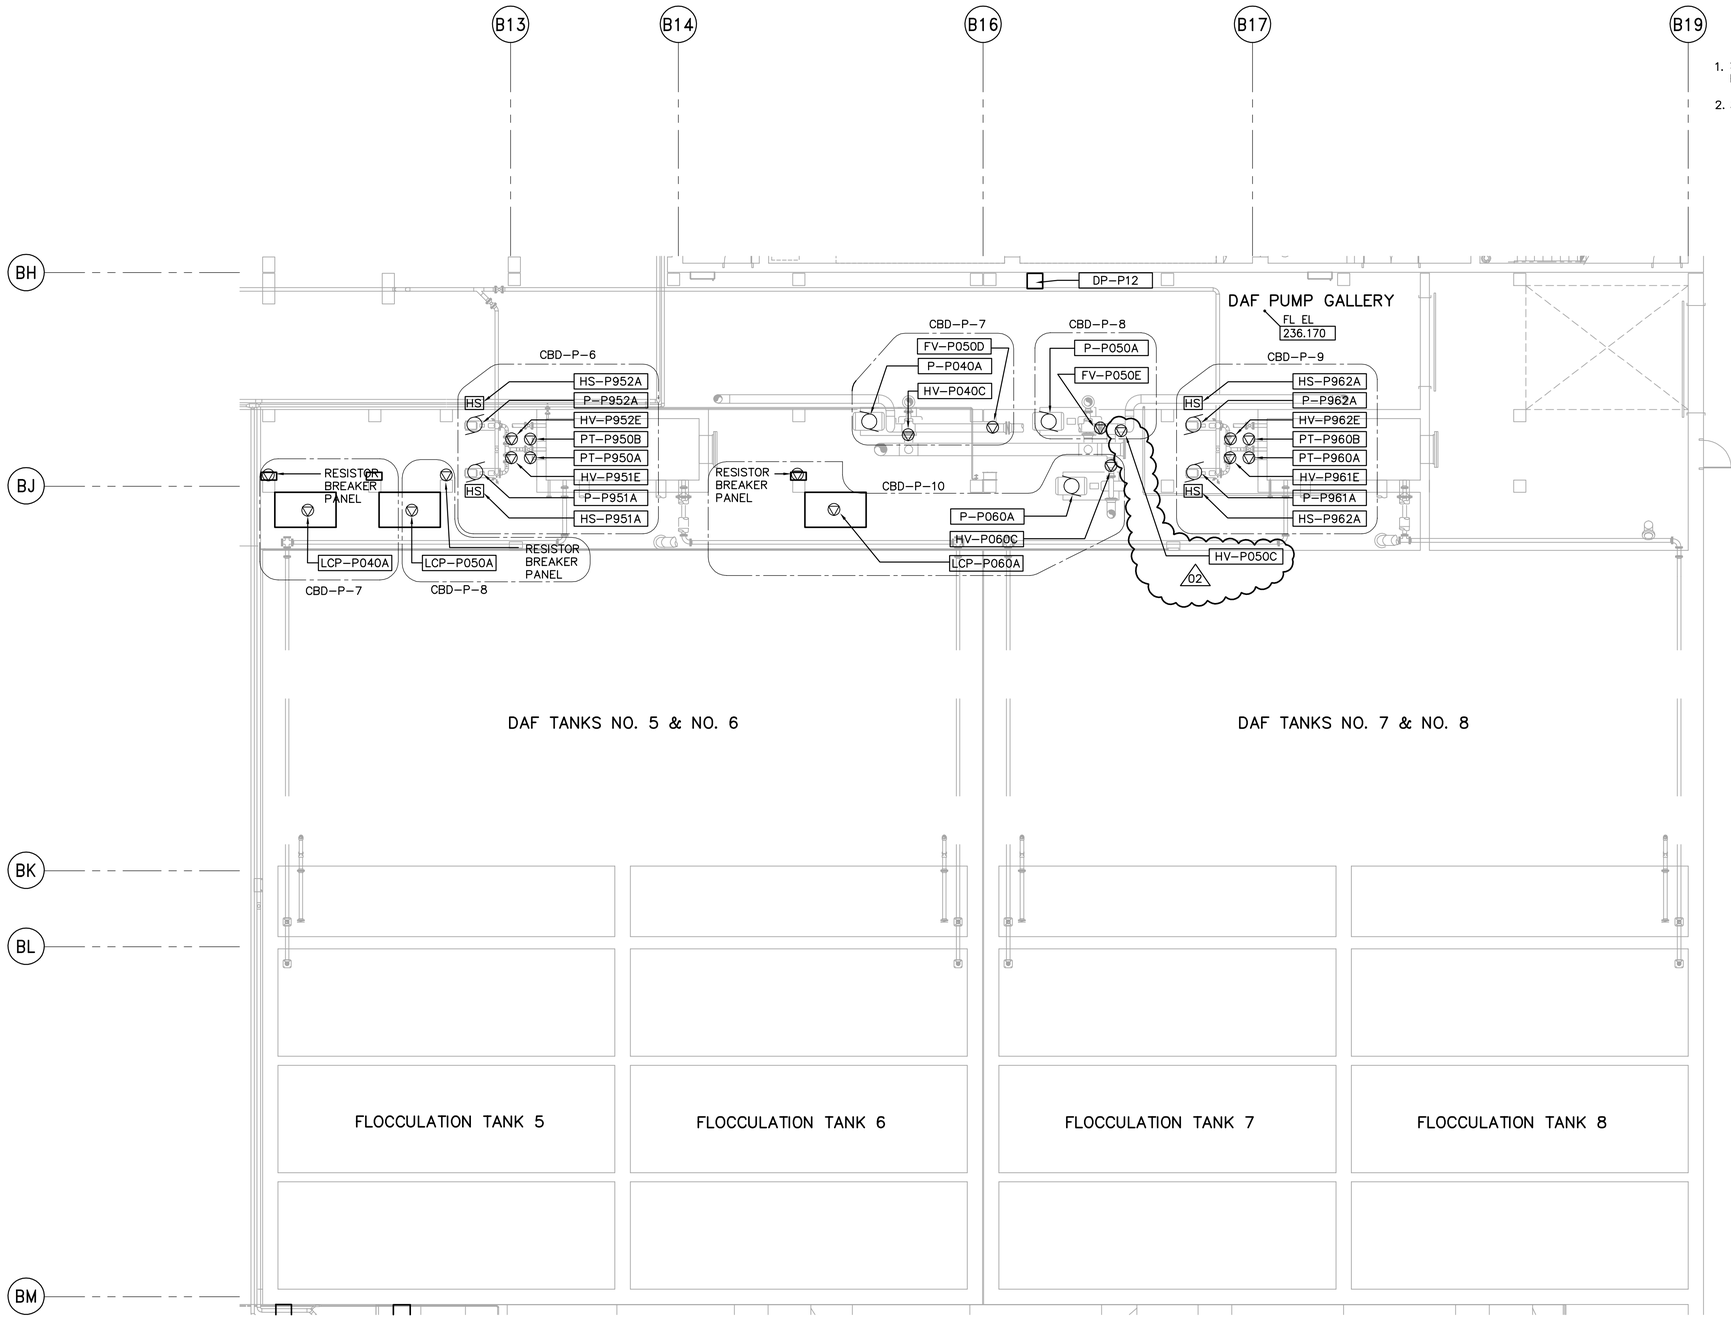

FIRST FLOOR PROCESS PLAN (AREA 2)
1:100

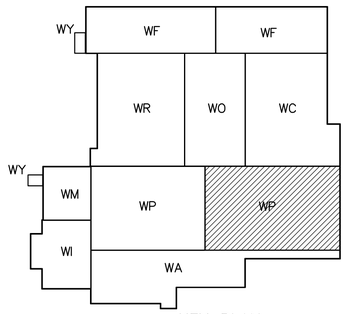

KEY PLAN

SCALE 1:100 METRES 0 2 4 6 8 10
SCALE 1:1 MILLIMETRES 0 20 40 60 80 100

APEGM
Certificate of Authorization
CH2M HILL Canada Ltd.
No. 1441 Expiry: April 30, 2007

B.M.
ELEV.

NO.	REVISIONS	DATE	BY
02	742-2005 ADDENDUM 4	06/05/12	LL
01	742-2005 ADDENDUM 3	06/05/05	LL
00	ISSUED FOR TENDER	06/03/29	LL

CH2MHILL
Fredericksen Cooper ARCHITECTS
EarthTech A Tyco International Ltd. Company

DESIGNED BY	JT	CHECKED BY	ND
DRAWN BY	KJ	APPROVED BY	AHL
SCALE:	1:100	RELEASED FOR CONSTRUCTION BY:	R. SOROKOWSKI
DATE	2005/07/12	DATE	2006/03/29

ENGINEER'S SEAL
ORIGINAL SIGNED BY
L.D. LLEWELLYN
2006/03/29

CONSULTANT DRAWING NO.
WP-E0114

Winnipeg
THE CITY OF WINNIPEG
WATER AND WASTE DEPARTMENT
ENGINEERING DIVISION

WATER TREATMENT PLANT
FLOCCULATION AND DAF
MECHANICAL AND ELECTRICAL

ELECTRICAL
FLOC/DAF AREA 2
FIRST FLOOR PROCESS PLAN

CITY FILE NUMBER
SHEET OF
CITY DRAWING NUMBER
1-0601P-A-E0114-001-02D

Last Save: 2006-05-10 1:20 PM

P:\EARTHTECH\321352WINNIPEGWTP\NDM\DESIGN\ACAD\742-POSTTENDER\DN_WP-E0114_CH2M.DWG