




MAINTENANCE WORKSHOP AREA HEATING AND VENTILATION SYSTEM

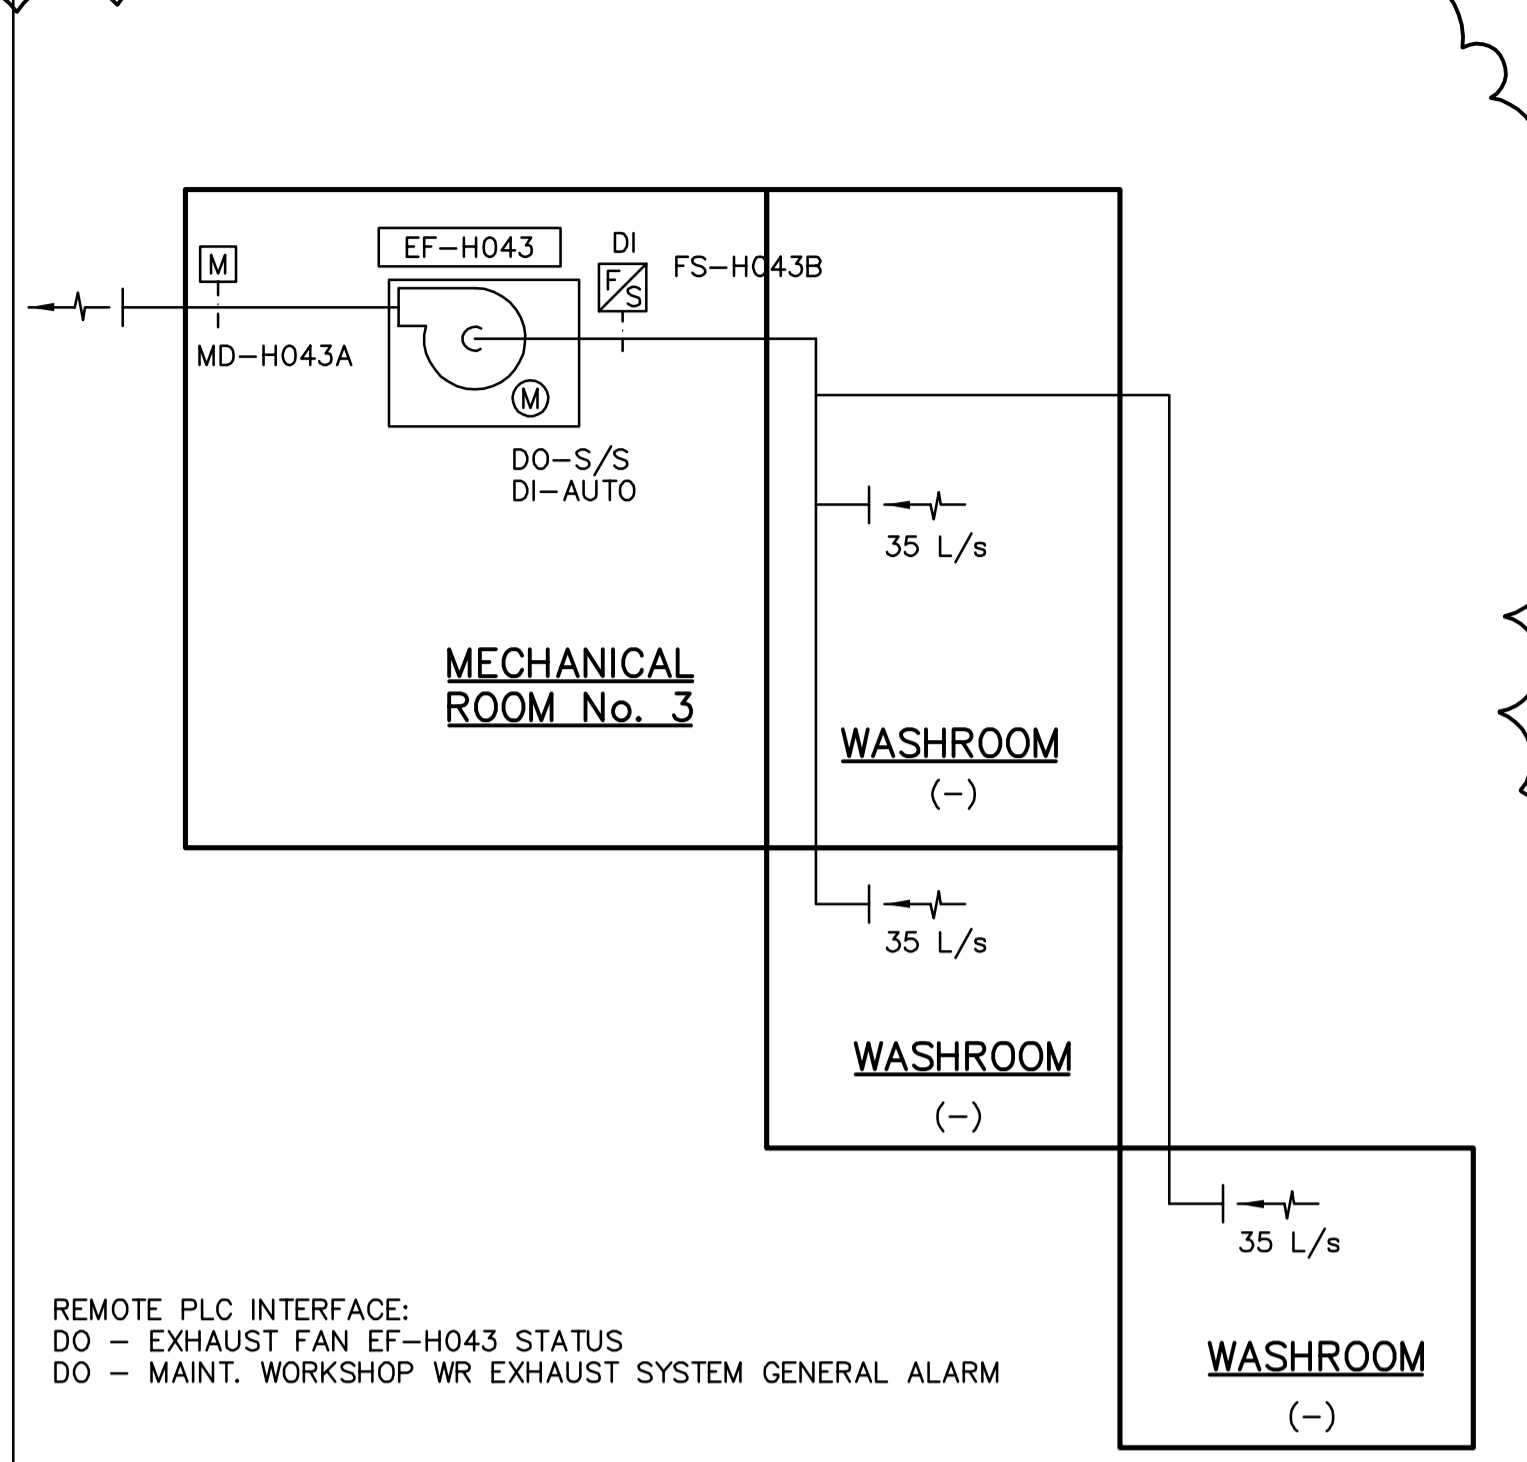


MAINTENANCE WORKSHOP AREA WASHROOMS VENTILATION SYSTEM

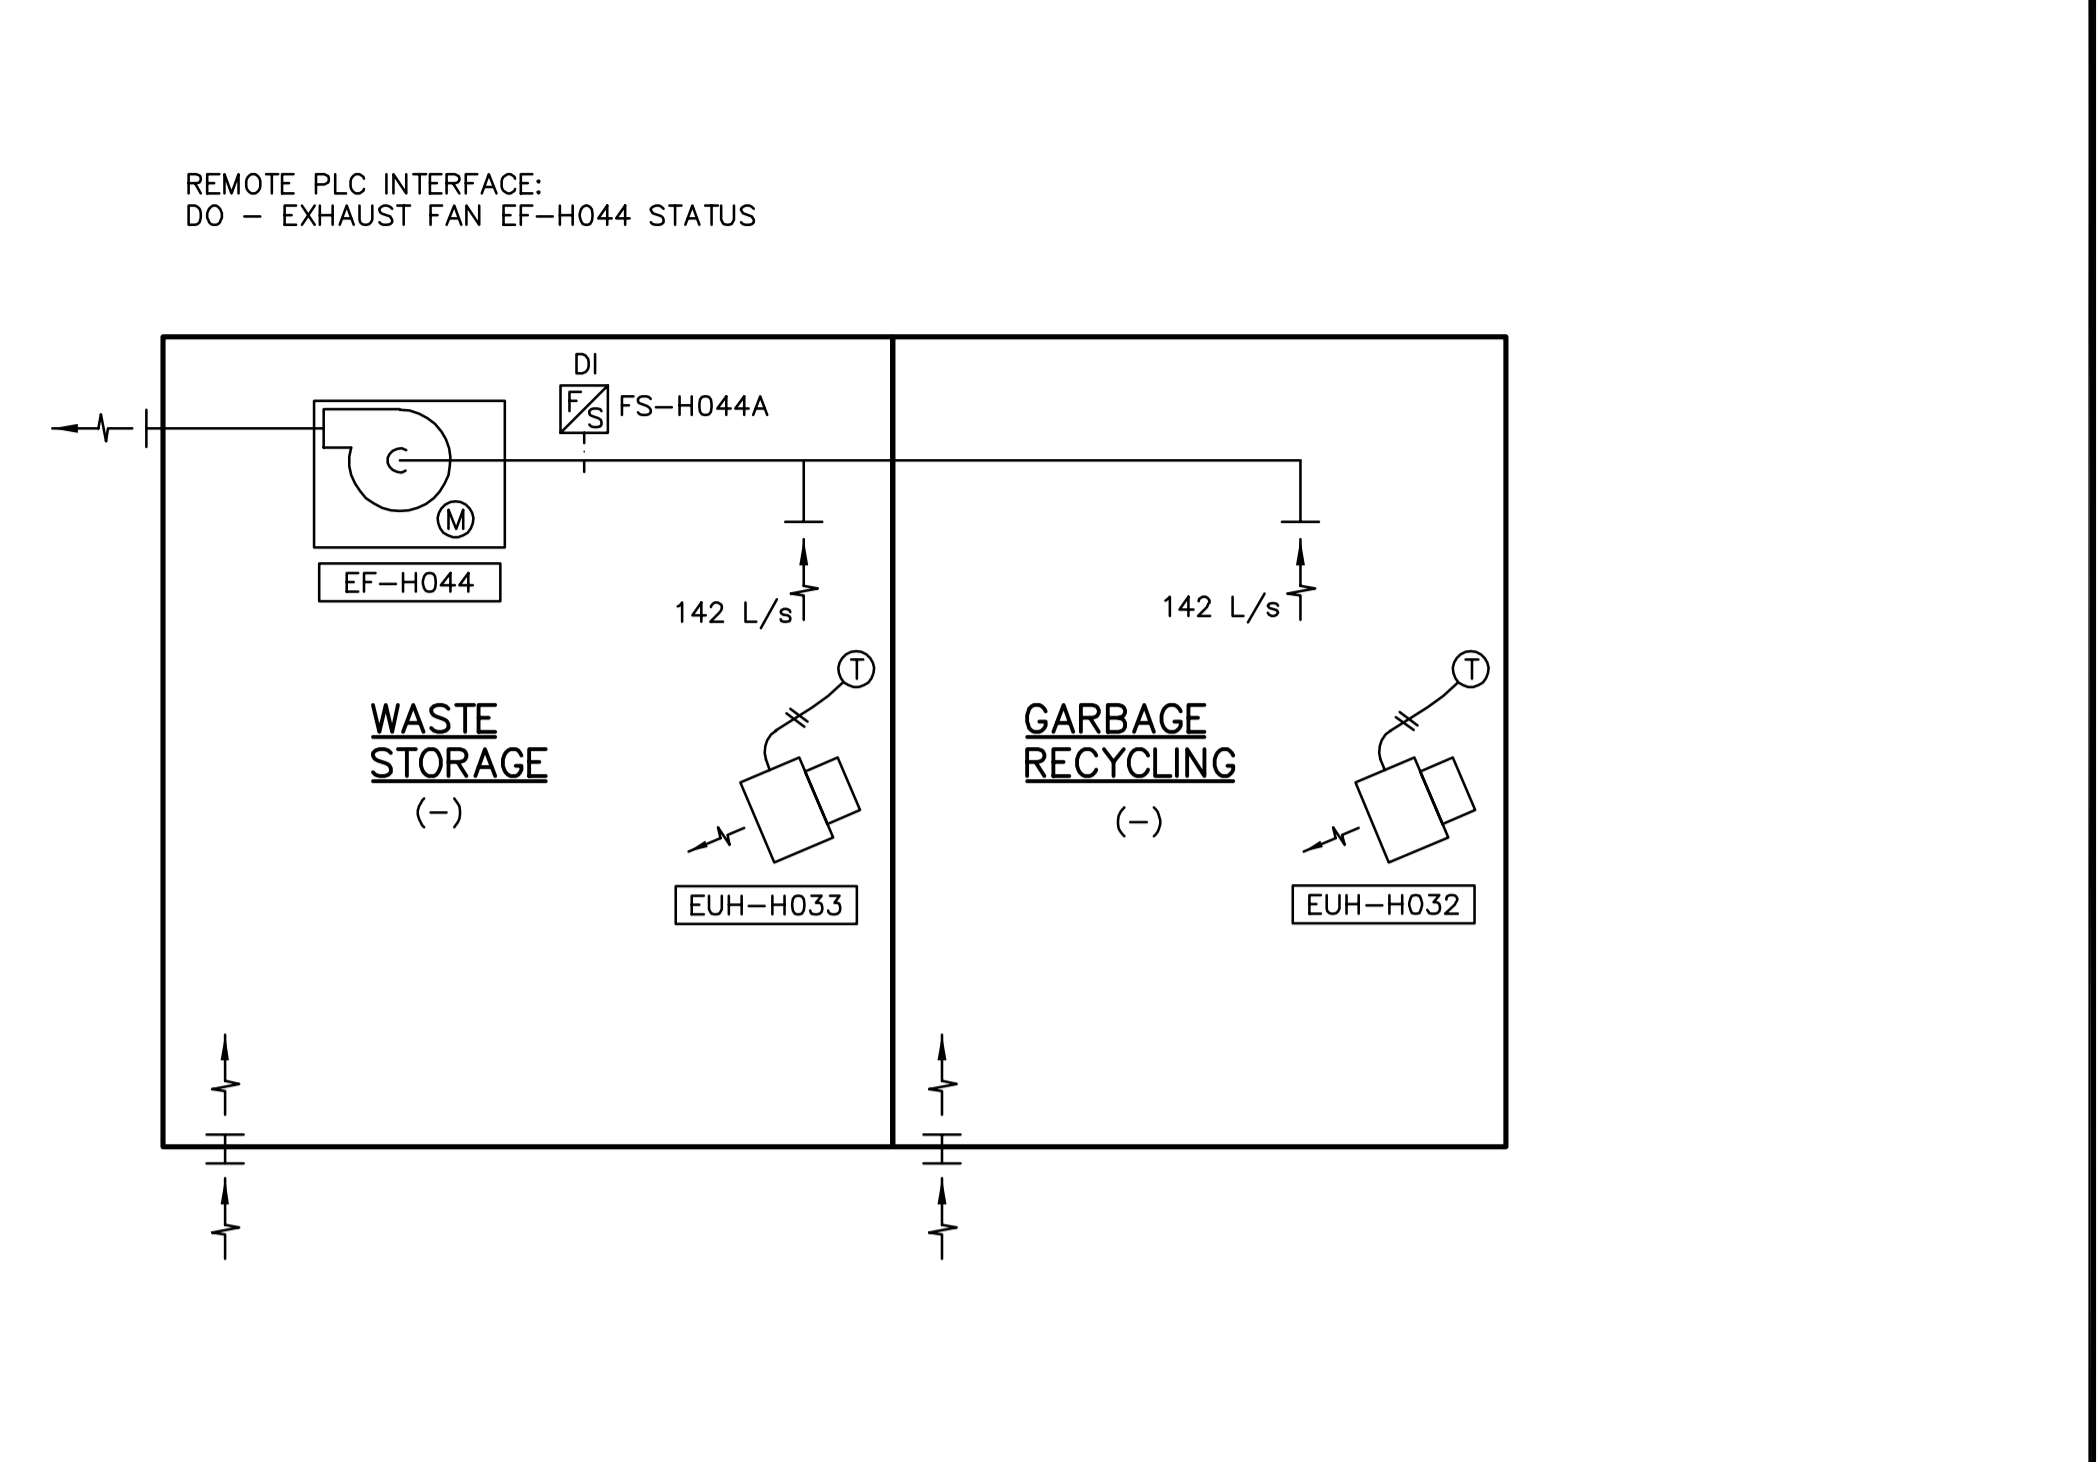


WASTE STORAGE AND GARBAGE RECYCLE ROOMS HEATING VENTILATION SYSTEM

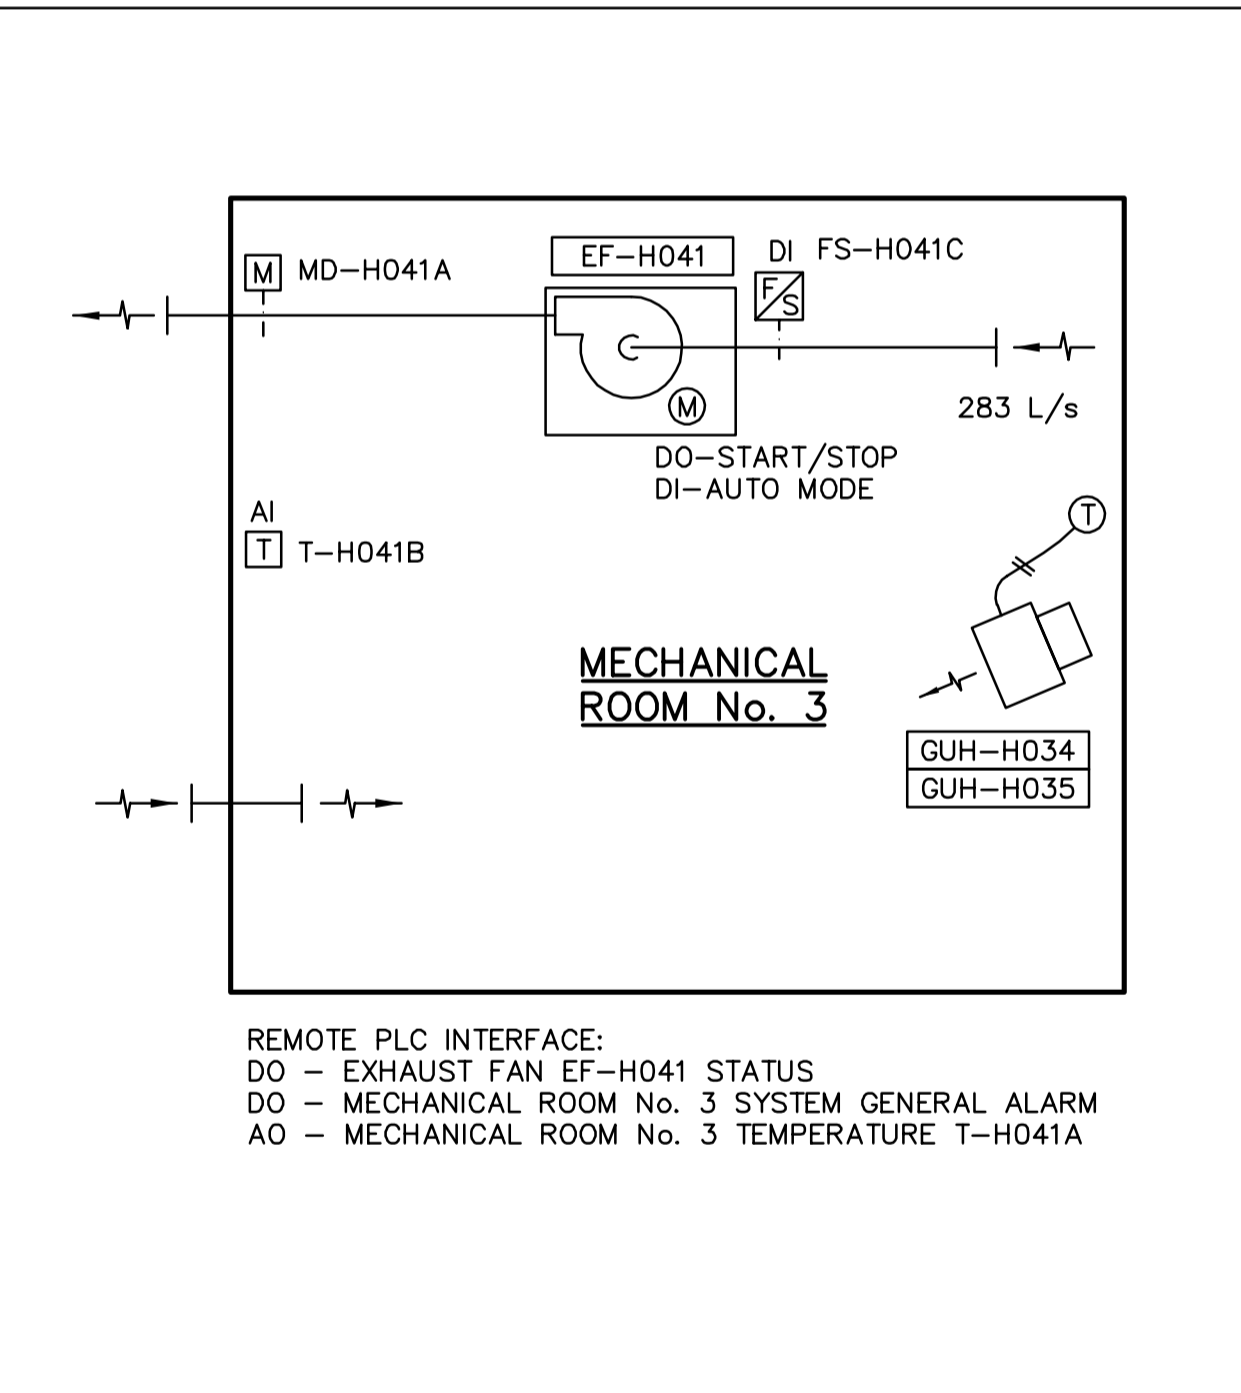

MECHANICAL ROOM No.3 HEATING AND VENTILATION SYSTEM

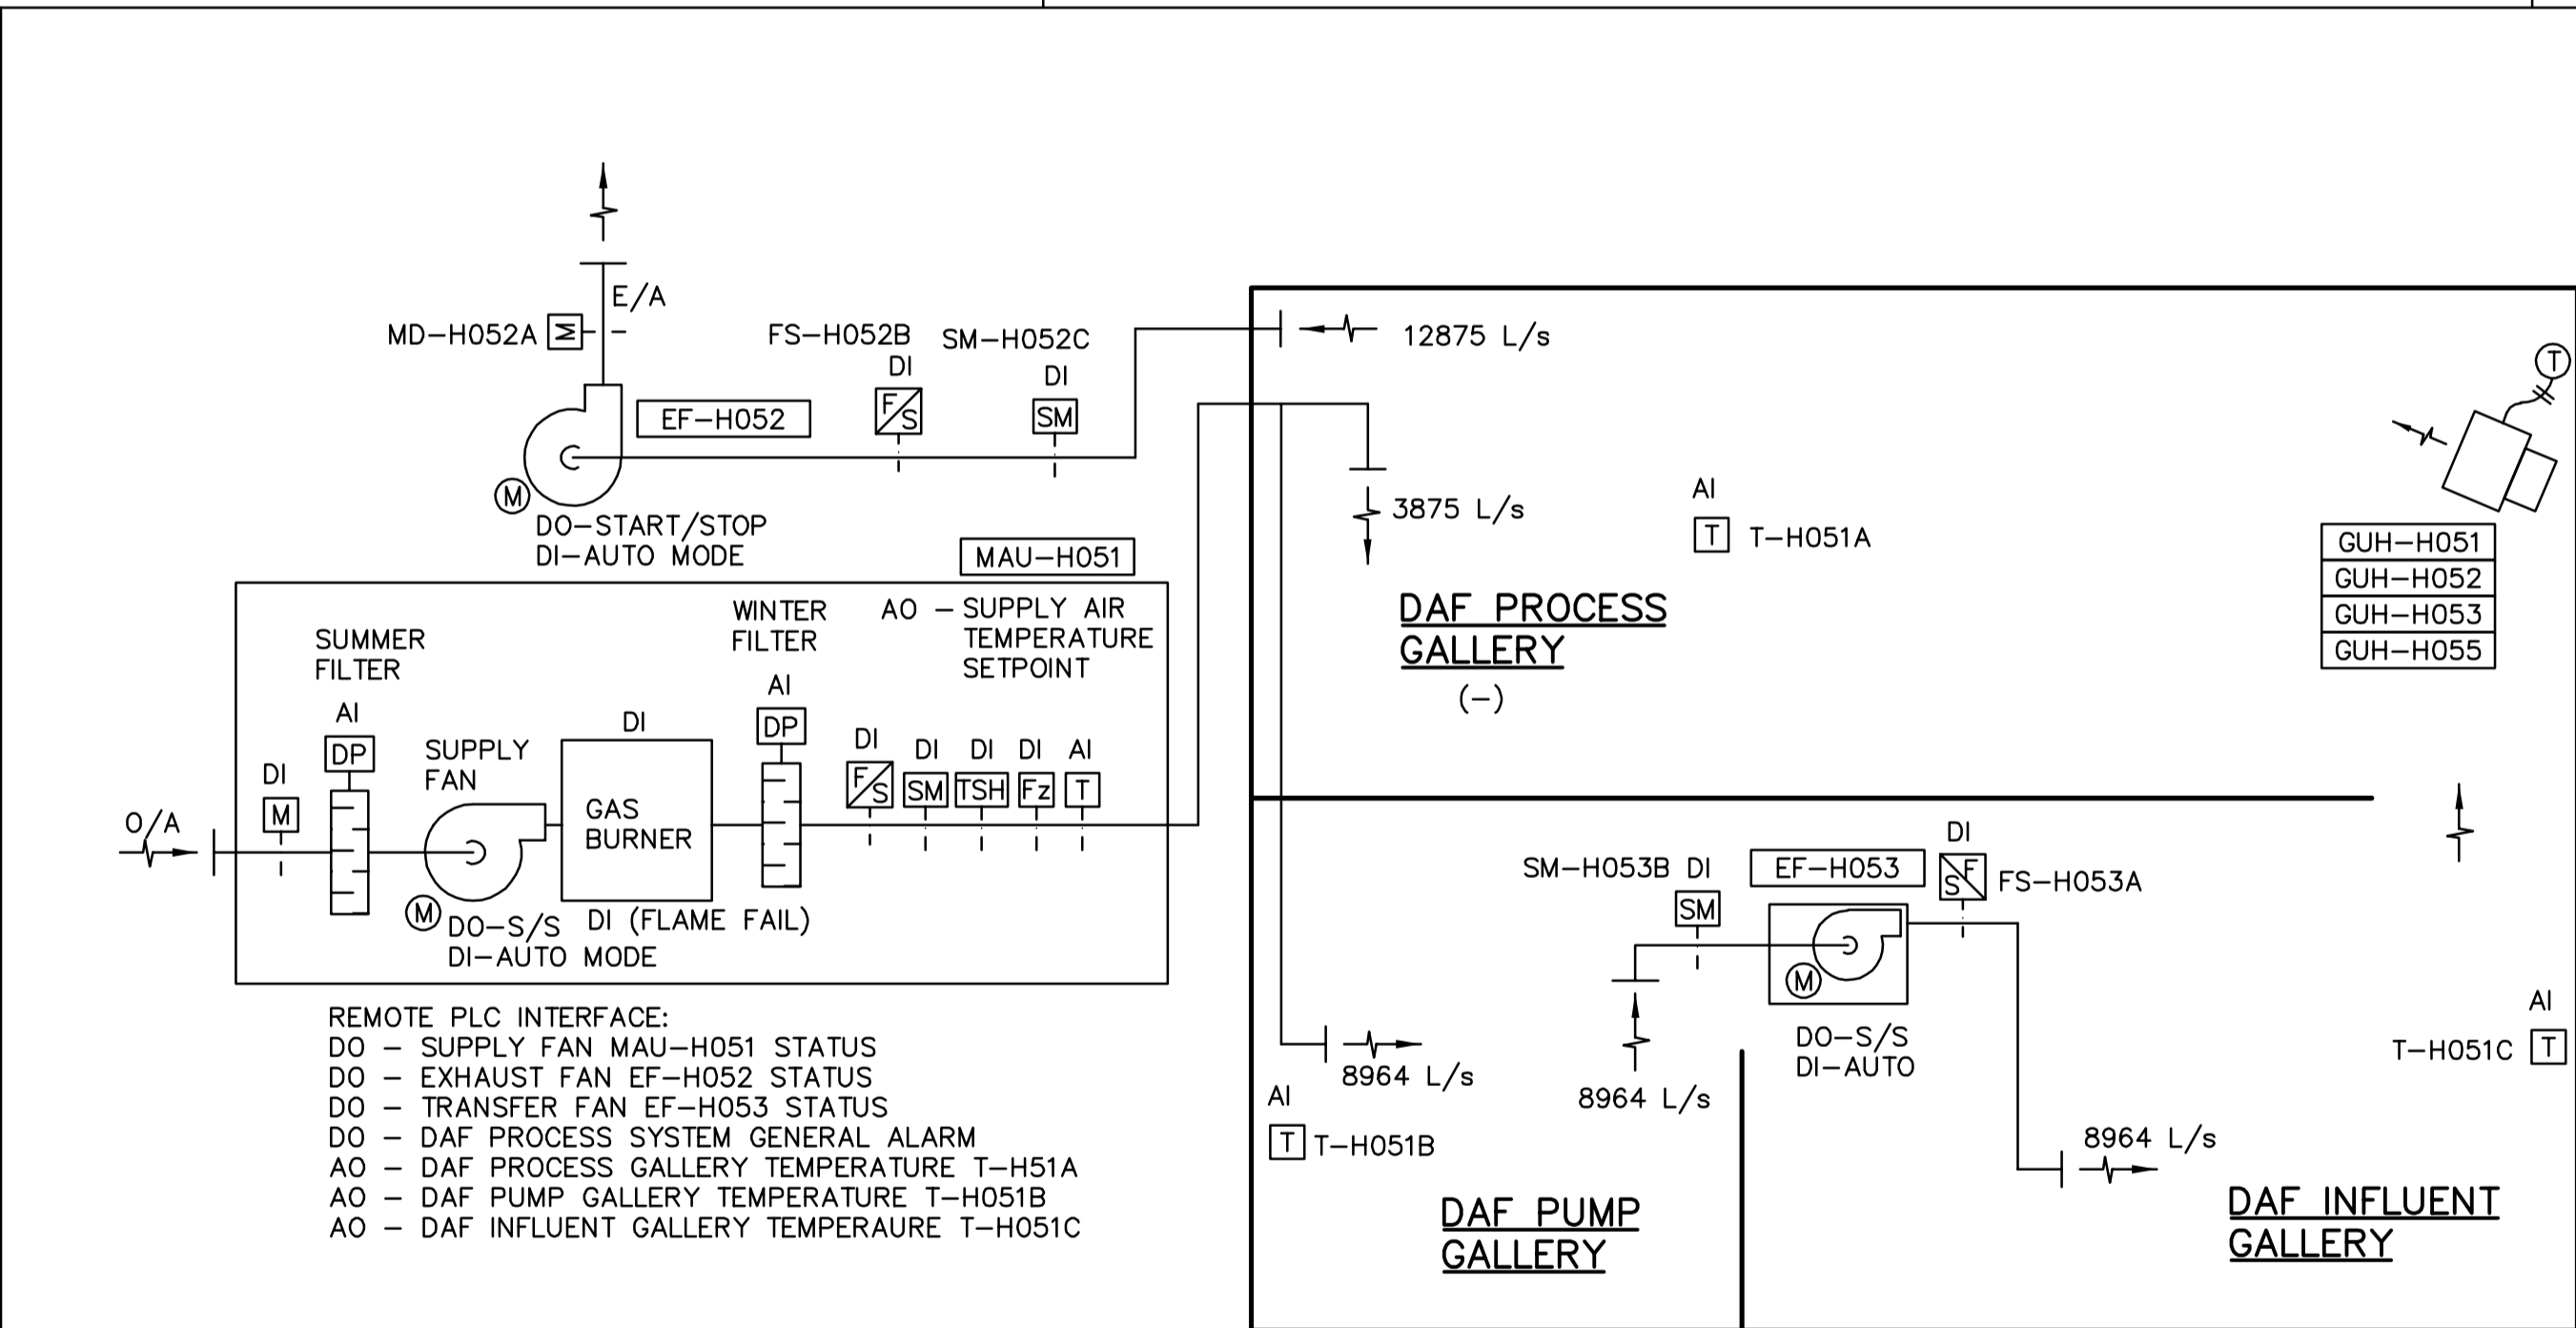

DAF GALLERIES HEATING AND VENTILATION SYSTEM

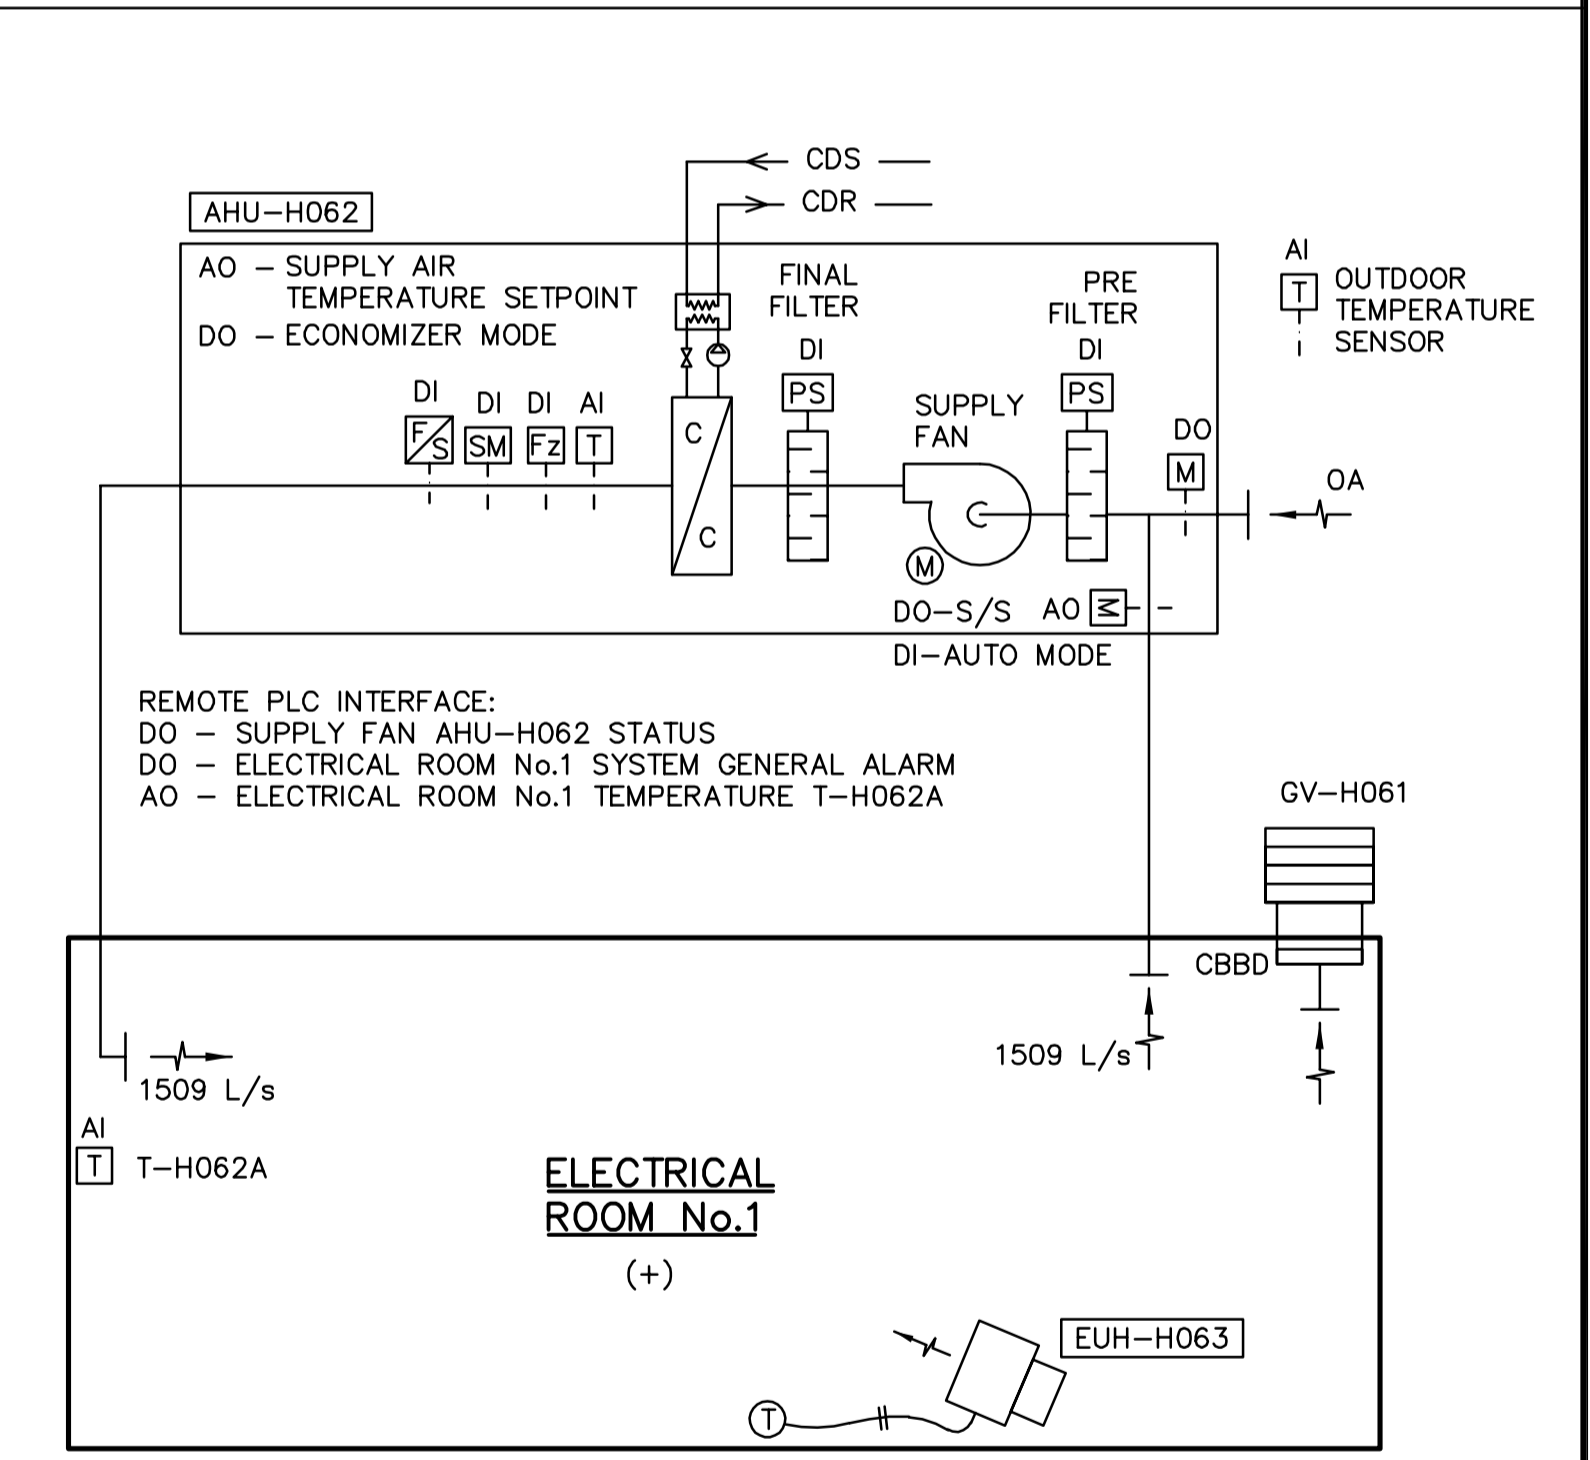

ELECTRICAL ROOM No.1 HEATING AND VENTILATION SYSTEM

GEN NOTE:
 THESE DIAGRAMS ARE TO BE READ IN CONJUNCTION WITH CONTROL SEQUENCES DESCRIBED IN SECTION 15900 OF SPECIFICATIONS.



| NO. | REVISIONS | DATE | BY |
|-----|---------------------|----------|----|
| 01 | 742-2005 ADDENDUM 5 | 06/05/19 | TT |
| 00 | ISSUED FOR TENDER | 06/03/29 | TT |

| | | | |
|------------------------------------|------------|--------------------------------------|---------------|
| Frederickson Cooper ARCHITECTS | | A Yeo International Ltd. Company | |
| DESIGNED BY | TT | CHECKED BY | DL |
| DRAWN BY | AM | APPROVED BY | AHL |
| SCALE: | NTS | RELEASED FOR CONSTRUCTION BY: | R. SOROKOWSKI |
| DATE | 2005/07/04 | DATE | 2006/03/29 |

ENGINEER'S SEAL
 ORIGINAL SIGNED BY
 D.K. CUDDINGTON
 2006/03/29
 CONSULTANT DRAWING NO.
 WB-H0503

THE CITY OF WINNIPEG
 WATER AND WASTE DEPARTMENT
 ENGINEERING DIVISION

WATER TREATMENT PLANT
 MAIN BUILDING
 MECHANICAL AND ELECTRICAL

HVAC
 SCHEMATIC

CITY FILE NUMBER
 SHEET OF
 CITY DRAWING NUMBER
 1-0601B-G-H0503-001-01D