SHEET: COW-A1 (05/2005)

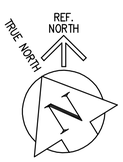

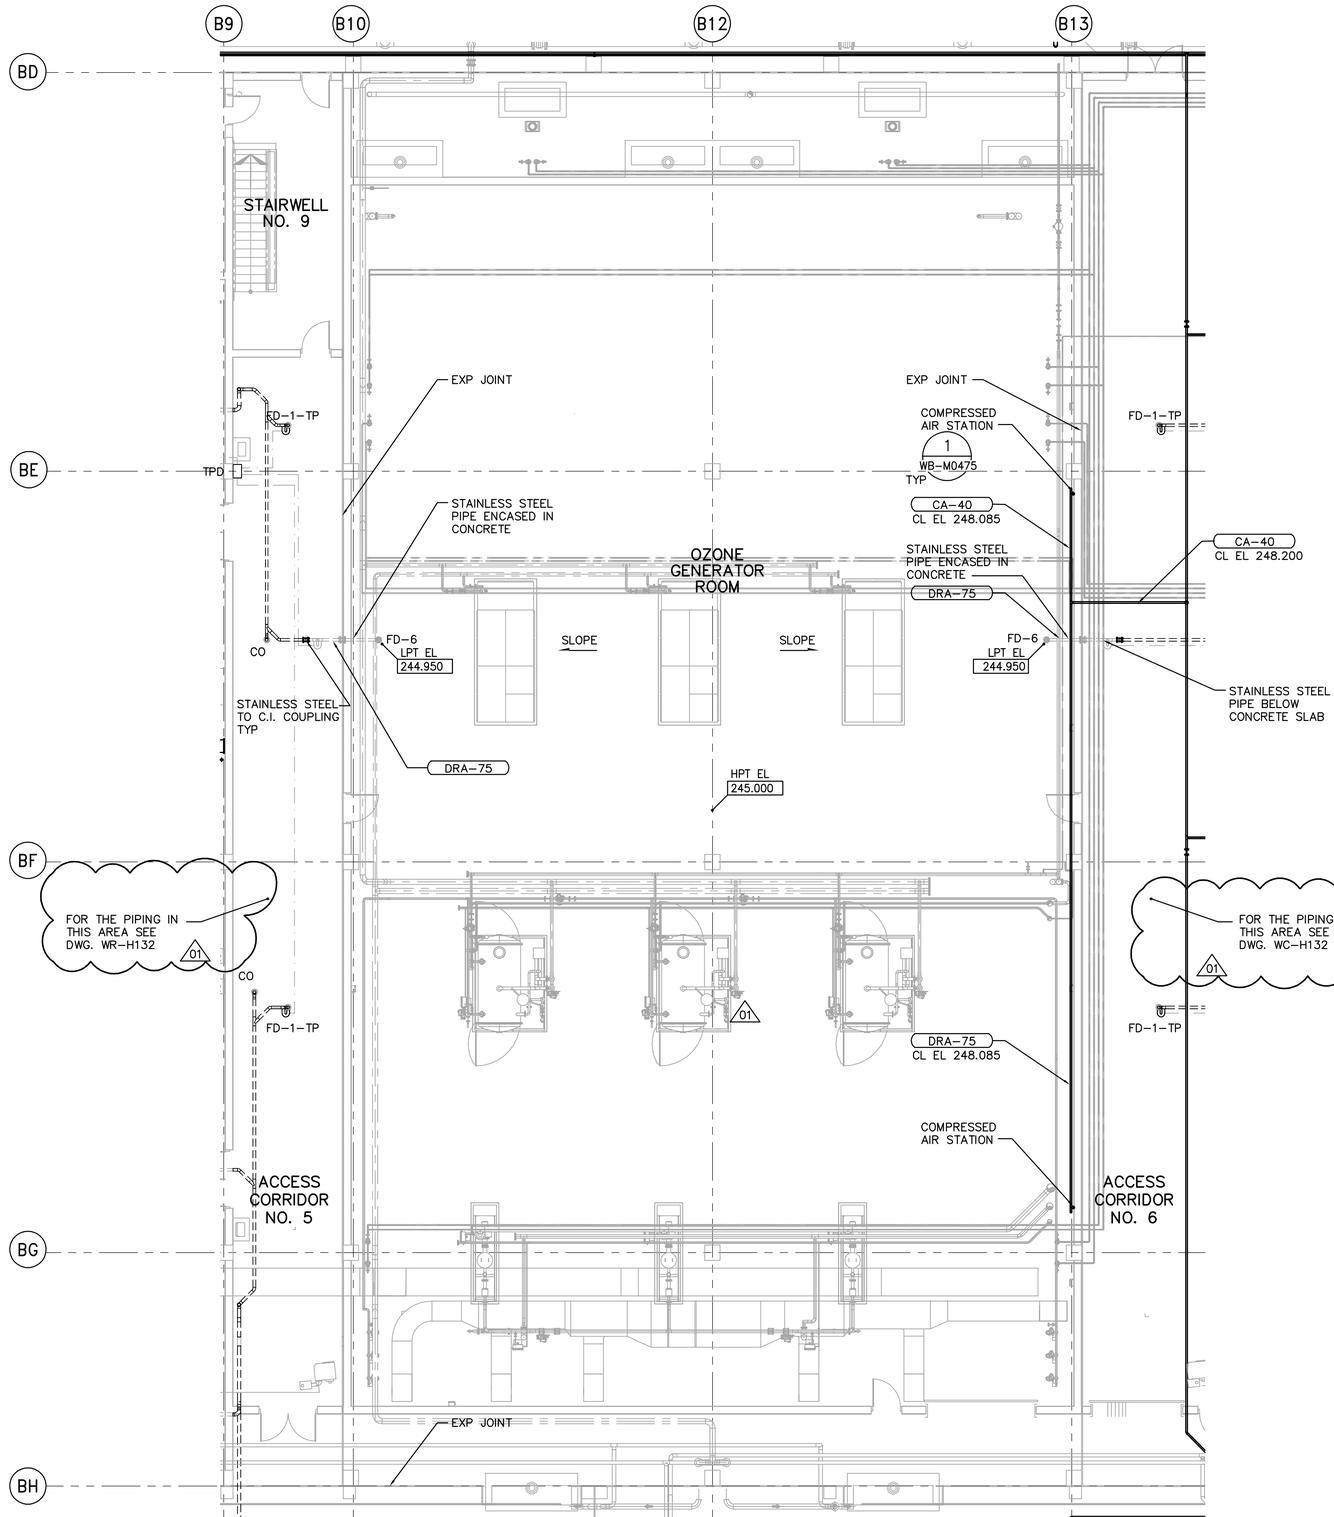

THIRD FLOOR PLAN
1:100

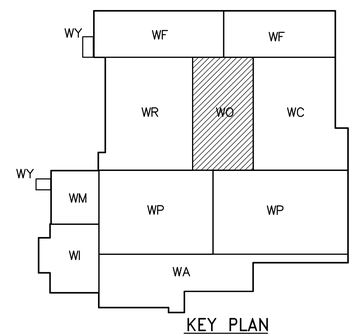

KEY PLAN

SCALE 1:100 METRES 0 2 4 6 8 10

SCALE 1:1 MILLIMETRES 0 20 40 60 80 100

APEGM
Certificate of Authorization
CH2M HILL Canada Ltd.
No. 1441 Expiry: April 30, 2007

NO.	REVISIONS	DATE	BY
01	742-2005 ADDENDUM 5	06/05/19	SW
00	ISSUED FOR TENDER	06/03/29	SW

B.M. ELEV.

CH2MHILL
Fredericksen Cooper ARCHITECTS
EarthTech A Tyco International Ltd. Company

DESIGNED BY	JZ/SW	CHECKED BY	DL
DRAWN BY	JMcP	APPROVED BY	AHL
SCALE:	1:100	RELEASED FOR CONSTRUCTION BY:	R. SOROKOWSKI
DATE	2005/08/02	DATE	2006/03/29

ENGINEER'S SEAL
ORIGINAL SIGNED BY
D.K. CUDDINGTON
2006/03/29

CONSULTANT DRAWING NO.
WO-H0132

Winnipeg
THE CITY OF WINNIPEG
WATER AND WASTE DEPARTMENT
ENGINEERING DIVISION

WATER TREATMENT PLANT
OZONE
MECHANICAL AND ELECTRICAL

PLUMBING
OZONATION AREA
THIRD FLOOR PLAN

CITY FILE NUMBER
SHEET OF
CITY DRAWING NUMBER
1-06010-A-H0132-001-01D

Last Save: 2006-05-15 4:26 PM

C:\DOCUMENTS AND SETTINGS\SEVERITT\MY DOCUMENTS\NDMPROJ\321352 - WINNIPEGWTP\DN_WO-H0132_CH2M.DWG