SHEET: COW-A1 (05/2005)

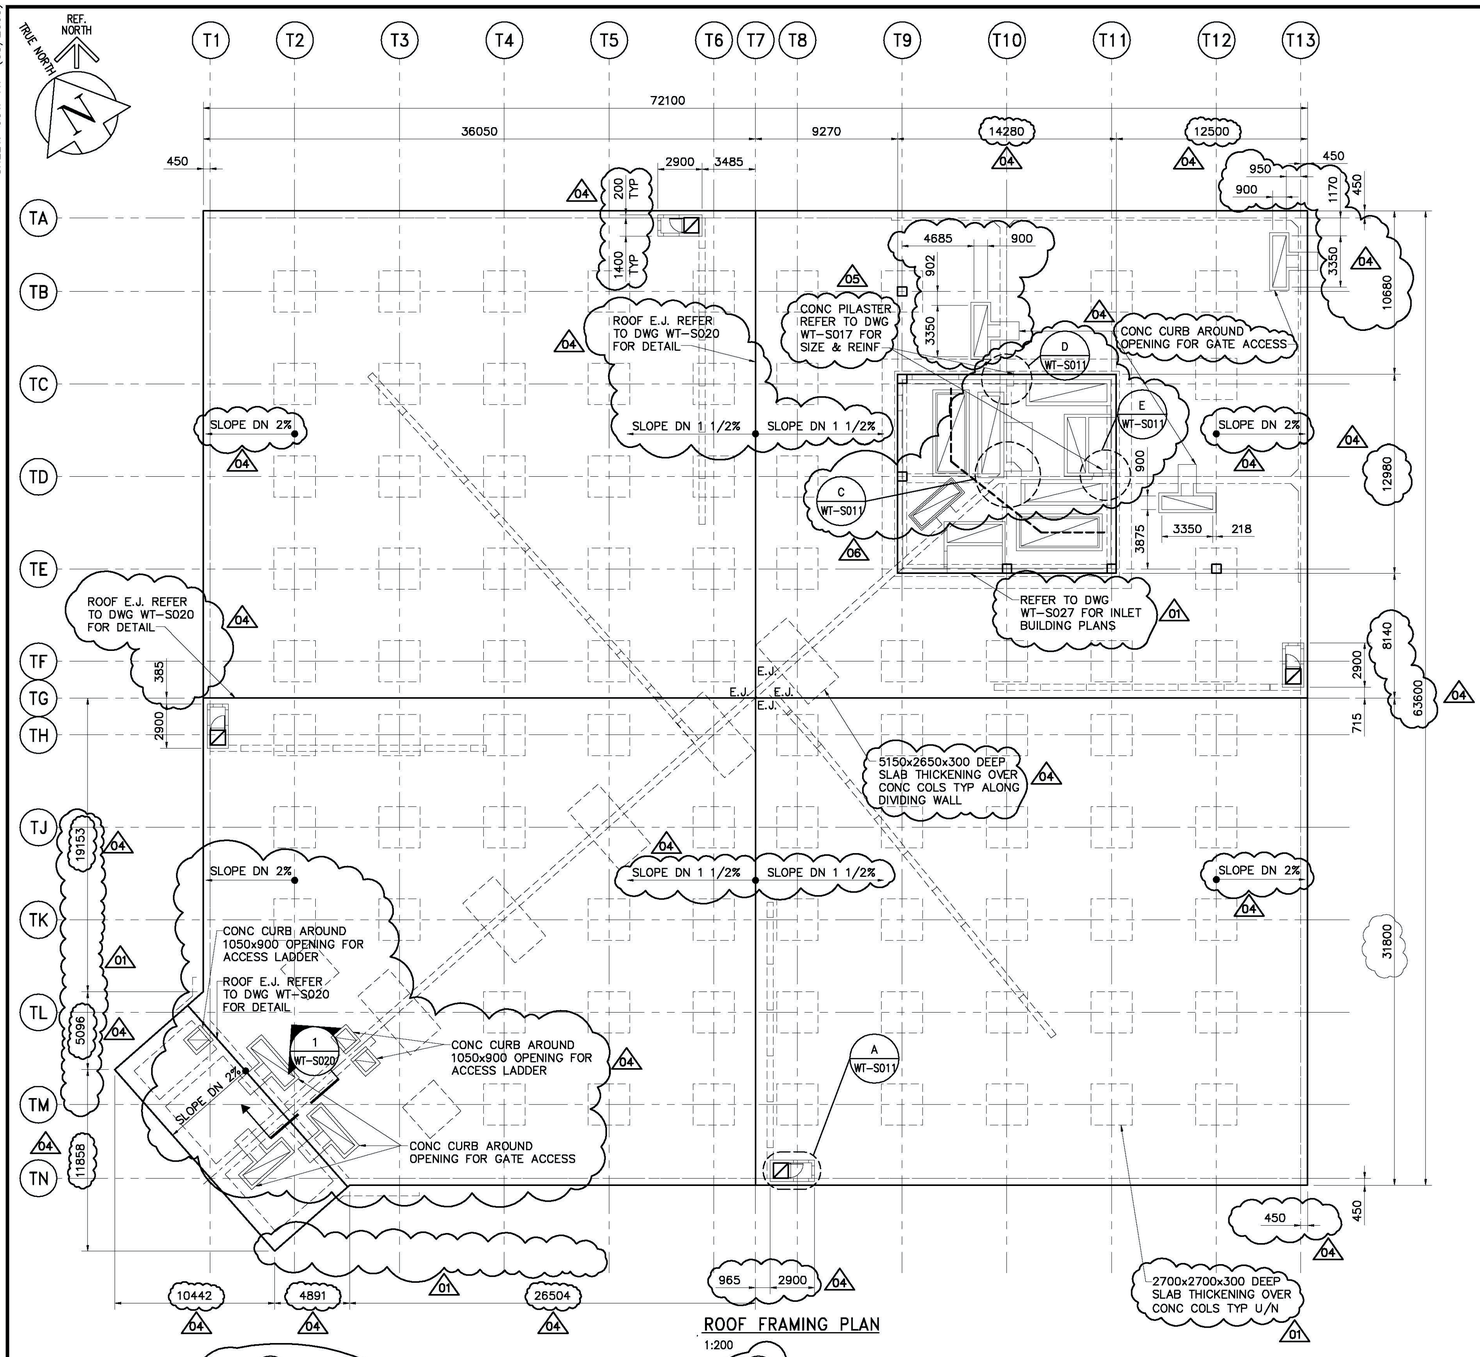

ROOF FRAMING PLAN
1:200

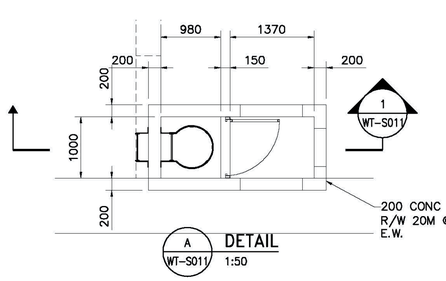

A WT-S011 DETAIL 1:50

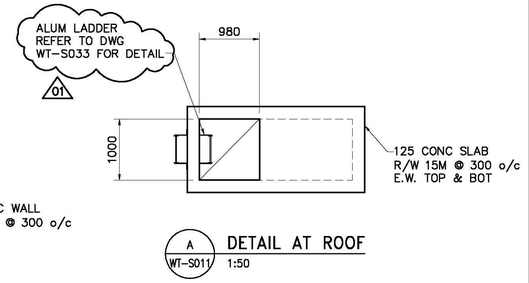

A WT-S011 DETAIL AT ROOF 1:50

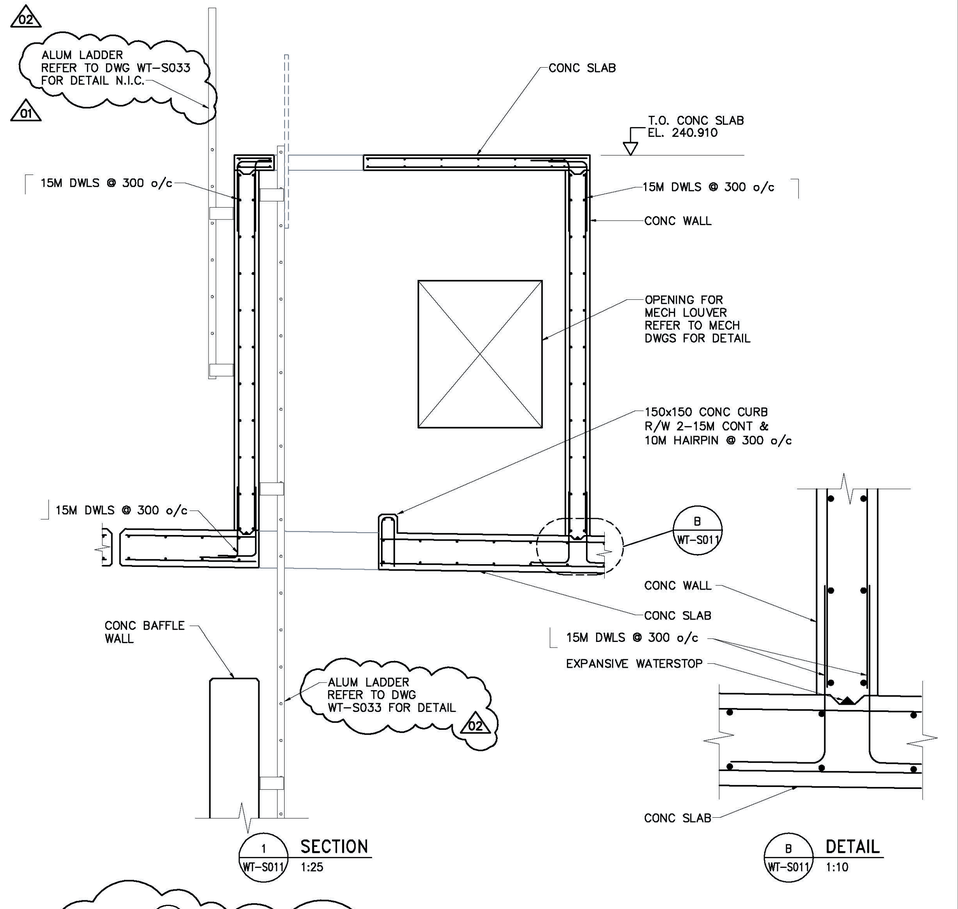

1 WT-S011 SECTION 1:25

B WT-S011 DETAIL 1:10

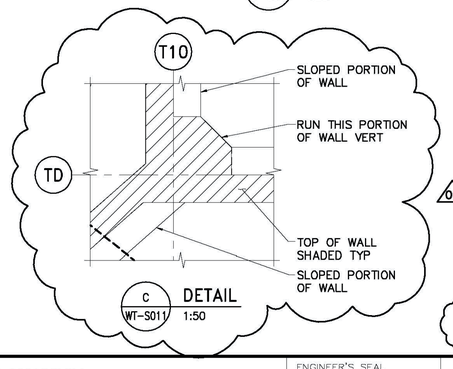

C WT-S011 DETAIL 1:50

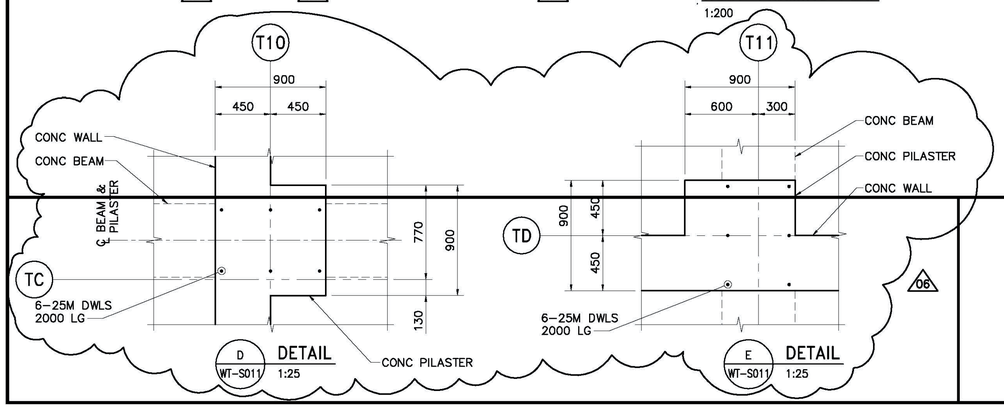

D WT-S011 DETAIL 1:25

E WT-S011 DETAIL 1:25

APEGM
Certificate of Authorization
Earth Tech Canada Inc.
No. 730 Expiry: April 30, 2006

INFORMATION ONLY

01
DRAWING NOTES:
1. REFER TO DRAWING WT-S033 FOR TYPICAL REINFORCING AROUND OPENINGS.

B.M.
ELEV.

NO.	REVISIONS	DATE	BY
06	GENERAL REVISIONS	05/09/13	C.T.
05	GENERAL REVISIONS	05/09/02	C.T.
04	GENERAL REVISIONS	05/07/25	C.T.
03	ISSUED FOR CONSTRUCTION	05/06/08	C.T.
02	166-2005 ADDENDUM 2	05/05/12	C.T.
01	166-2005 ADDENDUM 1	05/05/06	C.T.
00	ISSUED FOR TENDER	05/04/17	C.T.

CH2MHILL
Fredericksen Cooper ARCHITECTS
EarthTech A Tyco International Ltd. Company

DESIGNED BY	FK	CHECKED BY	MK
DRAWN BY	C.T.	APPROVED BY	AHL
SCALE:	AS NOTED	RELEASED FOR CONSTRUCTION BY:	R. SOROKOWSKI
DATE	2005/03/09	DATE	2005-04-17

ENGINEER'S SEAL
ORIGINAL SIGNED BY
F.A. KEMP
2005/04/17

CONSULTANT DRAWING NO.
WT-S011

Winnipeg
THE CITY OF WINNIPEG
WATER AND WASTE DEPARTMENT
ENGINEERING DIVISION

WATER TREATMENT PLANT

STRUCTURAL
ROOF FRAMING PLAN

CITY FILE NUMBER
SHEET OF
CITY DRAWING NUMBER
1-0601T-A-S0011-001-06D