


**J** DETAIL  
WT-S015 1:25

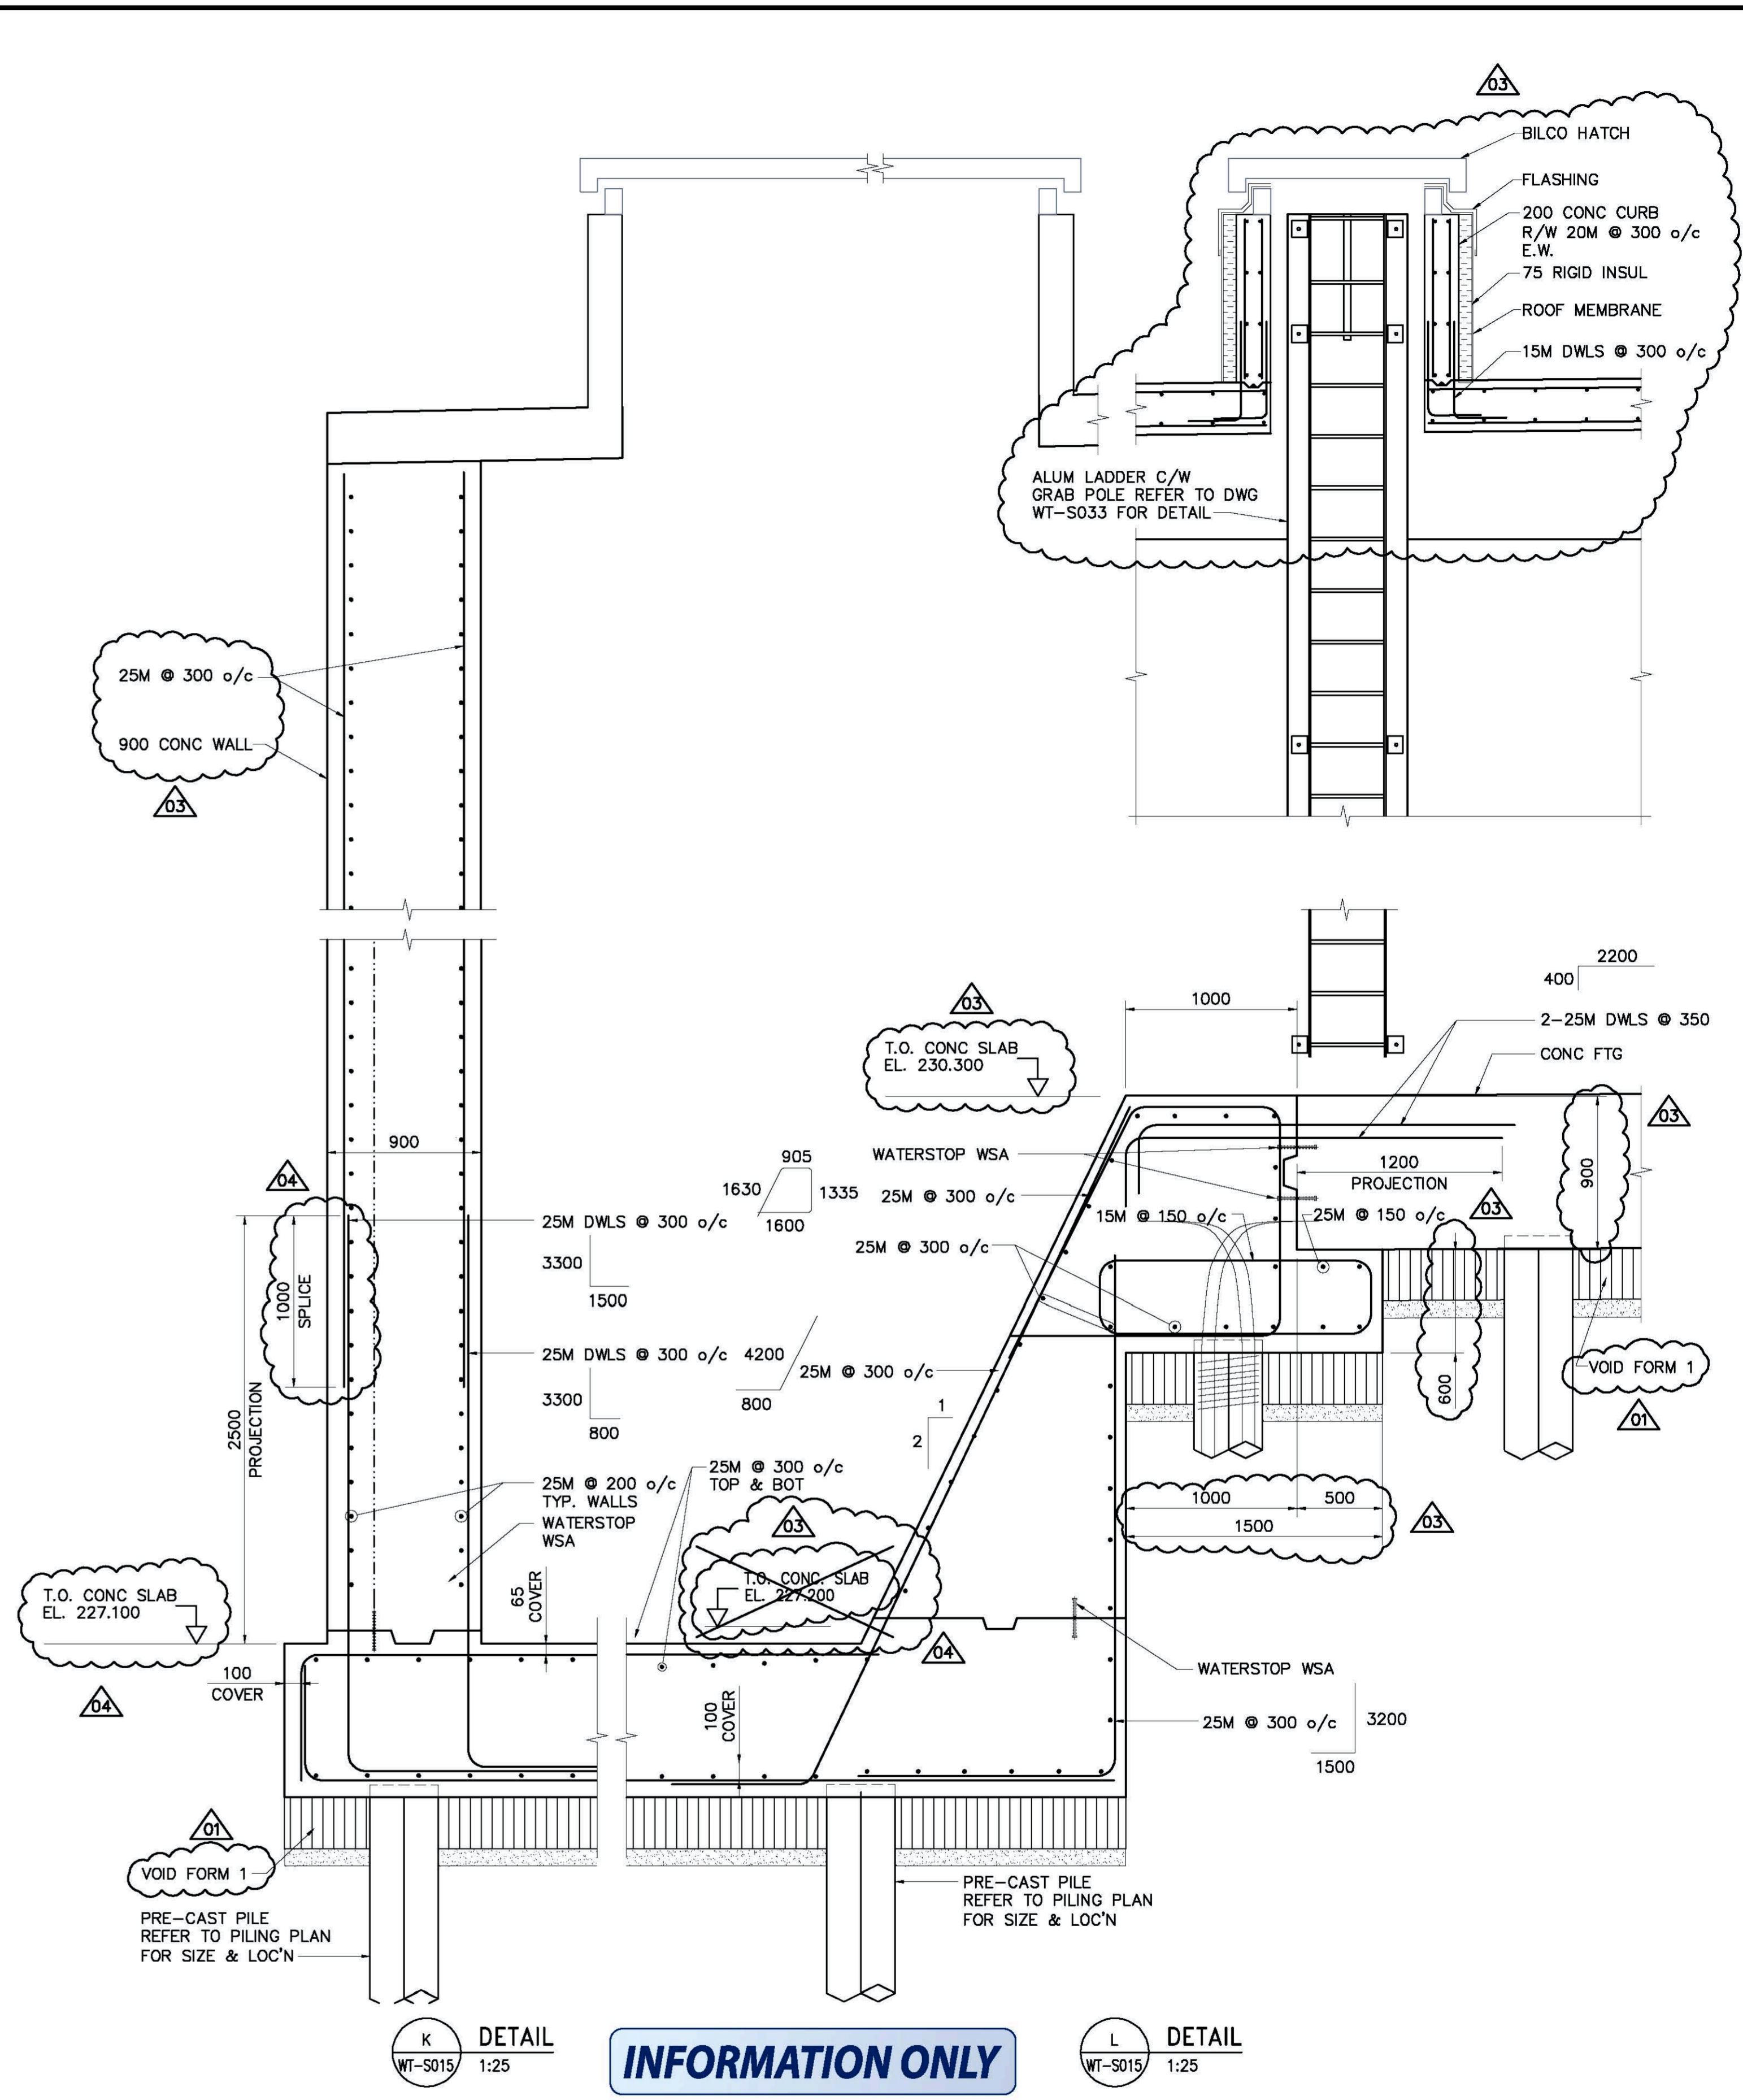

**K** DETAIL  
WT-S015 1:25

**L** DETAIL  
WT-S015 1:25

**INFORMATION ONLY**

DRAWING NOTES:  
1. REFER TO DRAWING WT-S001 FOR GENERAL NOTES.

**APEGM**  
Certificate of Authorization  
Earth Tech Canada Inc.  
No. 730 Expiry: April 30, 2006

NO.	REVISIONS	DATE	BY	DATE	2005/03/16	DATE	2005-04-17
04	OUTLET FLOOR LOWERED 100	05/09/13	C.T.				
03	GENERAL REVISIONS	05/07/25	C.T.				
02	ISSUED FOR CONSTRUCTION	05/06/09	C.T.				
01	166-2005 ADDENDUM 1	05/05/06	C.T.				
00	ISSUED FOR TENDER	05/04/17	C.T.				

**CH2MHILL**  
**Frederick Cooper ARCHITECTS**

DESIGNED BY: FK  
CHECKED BY: MK  
DRAWN BY: C.T. / WDB  
APPROVED BY: AHL  
SCALE: AS NOTED  
RELEASED FOR CONSTRUCTION BY: R. SOROKOWSKI

**EarthTech**  
A Tyco International Ltd. Company

ENGINEER'S SEAL  
ORIGINAL SIGNED BY:  
F.A. KEMP & R.B. ERIC  
2005/04/17  
CONSULTANT DRAWING NO. WT-S018

**THE CITY OF WINNIPEG**  
WATER AND WASTE DEPARTMENT  
ENGINEERING DIVISION

WATER TREATMENT PLANT

STRUCTURAL SECTIONS AND DETAILS

CITY FILE NUMBER  
SHEET OF  
CITY DRAWING NUMBER  
1-0601T-A-S0018-001-04D