SHEET: COW-A1 (05/2005)

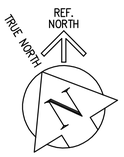

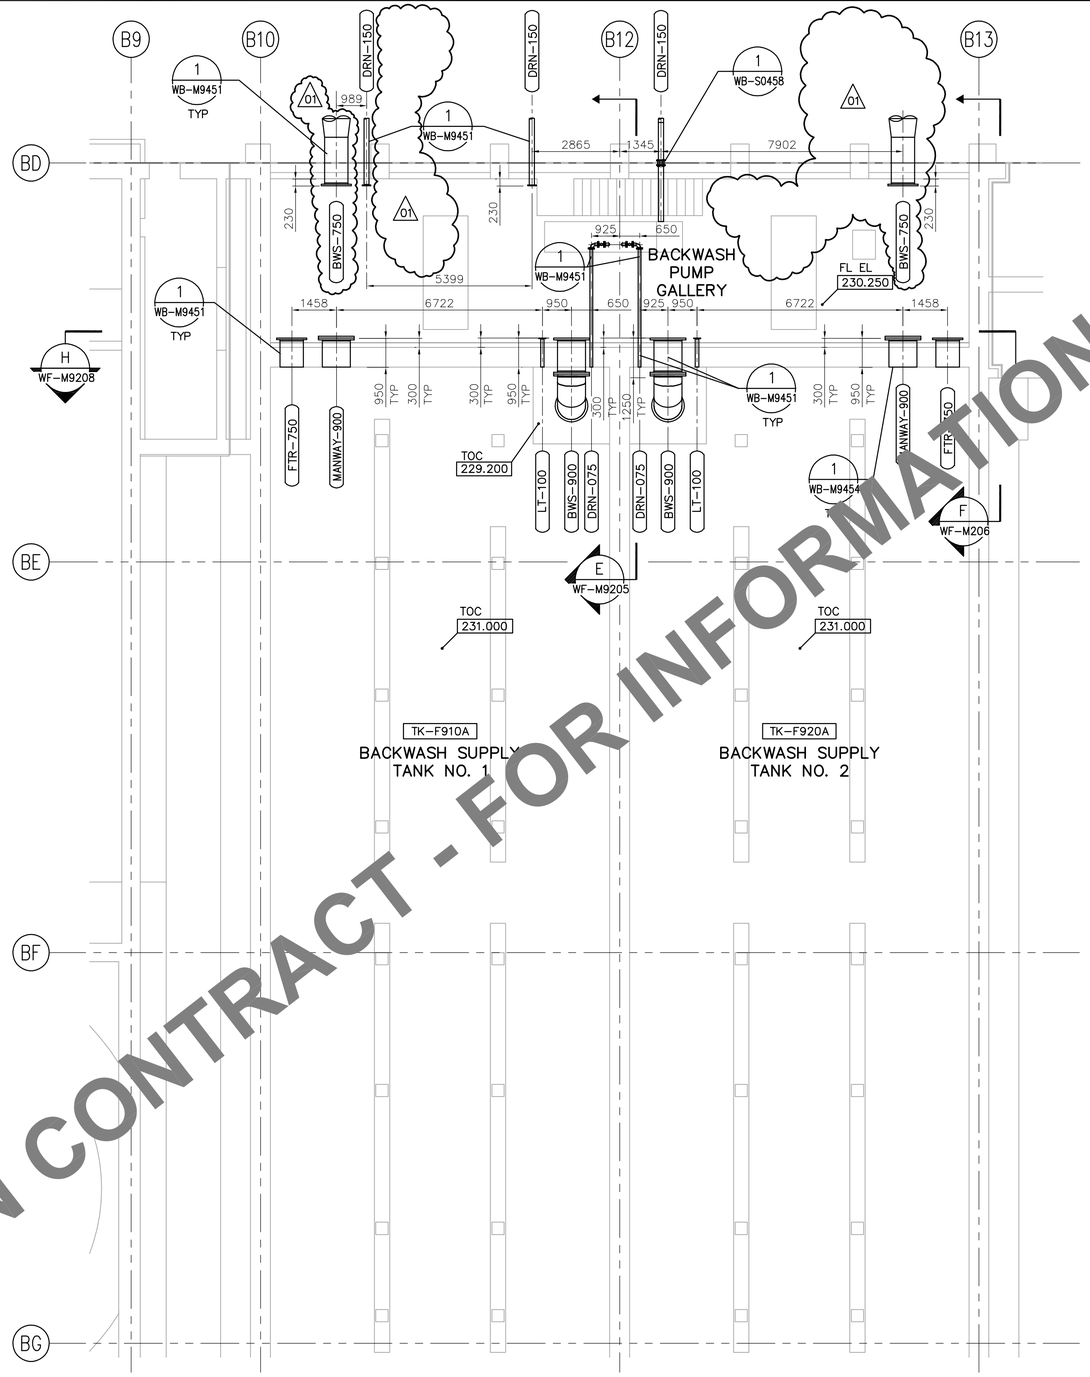

NOT IN CONTRACT - FOR INFORMATION ONLY

PLAN AT ELEVATION 230.250
1:100

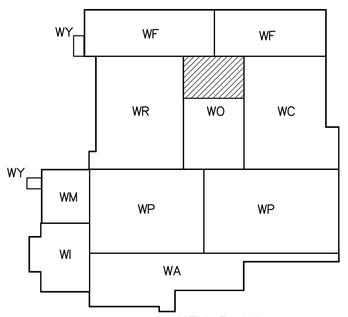

KEY PLAN

SCALE 1:100 METRES 0 2 4 6 8 10

SCALE 1:1 MILLIMETRES 0 20 40 60 80 100

APEGM
Certificate of Authorization
CH2M HILL Canada Ltd.
No. 1441 Expiry: April 30, 2006

B.M.
ELEV.

NO.	REVISIONS	DATE	BY
01	583-2005 ADDENDUM 3	06/03/10	PW
00	ISSUED FOR TENDER	2006/02/03	PW

CH2MHILL
Fredericksen Cooper ARCHITECTS
EarthTech A Tyco International Ltd. Company

DESIGNED BY	TB/PW	CHECKED BY	LS
DRAWN BY	TAR/EK	APPROVED BY	DJT
SCALE:	1:100	RELEASED FOR CONSTRUCTION BY:	R. SOROKOWSKI
DATE	2005/07/08	DATE	2006/02/08

ENGINEER'S SEAL
ORIGINAL SIGNED BY
P. WOBMA
2006/02/06

CONSULTANT DRAWING NO.
WF-M9103

Winnipeg
THE CITY OF WINNIPEG
WATER AND WASTE DEPARTMENT
ENGINEERING DIVISION

WATER TREATMENT PLANT
FILTRATION
FOUNDATION AND CONCRETE STRUCTURES

PROCESS MECHANICAL
PIPE EMBEDS
FILTRATION AREA 3 LOWER PLAN

CITY FILE NUMBER
SHEET OF
CITY DRAWING NUMBER
1-0601F-A-M9103-001-01D

Last Save: 2006-03-27 4:21 PM

P:\EARTHTECH\321352WINNIPEGWTP\700-DELIVERABLES\710-DRAWINGSPDFS\2006\742-EMBEDS\DN_WF-M9103_CH2M.SCR.DWG