
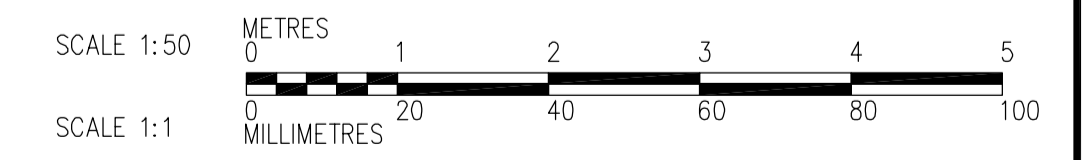


NOT IN CONTRACT - FOR INFORMATION ONLY

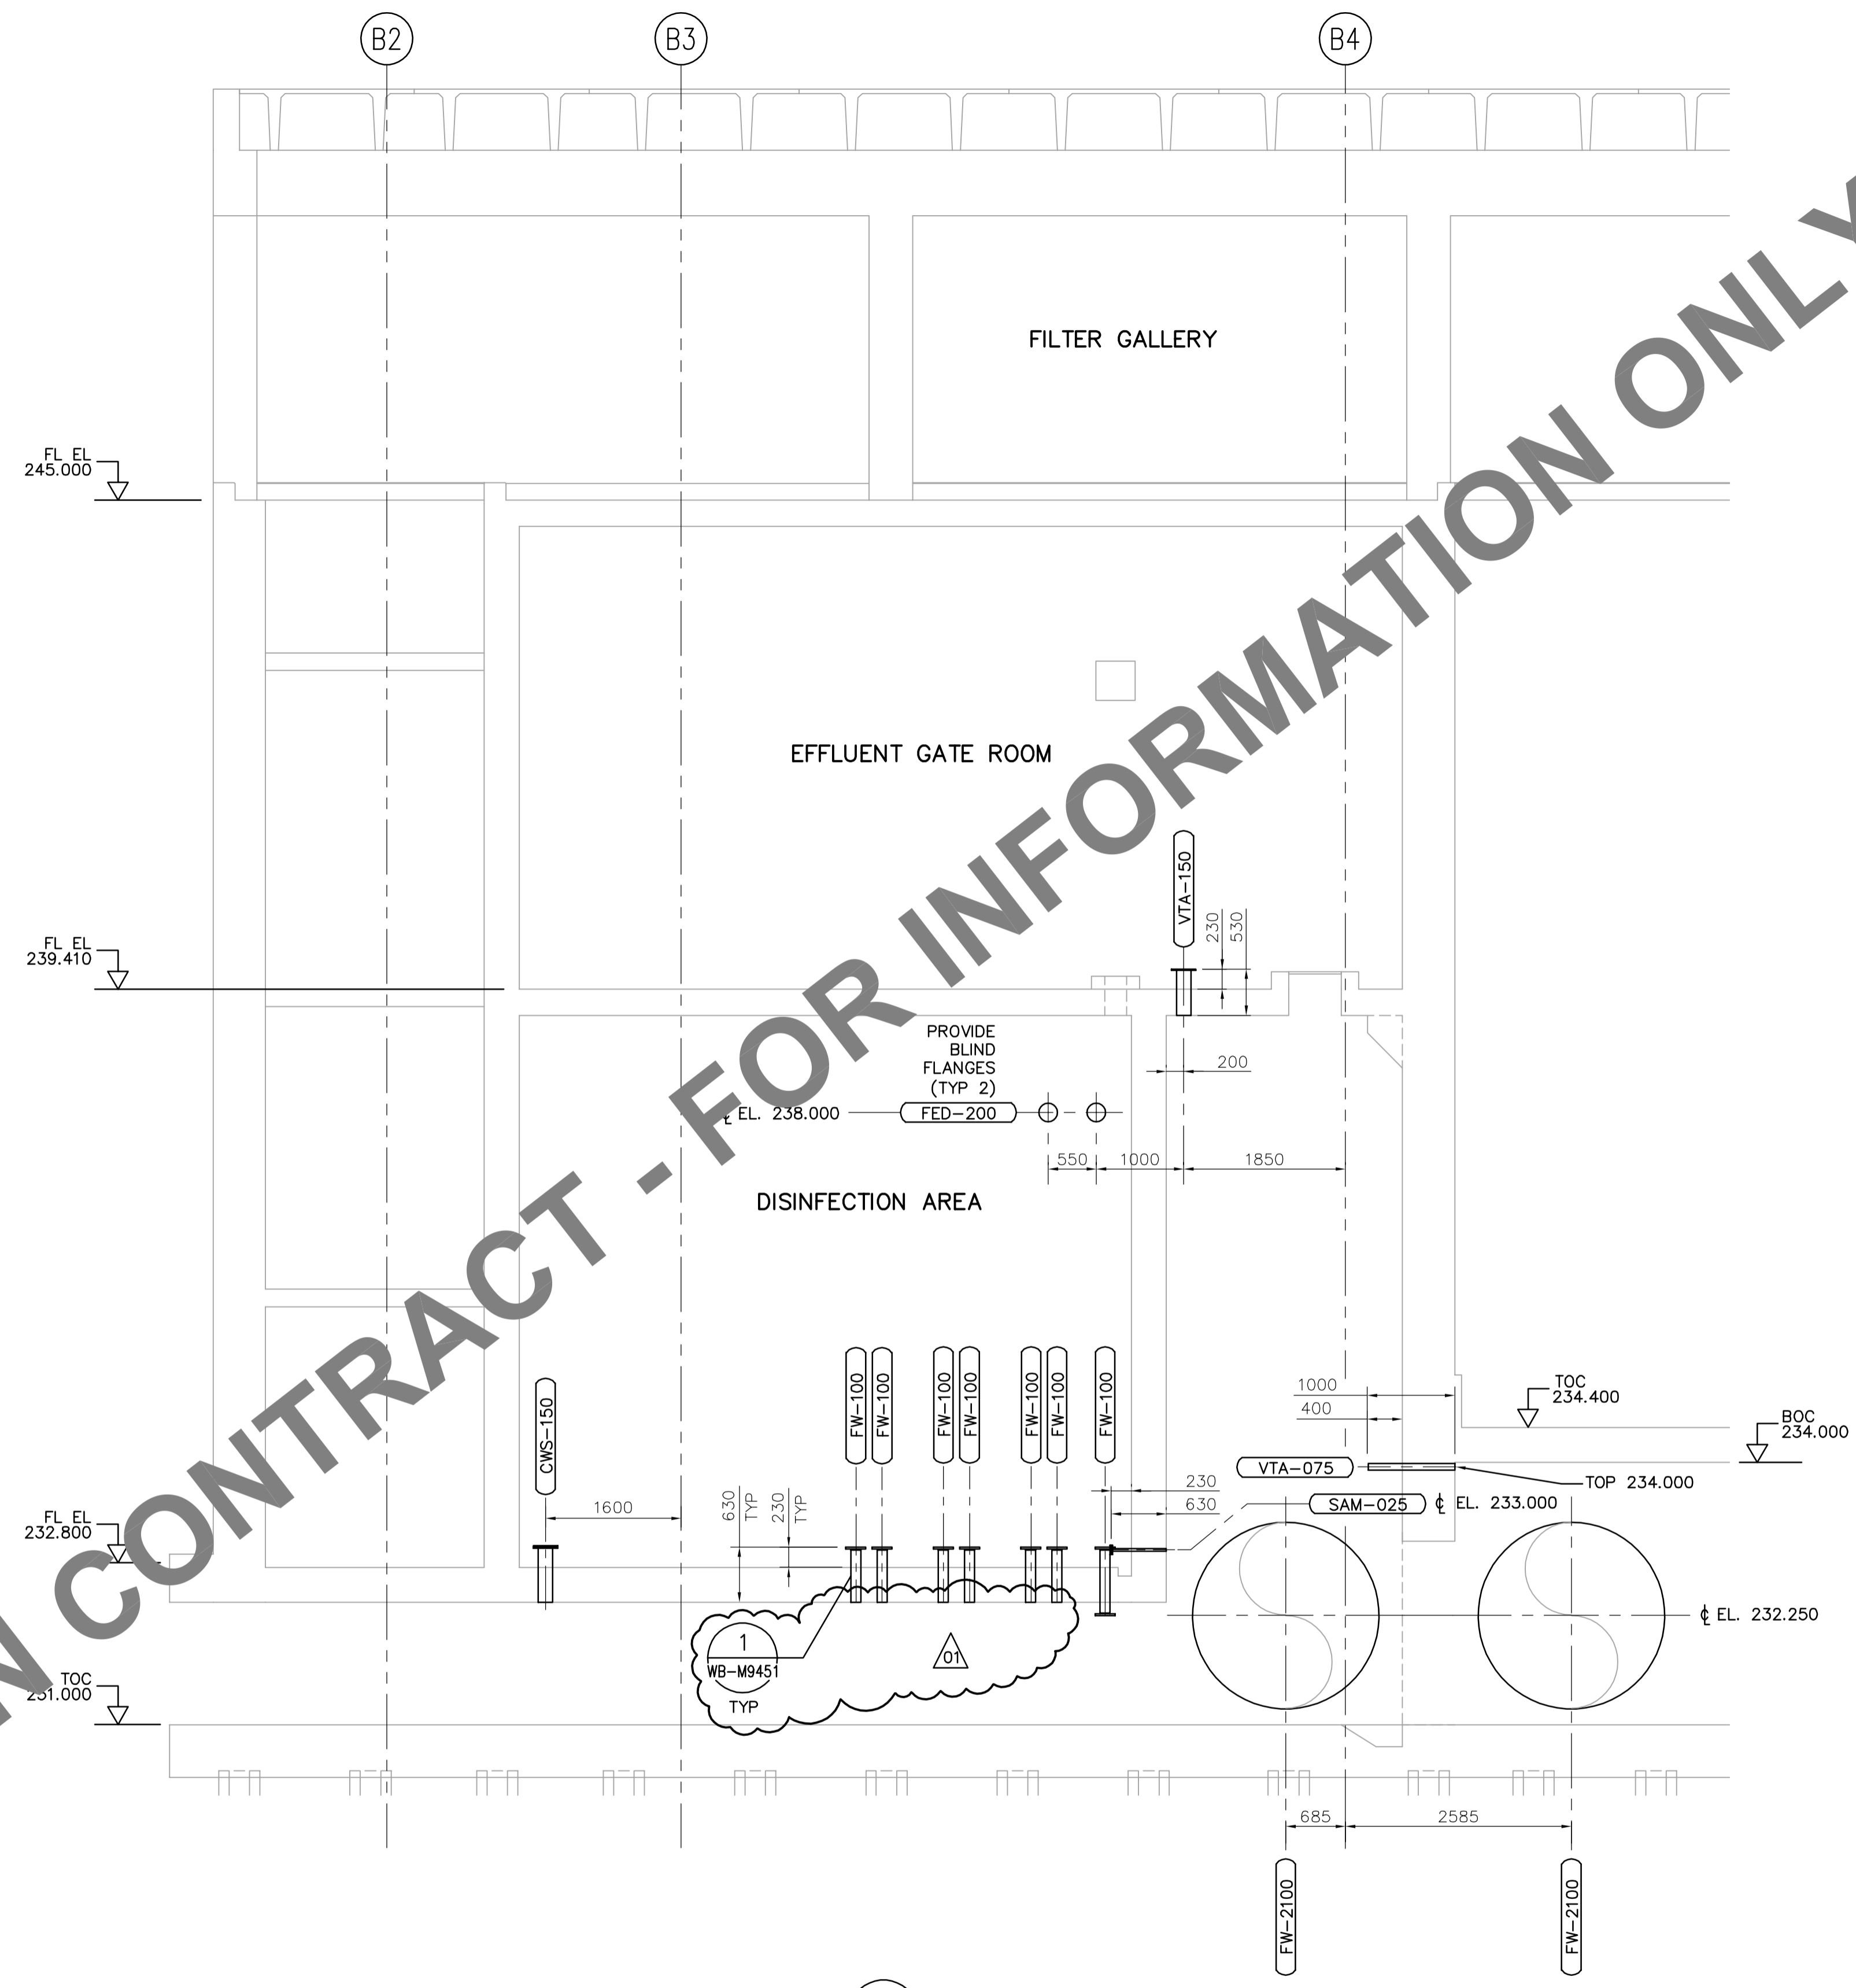

 <b>APEGN</b> Certificate of Authorization CH2M HILL Canada Ltd. No. 1441 Expiry: April 30, 2006	 Frederickson Cooper ARCHITECTS	 A Terra International Ltd. Company	B.M. ELEV.	ENGINEER'S SEAL  ORIGINAL SIGNED BY P. WOBMA 2006/02/06  CONSULTANT DRAWING NO. WF-M9209	 <b>THE CITY OF WINNIPEG</b> WATER AND WASTE DEPARTMENT ENGINEERING DIVISION  WATER TREATMENT PLANT FILTRATION FOUNDATION AND CONCRETE STRUCTURES  PROCESS MECHANICAL PIPE EMBEDS FILTRATION AREA SECTION	CITY FILE NUMBER											
			<table border="1" style="width: 100%; border-collapse: collapse;"> <tr> <td style="width: 25%;">DESIGNED BY</td> <td>TB/PW</td> <td style="width: 25%;">CHECKED BY</td> <td>LS</td> </tr> <tr> <td>DRAWN BY</td> <td>TAR/EK</td> <td>APPROVED BY</td> <td>DJT</td> </tr> <tr> <td colspan="2">SCALE: 1:50</td> <td colspan="2">RELEASED FOR CONSTRUCTION BY: R. SOROKOWSKI</td> </tr> <tr> <td>DATE</td> <td>2005/07/08</td> <td>DATE</td> <td>2006/02/08</td> </tr>
