




R SECTION - SUPERNATANT AND SLUDGE LINES
WP-M9106 1:50

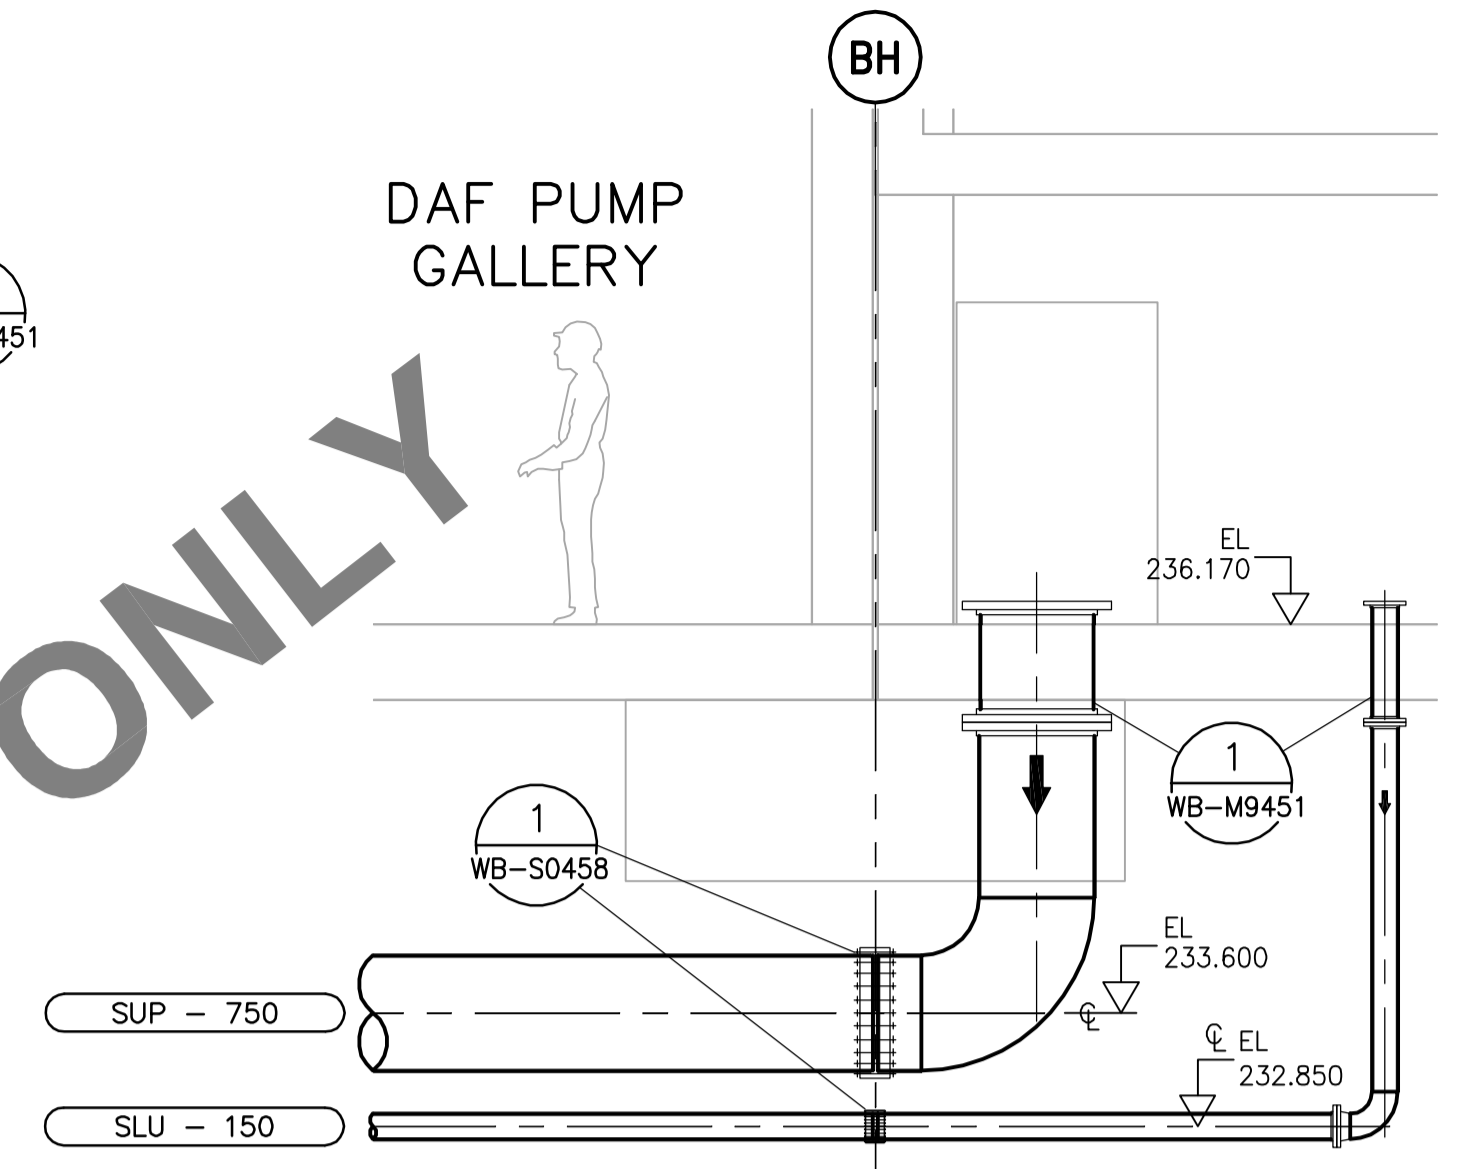


S SECTION - SUPERNATANT AND SLUDGE LINES
WP-M9106 1:50

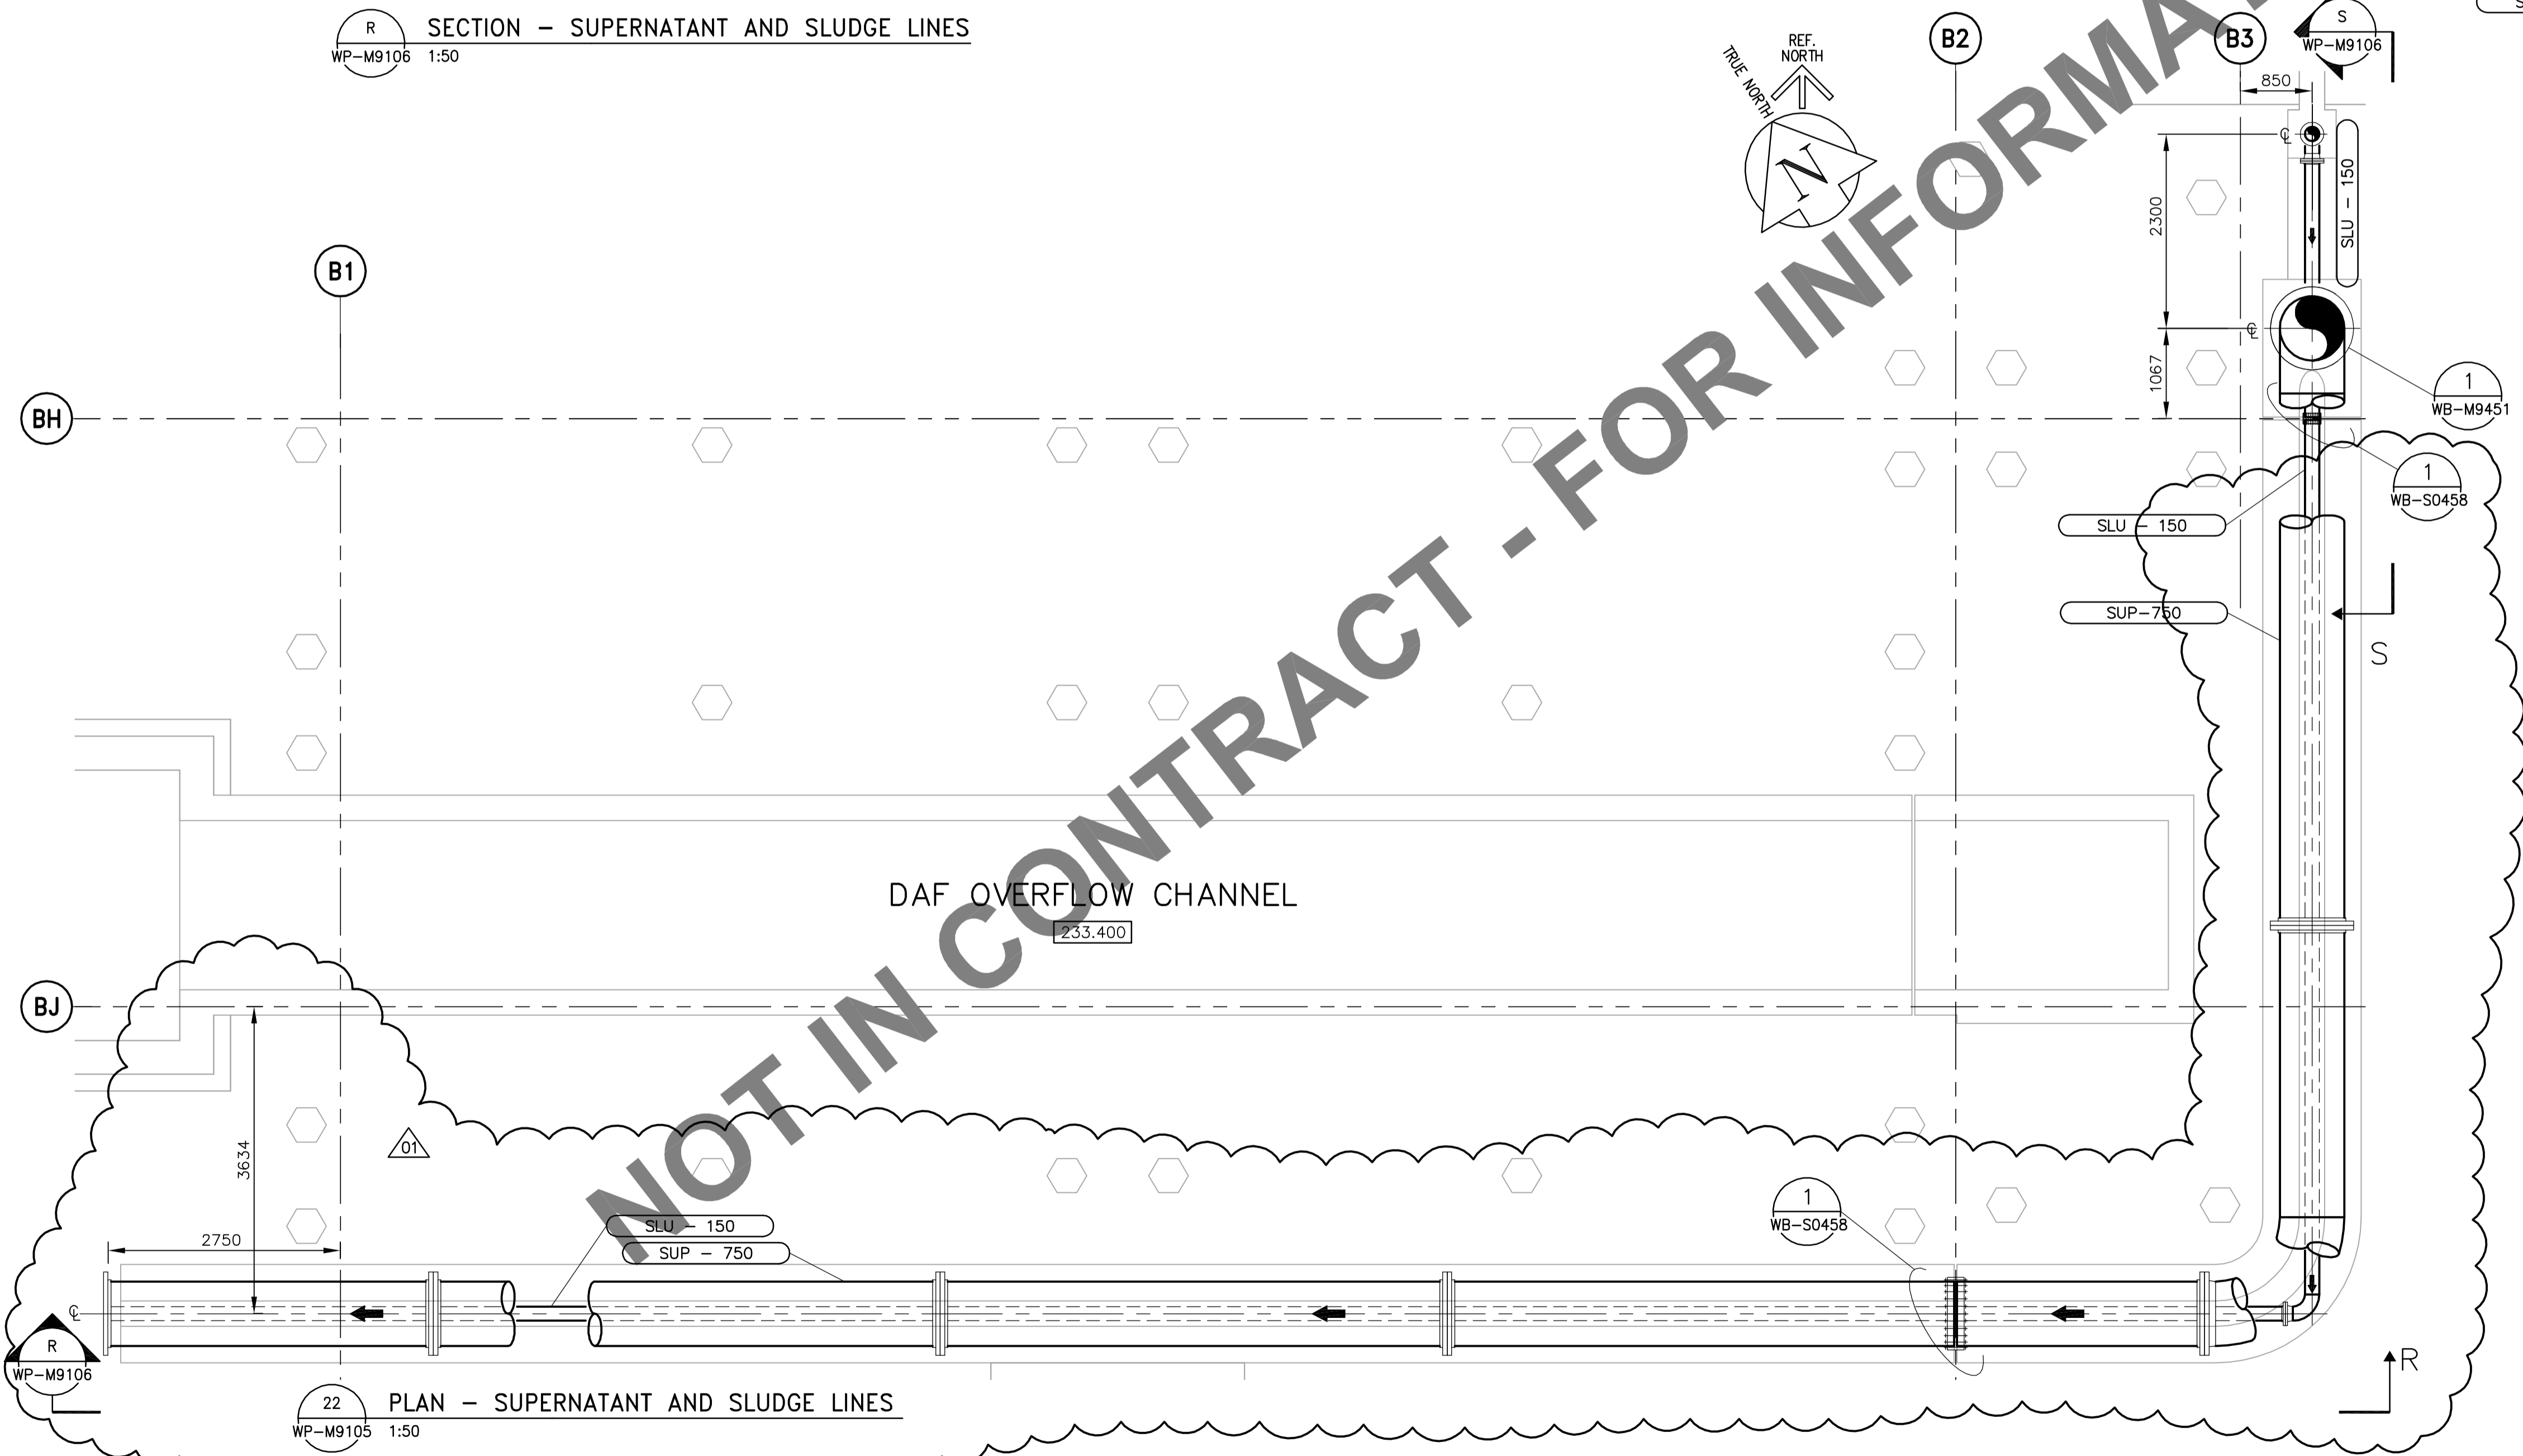

22 PLAN - SUPERNATANT AND SLUDGE LINES
WP-M9105 1:50

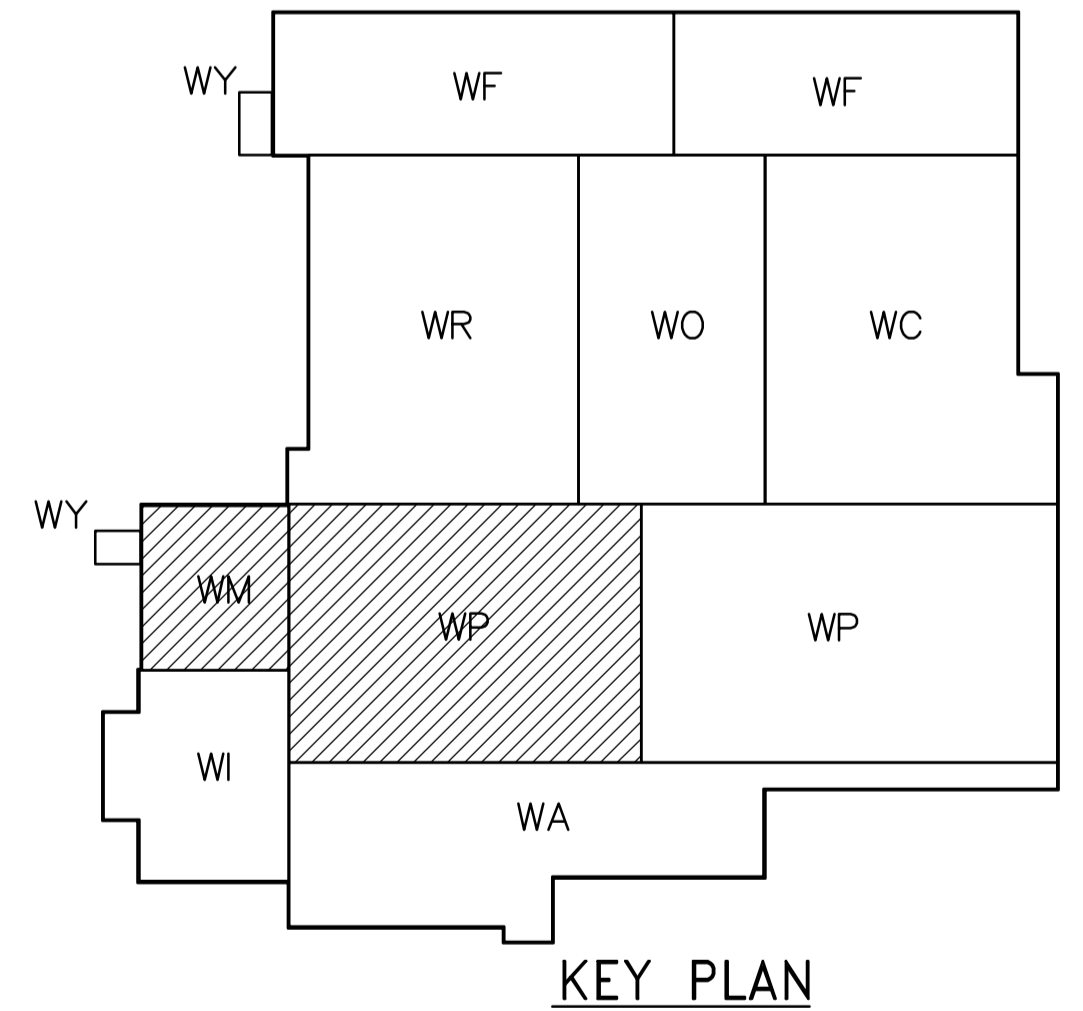

KEY PLAN

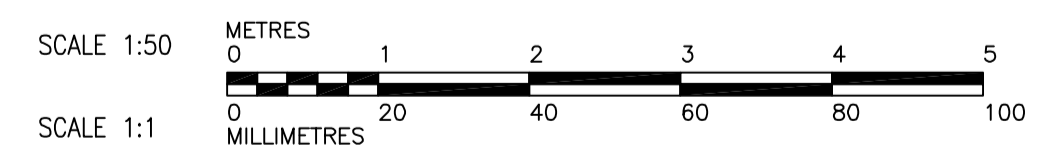

NOT IN CONTRACT - FOR INFORMATION ONLY

<p>APECA Certificate of Authorization Earth Tech Canada Inc. No. 730 Expiry: April 30, 2006</p>	B.M. ELEV.	<p>Frederickson Cooper ARCHITECTS</p>	<p>EarthTech A Tech International Ltd. Company</p>	ENGINEER'S SEAL	<p>THE CITY OF WINNIPEG WATER AND WASTE DEPARTMENT ENGINEERING DIVISION</p>														
	<table border="1" style="width: 100%; border-collapse: collapse;"> <tr> <td>DESIGNED BY</td> <td>KAS</td> <td>CHECKED BY</td> <td>SRB</td> </tr> <tr> <td>DRAWN BY</td> <td>PL</td> <td>APPROVED BY</td> <td>DJT</td> </tr> <tr> <td>SCALE:</td> <td>AS SHOWN</td> <td>RELEASED FOR CONSTRUCTION BY:</td> <td>R. SOROKOWSKI</td> </tr> <tr> <td>DATE</td> <td>2005/11/28</td> <td>DATE</td> <td>2006/02/07</td> </tr>
