


NOTE: CHAINAGES SHOWN ARE ALONG S. R. OF PANDORA AVE. (W)

PANDORA AVENUE (WEST)

SEWER SERVICE INFORMATION		
ADDRESS	SIZE	R. DIST. JUNCTION TIE
1340 PANDORA AVE	1.68 WEL BLDG	
RESIDENTIAL	32.2 E 1ST MH E. REGENT	
1490 PANDORA AVE	5.10 WEL BLDG	
COMMERCIAL	3.10 E 1ST MH E. REGENT	

FOR CONSTRUCTION NOTES SEE DRAWING 05533

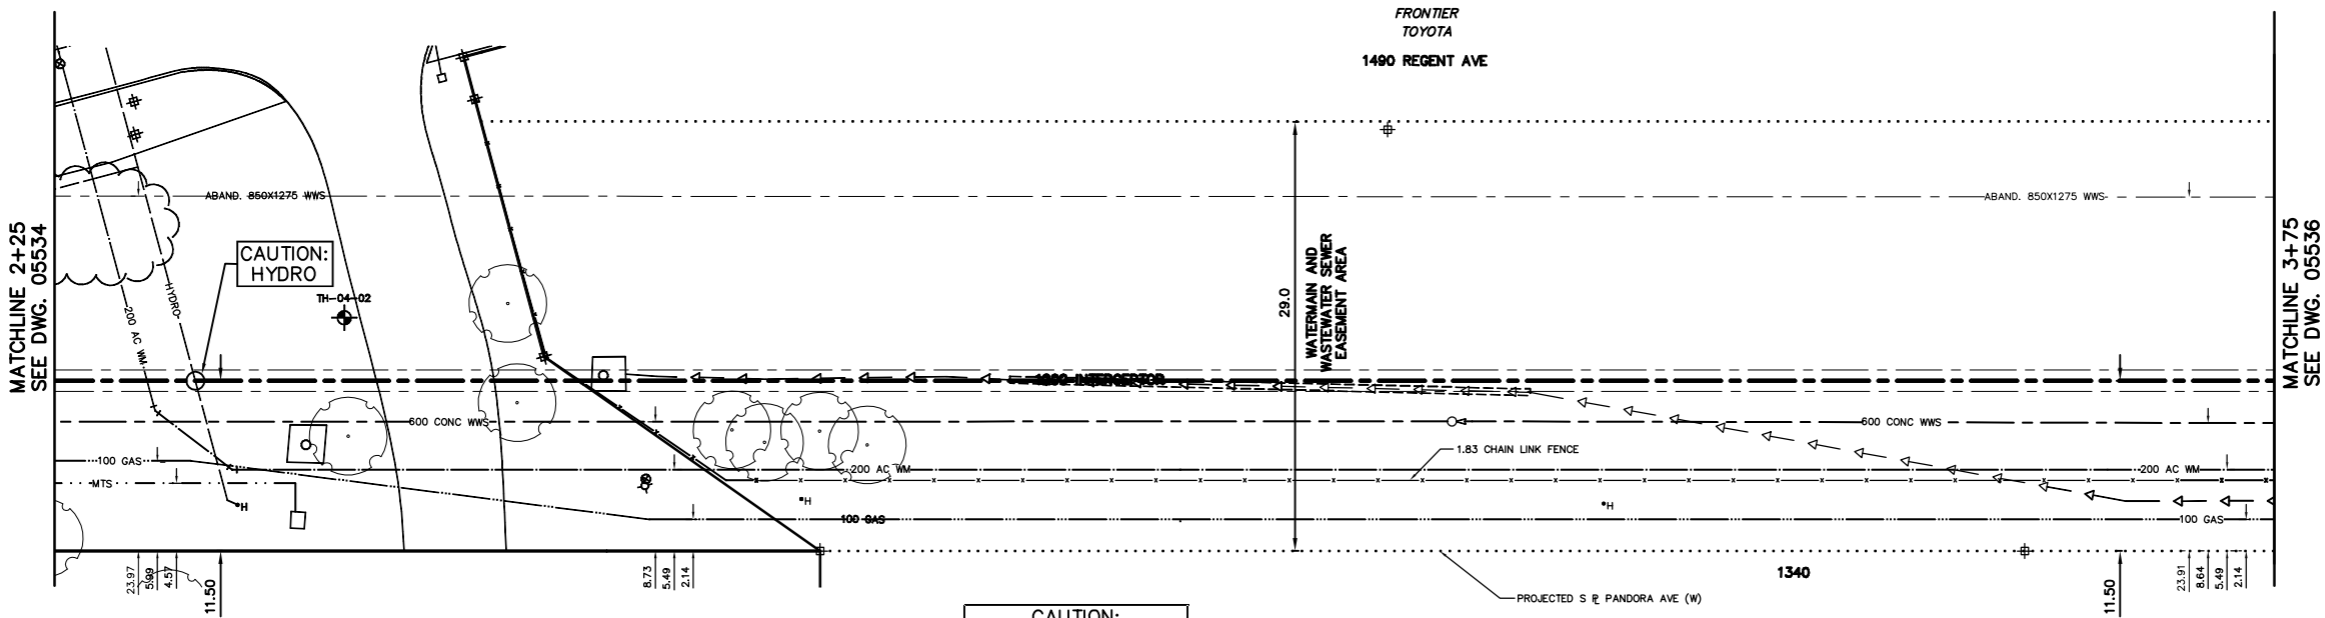

OVERHEAD HYDRO WIRES INCLUDE HOUSEHOLD (120/240V) AND HIGH VOLTAGE (7200V)

CAUTION: GAS & OVERHEAD HYDRO PARALLEL TO INTERCEPTOR SEWER

NOTE: CONTRACTOR TO REMOVE AND REPLACE CHAIN LINK FENCE AS REQUIRED OR AS DIRECTED BY THE CONTRACT ADMINISTRATOR

METRIC
WHOLE NUMBERS INDICATE MILLIMETRES
DECIMALIZED NUMBERS INDICATE METRES

WARNING
IF POWER EQUIPMENT OR EXPLOSIVES ARE TO BE USED FOR EXCAVATION ON THIS PROJECT THE CONTRACTOR
1) NOTIFY THE GAS COMPANY OF THE PROPOSED LOCATION OF EXCAVATION.
2) TAKE PRECAUTION TO AVOID DAMAGE TO GAS COMPANY INSTALLATIONS.
SEE PROVINCIAL REGULATION 210/72 FOR DETAILS

200 WM	WATERMAIN	200 WM	SL, HYDRO	150 WM	WATERMAIN	150 WM
⊕	HYDRANT	⊕	MTS	⊕	HYDRANT	⊕
⊙	VALVE	⊙	TRAFFIC SIGNALS	⊙	VALVE	⊙
525 LDS	LAND DRAINAGE SEWER	525 LDS	GAS	50 GAS	300 LDS	LAND DRAINAGE SEWER
375 WWS	WASTEWATER SEWER	375 WWS	SURVEY BAR	250 WWS	250 WWS	WASTEWATER SEWER
○	MANHOLE	○	FENCE	⊕	⊕	PROFILE
□	CATCH BASIN	□	POLE - HYDRO, MTS	⊕	⊕	GROUND ABOVE PIPE
▽	CURB INLET	▽	CURB STOP	⊕	⊕	DITCH (NORTH & WEST)
⊕	JUNCTIONS	⊕	GUY ANCHOR	⊕	⊕	DITCH (SOUTH & EAST)
⊕	CULVERT	⊕	LIGHT STANDARD	⊕	⊕	
⊕	ANODE	⊕	TREE	⊕	⊕	
EXISTING	LEGEND-PLAN	PROPOSED	EXISTING	LEGEND-PLAN	PROPOSED	EXISTING

LOCATION APPROVED UNDERGROUND STRUCTURES

SUPV. U/G STRUCTURES COMMITTEE DATE

NOTE: LOCATION OF UNDERGROUND STRUCTURES AS SHOWN ARE BASED ON THE BEST INFORMATION AVAILABLE BUT NO GUARANTEE IS GIVEN THAT ALL EXISTING UTILITIES ARE SHOWN OR THAT THE GIVEN LOCATIONS ARE EXACT. CONFIRMATION OF EXISTENCE AND EXACT LOCATION OF ALL SERVICES MUST BE OBTAINED FROM THE INDIVIDUAL UTILITIES BEFORE PROCEEDING WITH CONSTRUCTION.

B.M. ELEV.	FIELD BOOK #:
POSTED TO LBIS	
2.) MH3 TO MH9 ALIGNMENT & INVERT CHANGES	05.04.13 KZ
1.) REVISION - ADDED MH NUMBERS	05.04.11 SC
NO. REVISIONS	DATE BY

CITY OF WINNIPEG
WATER AND WASTE
ENGINEERING DIVISION

DESIGNED BY SC CHECKED BY TW
DRAWN BY CJH APPROVED BY KZ

HOR. SCALE 1:250
VERTICAL 1:50

DATE 2005 03 31

ENGINEER'S SEAL

ORIGINAL SIGNED BY K.R. ZUREK 05/03/31

BID OPPORTUNITY: 93-2005
PLOT DATE: 2005 04 14

THE CITY OF WINNIPEG
WATER AND WASTE DEPARTMENT

NORTHEAST INTERCEPTOR
STAGE VII
PANDORA AVENUE (WEST)
322 m W OF W.P. STARLIGHT DRIVE TO
172 m W OF W.P. STARLIGHT DRIVE

SHEET 3 OF 18
CITY DRAWING NUMBER 05533