
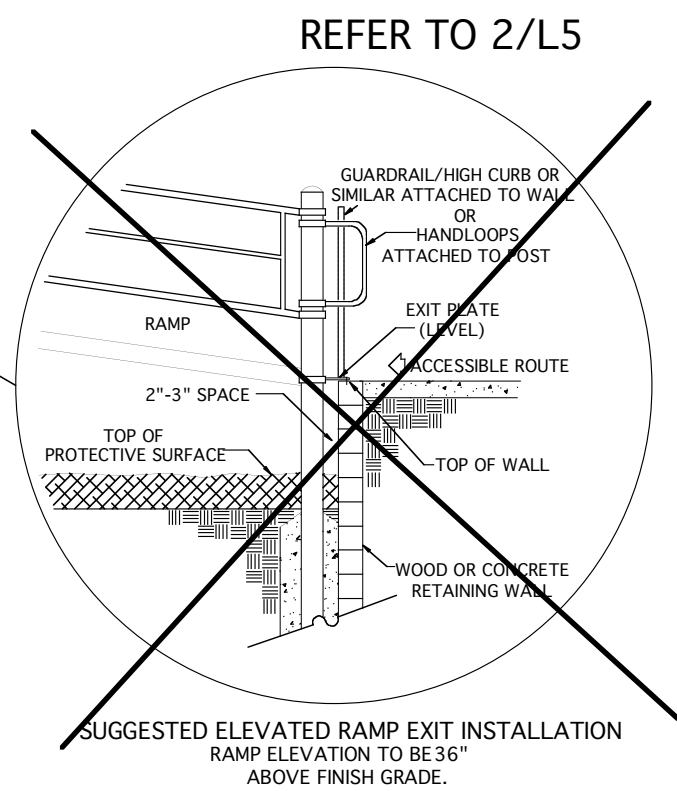


54'-2"

56'-1"

*NOTE: 7' SAFETY ZONES.

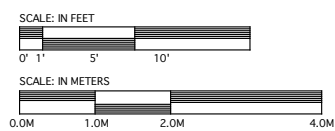

CUSTOM EXIT PLATE REQUIRED

REFER TO 2/L5

5-12 YEARS

CLH
FEB 27 2006

LANDSCAPE
STRUCTURES

ST. VITAL PARK - CASTLE STRUCTURE

WINNIPEG, MB

PLAYGROUNDS-R-US

JODI MARR

PLAYBOOSTER

6503-1-1

