




2 PARAPET & ROOFING DETAIL
WB-B0145 1 : 10

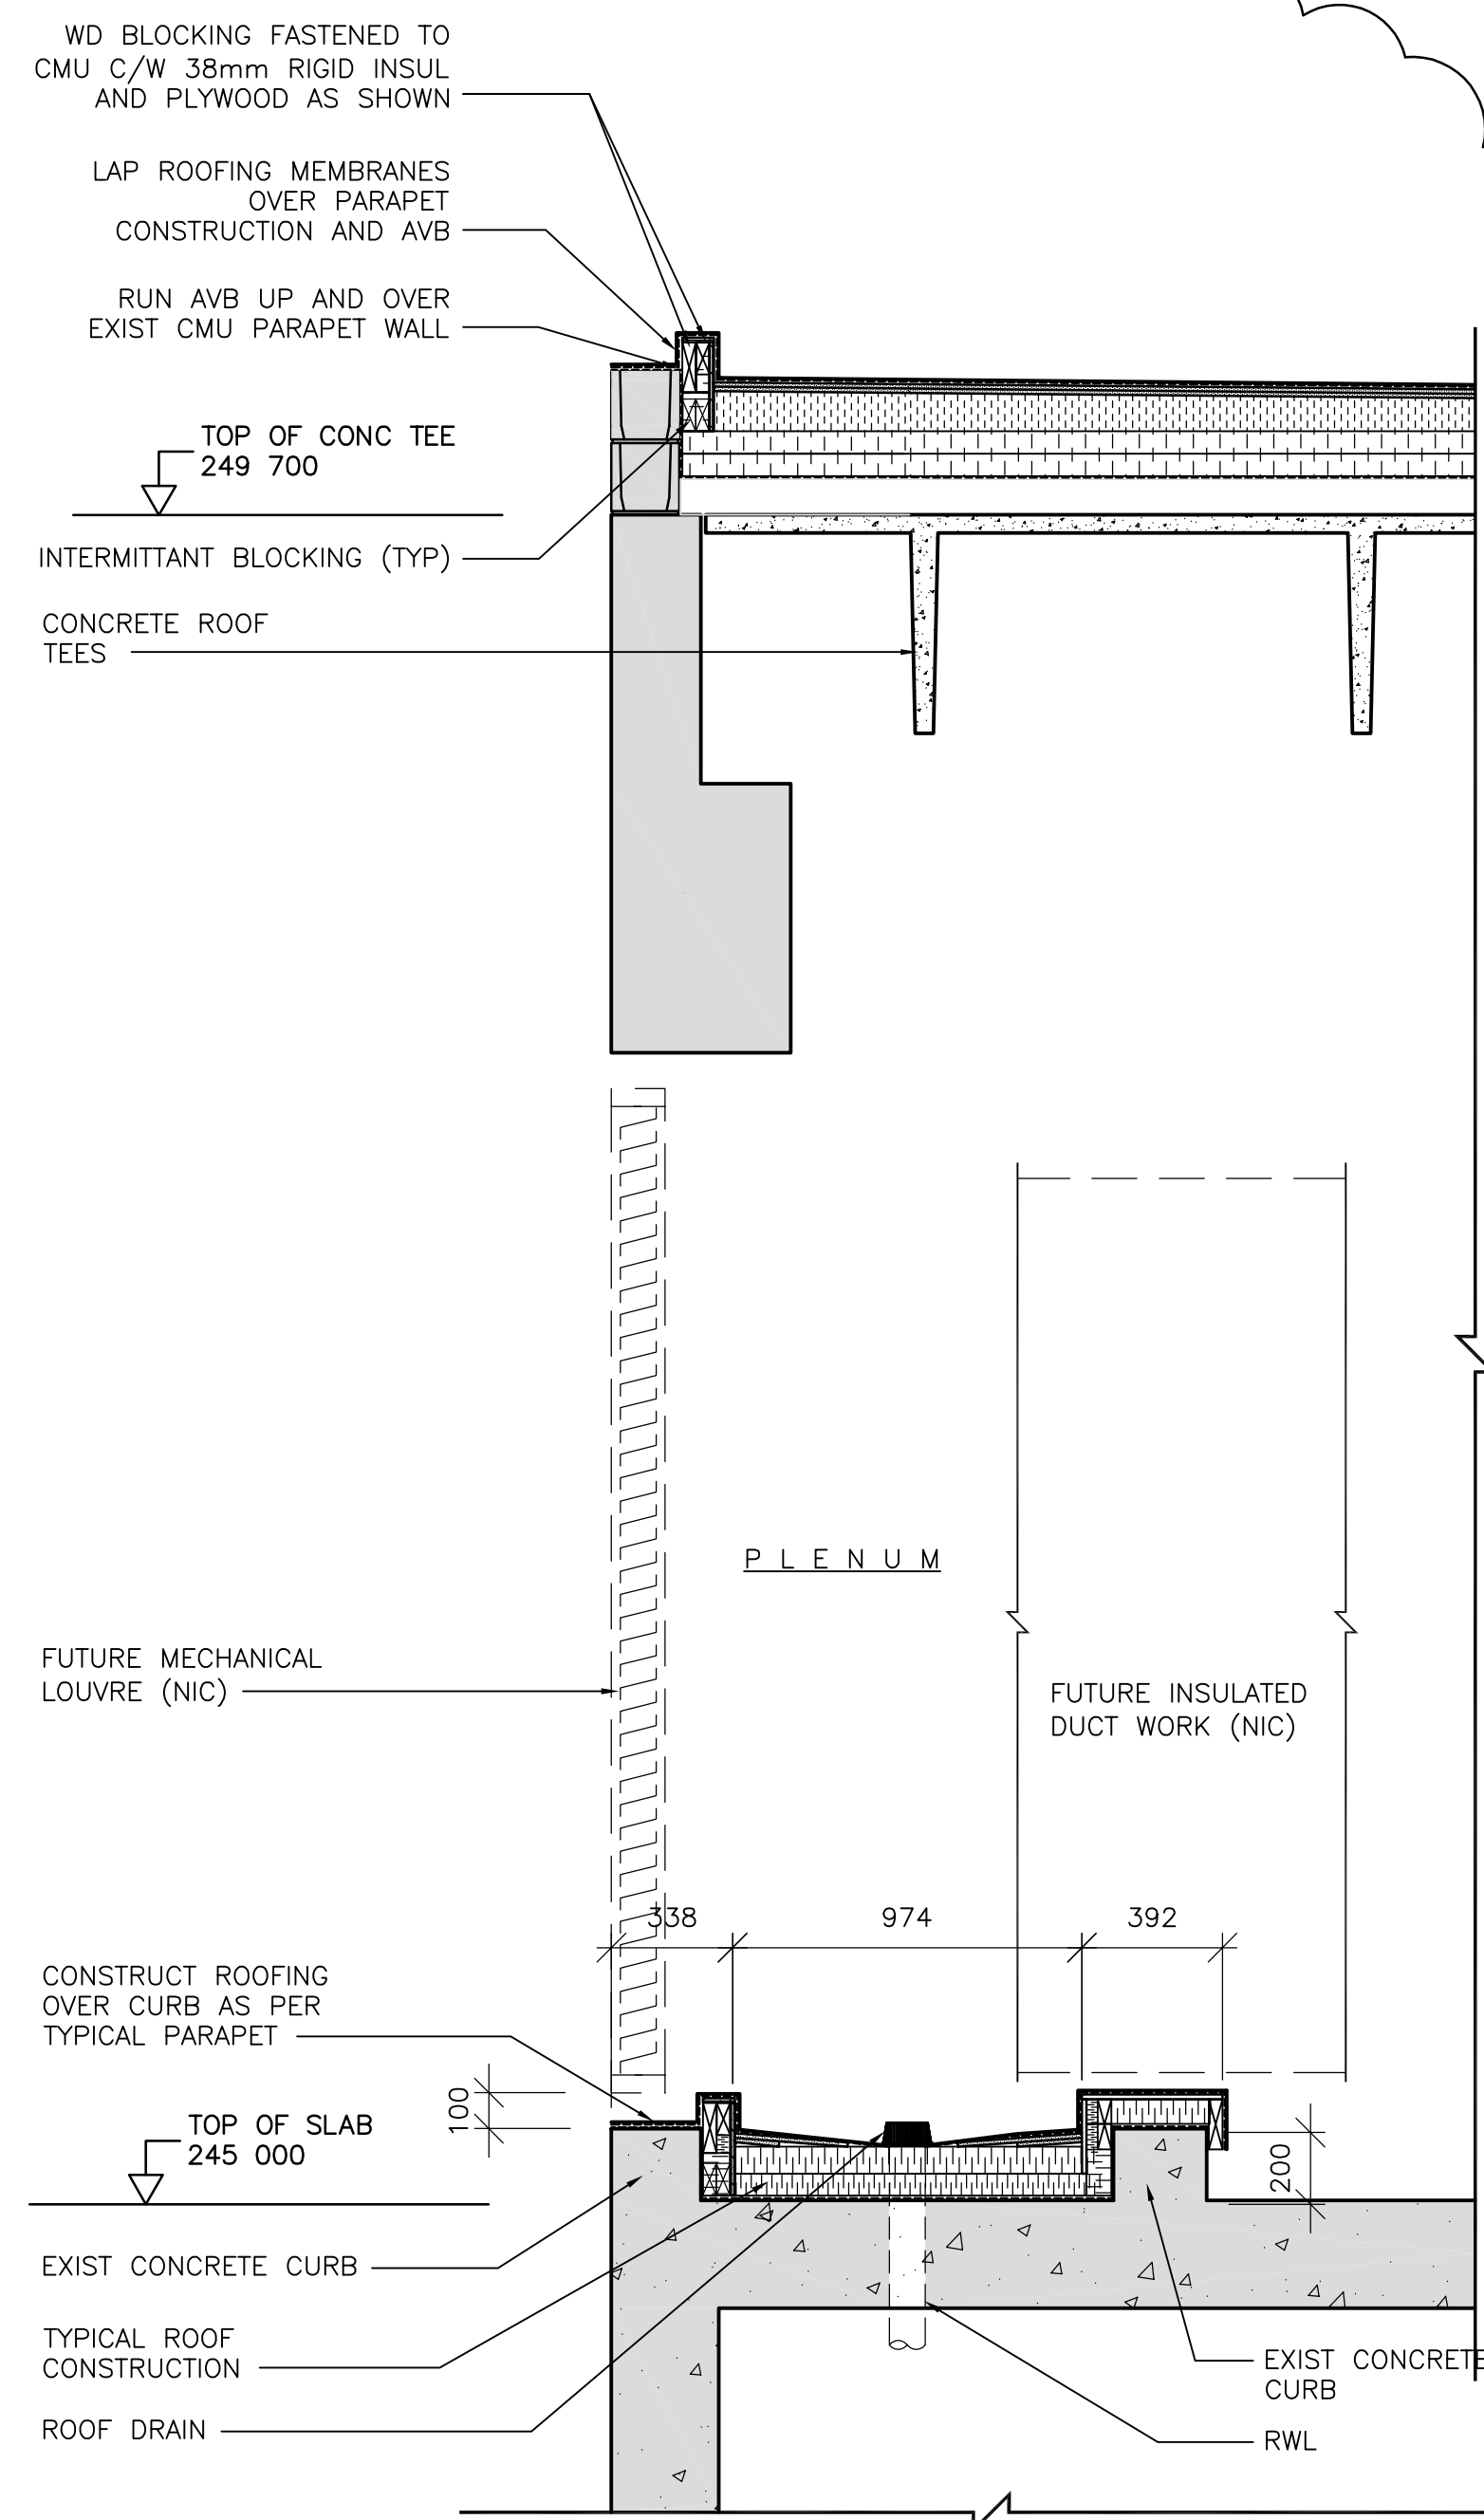

3 SECTION DETAIL @ MECHANICAL PLENUM (TYP)
WB-B0130 1 : 20

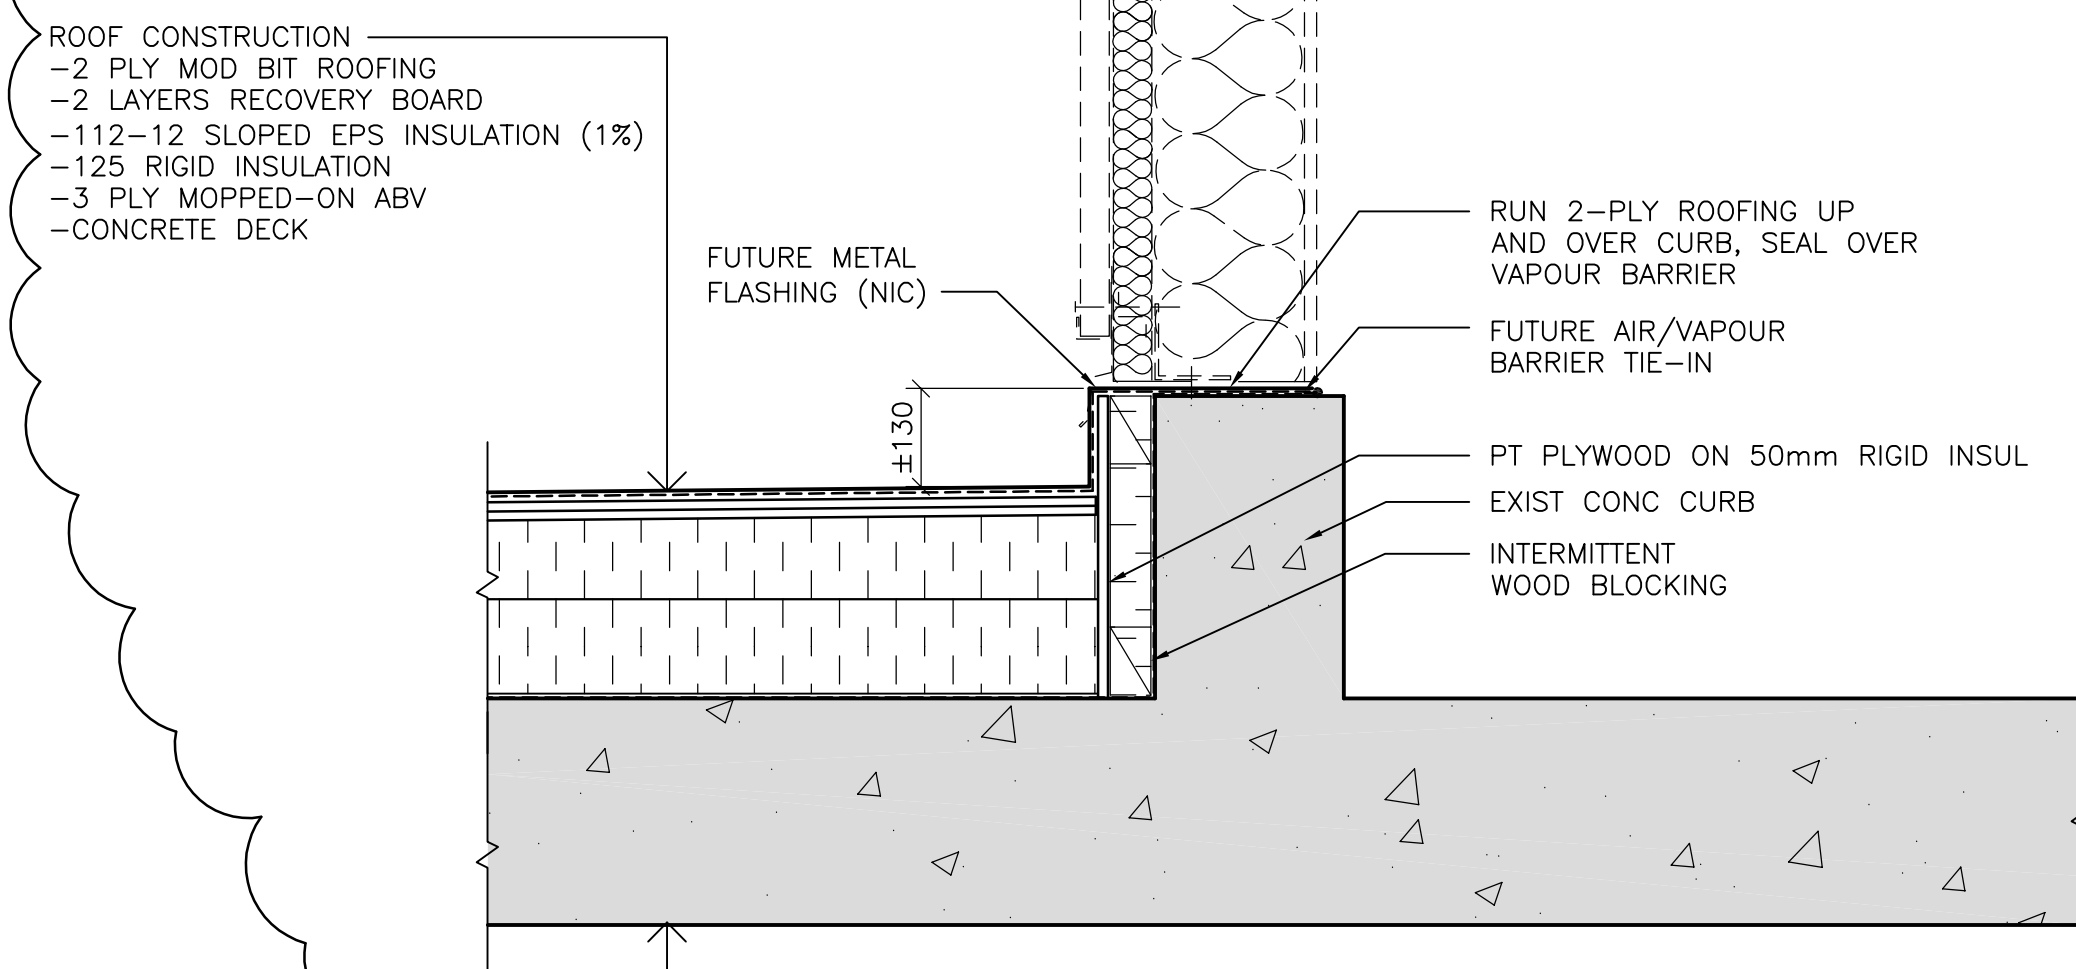

1 BASE CURB ROOFING DETAIL
WB-B0145 1 : 10

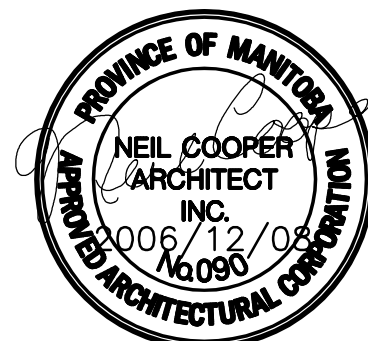

NO.	REVISIONS	DATE	BY	DATE	BY
01	171-2006 ADDENDUM 5	07/01/16	LK		
00	171-2006 ADDENDUM 3	06/12/08	AL		

DESIGNED BY	NC	CHECKED BY	LK
DRAWN BY	AL	APPROVED BY	AHL
SCALE:	AS NOTED	RELEASED FOR CONSTRUCTION BY:	R. SOROKOWSKI
DATE	2006/12/07	DATE	2006/12/08

ENGINEER'S SEAL	ORIGINAL SIGNED BY	CONSULTANT DRAWING NO.
	N. COOPER	WB-B0403
	2006/12/08	

THE CITY OF WINNIPEG
WATER AND WASTE DEPARTMENT
ENGINEERING DIVISION

WATER TREATMENT PLANT
MAIN BUILDING
BUILDING ENVELOPE

ARCHITECTURAL
ROOFING DETAIL AT STEEL PENTHOUSE

CITY FILE NUMBER
SHEET OF
CITY DRAWING NUMBER
1-0601B-A-B0403-001-01D