

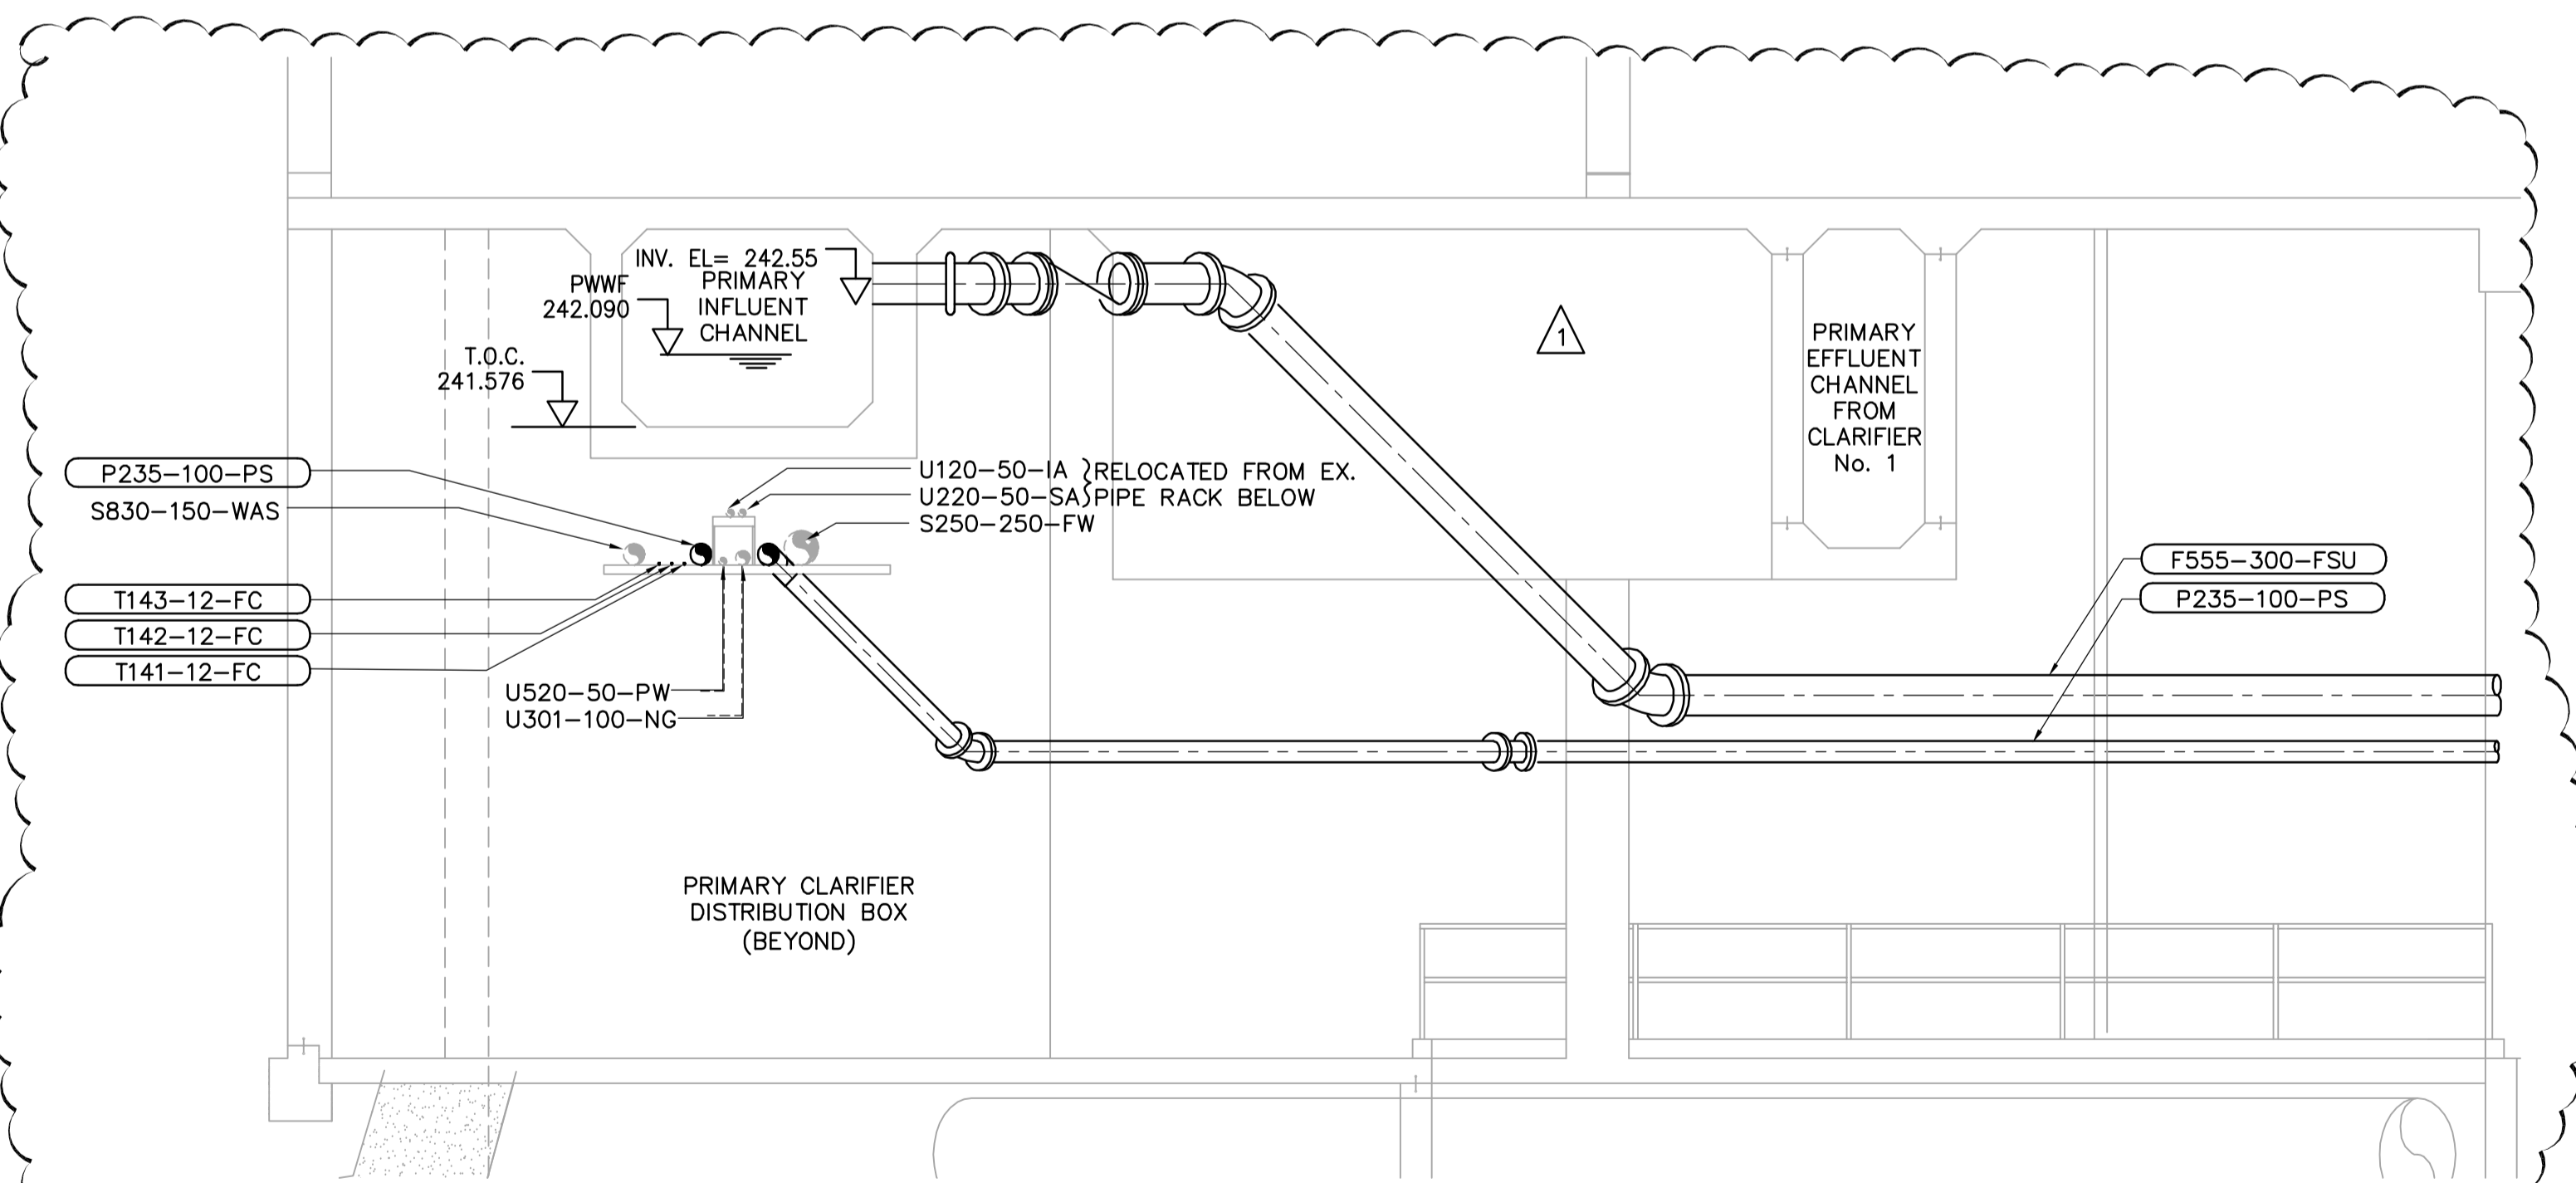


1 SECTION  
PP1.01 1:50

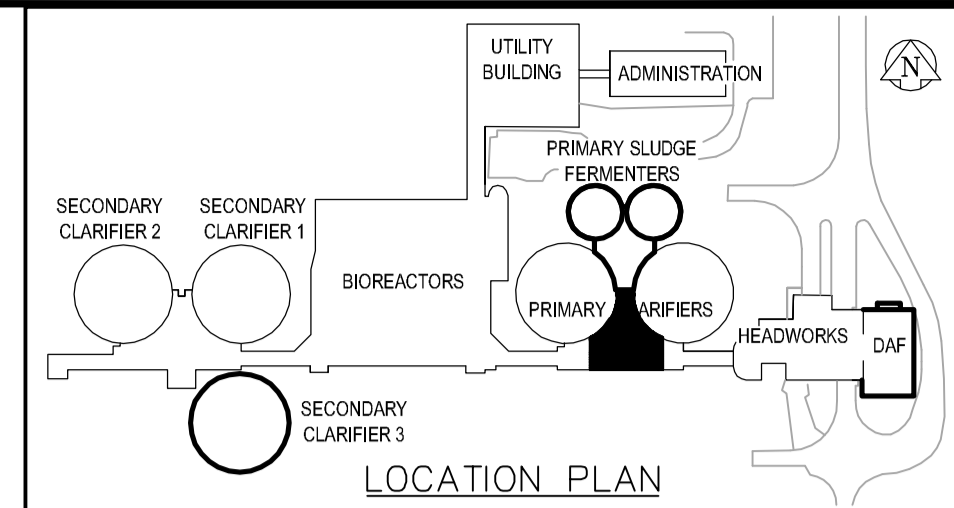

3 SECTION  
PP1.01 1:50

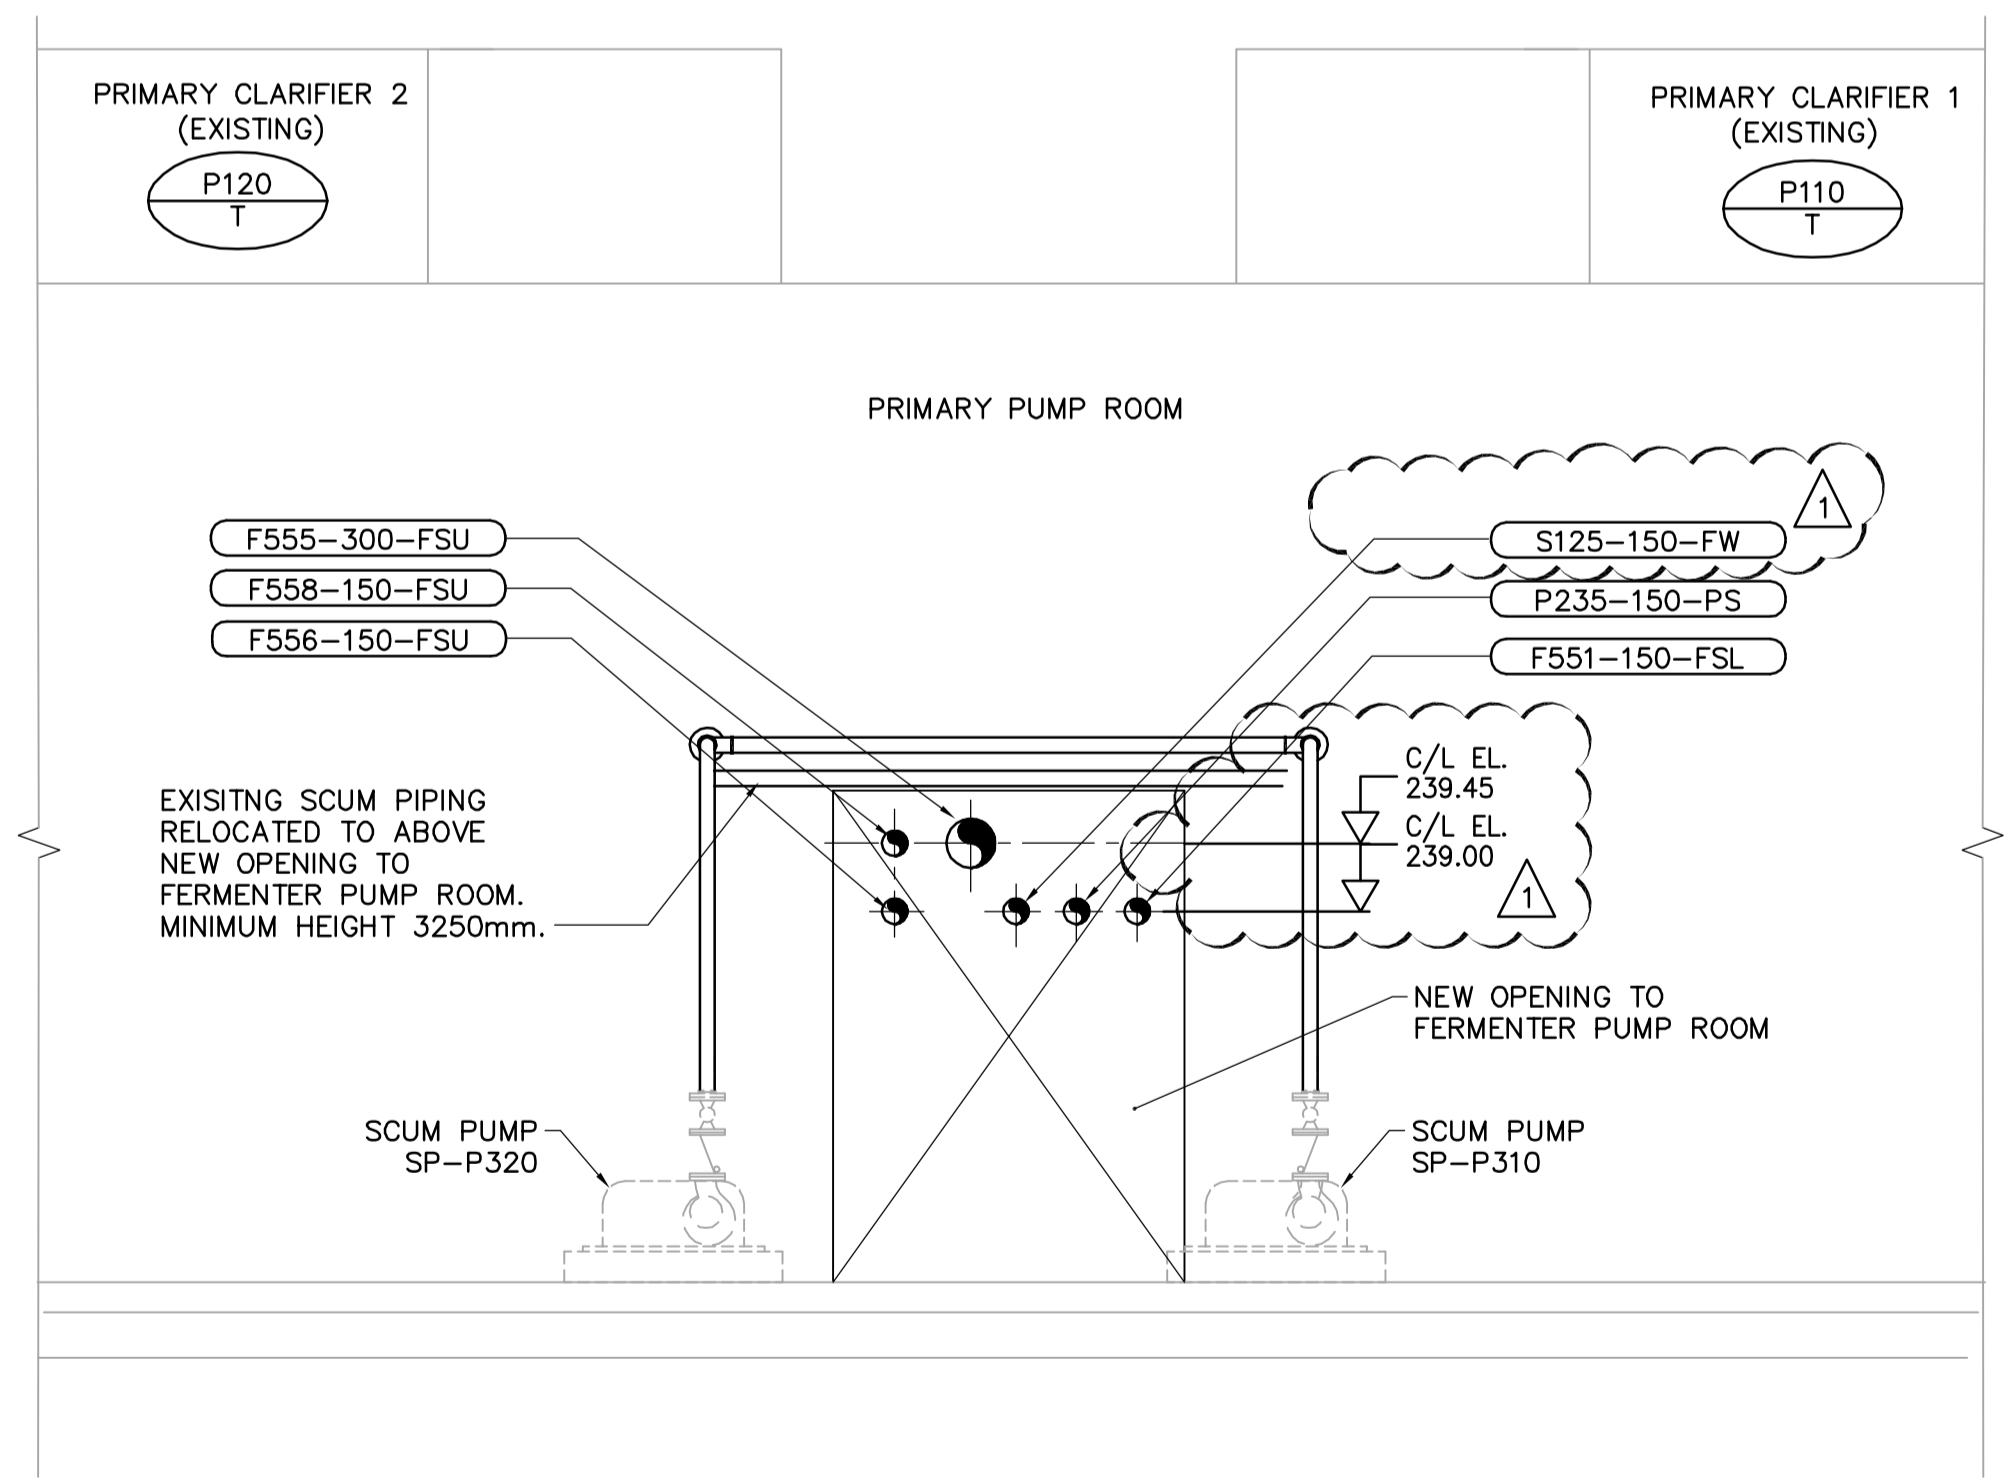

2 SECTION  
PP1.01 1:50

**APCGM**  
Certificate of Authorization  
Earth Tech Canada Inc.  
No. 730 Expiry: April 30, 2006

NO.	REVISIONS	DATE	BY
01	21-2006 ADDENDUM 3	06/05/19	PJY
00	ISSUED FOR TENDER	06/04/26	SRP

DESIGNED BY: YL		CHECKED BY: KM	
DRAWN BY: RI		APPROVED BY: JEH	
HOR. SCALE: AS NOTED		RELEASED FOR CONSTRUCTION BY: J. VEILLEUX	
VERTICAL SCALE:		DATE: 2005/10/06	

ENGINEER'S SEAL  
ORIGINAL SIGNED BY: J.E. HUTCHISON  
2006/04/26  
CONSULTANT DRAWING NO. PP1.02

**THE CITY OF WINNIPEG**  
WATER AND WASTE DEPARTMENT  
ENGINEERING DIVISION

**WEWPCC**  
BIOLOGICAL NUTRIENT REMOVAL UPGRADE  
CONTRACT 3

PROCESS  
AREA P - PRIMARY CLARIFIERS  
PUMP ROOM - SECTIONS

CITY FILE NUMBER  
SHEET OF  
CITY DRAWING NUMBER