


WALKWAY PLAN
SP2.01 1:50

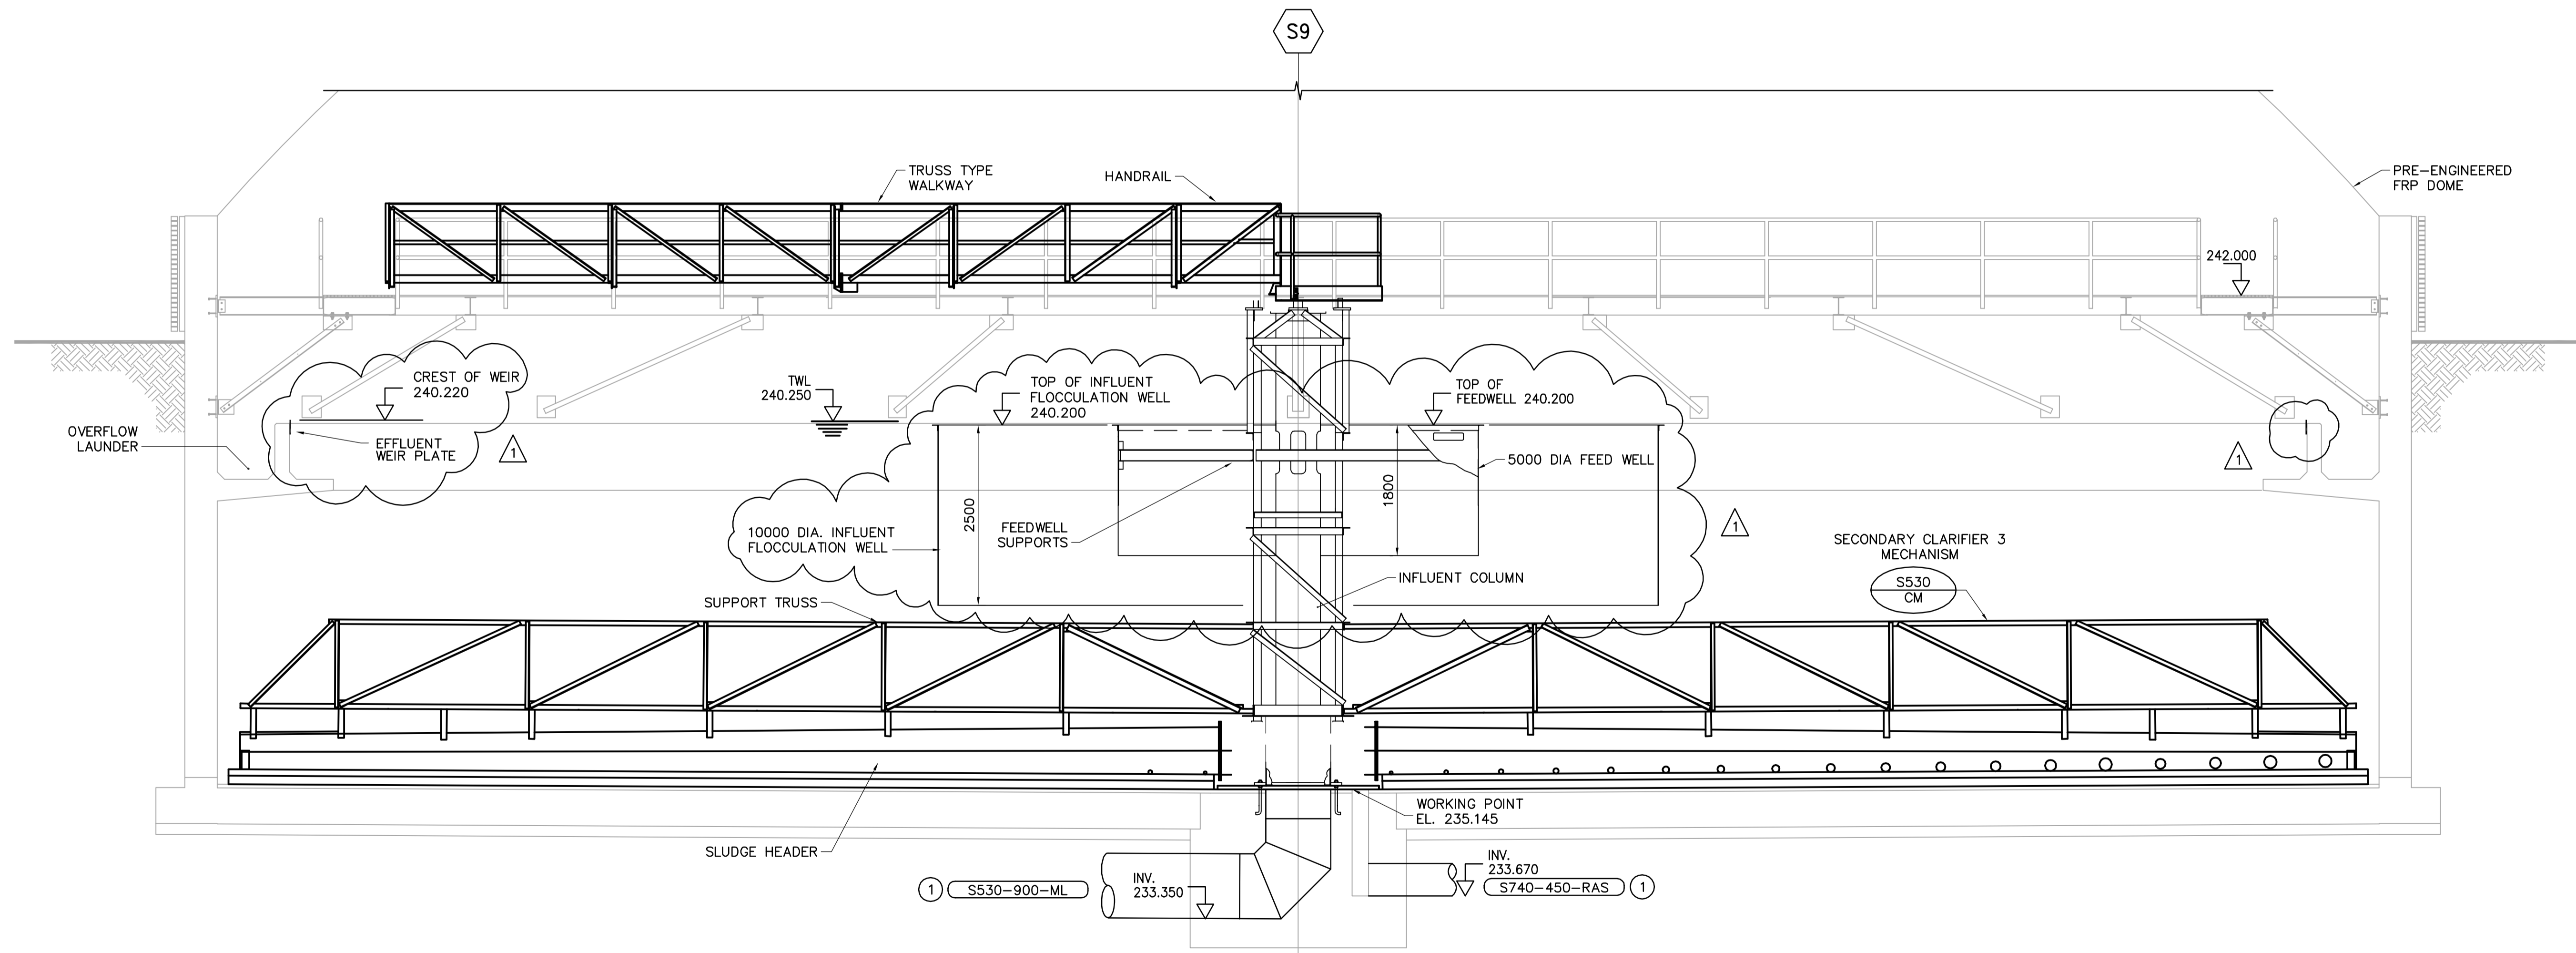

SECTION
SP2.01 1:50

DRAWING NOTES

1 REFER TO DRAWING SP2.08 FOR PIPING DETAILS.

GENERAL NOTES

1. CONTRACTOR TO CONFIRM EXISTING PIPE AND EQUIPMENT DIMENSIONS AND LOCATIONS PRIOR TO CONSTRUCTION.

APECM
Certificate of Authorization
Earth Tech Canada Inc.
No. 730 Expiry: April 30, 2006

B.M. ELEV.	NO.	REVISIONS	DATE	BY
	01	21-2006 ADDENDUM 3	06/05/19	PAL
	00	ISSUED FOR TENDER	06/04/26	SRP

EarthTech
A Tyco International Ltd. Company

DESIGNED BY	KS	CHECKED BY	KM
DRAWN BY	PJY	APPROVED BY	JEH

HOR. SCALE: AS NOTED
VERTICAL SCALE: AS NOTED

RELEASED FOR CONSTRUCTION BY:
J. VEILLEUX

DATE: 2005/10/06 DATE: 2006/04/26

ENGINEER'S SEAL

ORIGINAL SIGNED BY
J.E. HUTCHISON

2006/04/26

CONSULTANT DRAWING NO.
SP2.07

THE CITY OF WINNIPEG
WATER AND WASTE DEPARTMENT
ENGINEERING DIVISION

WEWPCC
BIOLOGICAL NUTRIENT REMOVAL UPGRADE
CONTRACT 3

PROCESS
AREA S - SECONDARY CLARIFIER 3
SECTION

CITY FILE NUMBER
SHEET OF
CITY DRAWING NUMBER