


1 ELECTRICAL ROOM HEATING, COOLING AND VENTILATION UNIT S780-AHU
LM4.07 SCALE NTS

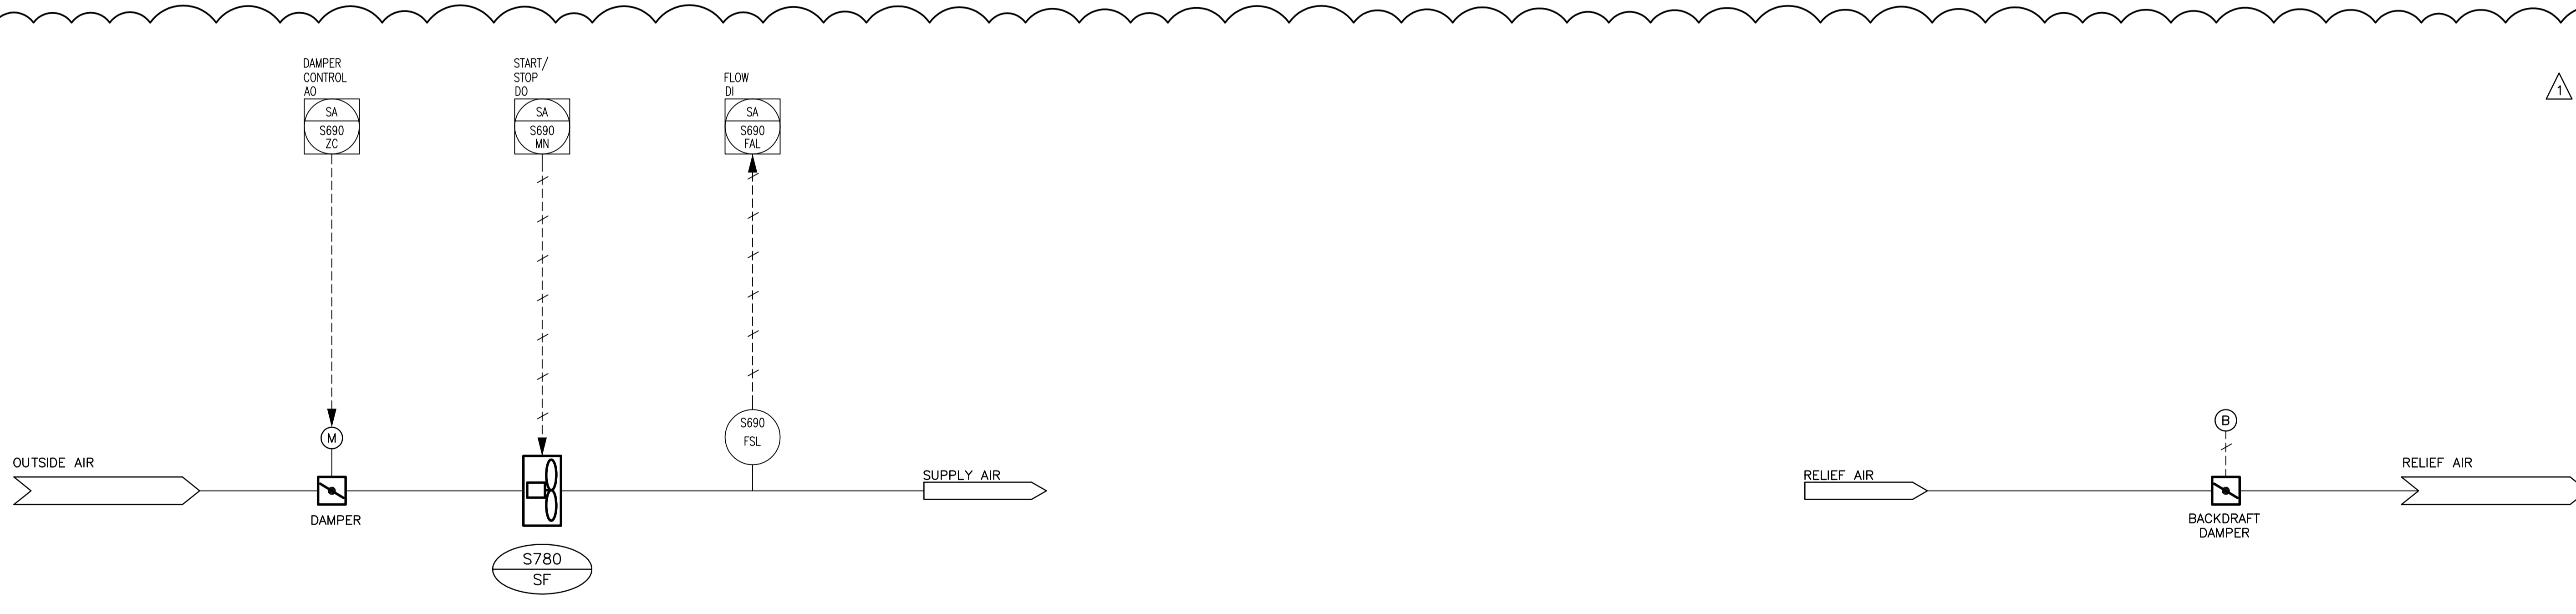

2 MECHANICAL ROOM SUPPLY FAN S780-SF
LM4.07 SCALE NTS

GENERAL NOTES

- REFER TO PLANS FOR PIPE AND DUCT SIZES.
- REFER TO SPEC. SECTIONS 15900 FOR ADDITIONAL REQUIREMENTS.



<p>A Tyco International Ltd. Company</p>	
DESIGNED BY: AB/LJW	CHECKED BY: PVL
DRAWN BY: LJW	APPROVED BY: JEH
HOR. SCALE: NTS VERTICAL SCALE: J. VEILLEUX	
NO. REVISIONS	DATE BY DATE
01	21-2006 ADDENDUM 4 06/06/02 DC
00	ISSUED FOR TENDER 06/04/26 LJW
2006/01/04	2006/04/26

ENGINEER'S SEAL

ORIGINAL SIGNED BY: A. BURACHYNSKY

DATE: 2006/04/26

CONSULTANT DRAWING NO. LM4.07

THE CITY OF WINNIPEG
WATER AND WASTE DEPARTMENT
ENGINEERING DIVISION

WEWPC
BIOLOGICAL NUTRIENT REMOVAL UPGRADE
CONTRACT 3

CITY FILE NUMBER
SHEET OF
CITY DRAWING NUMBER

MECHANICAL
AREA L - GENERAL AND SITEWORKS
HEATING, COOLING & VENTILATION SCHEMATICS