




1 BUILDING SECTION
 A1.01 1:125

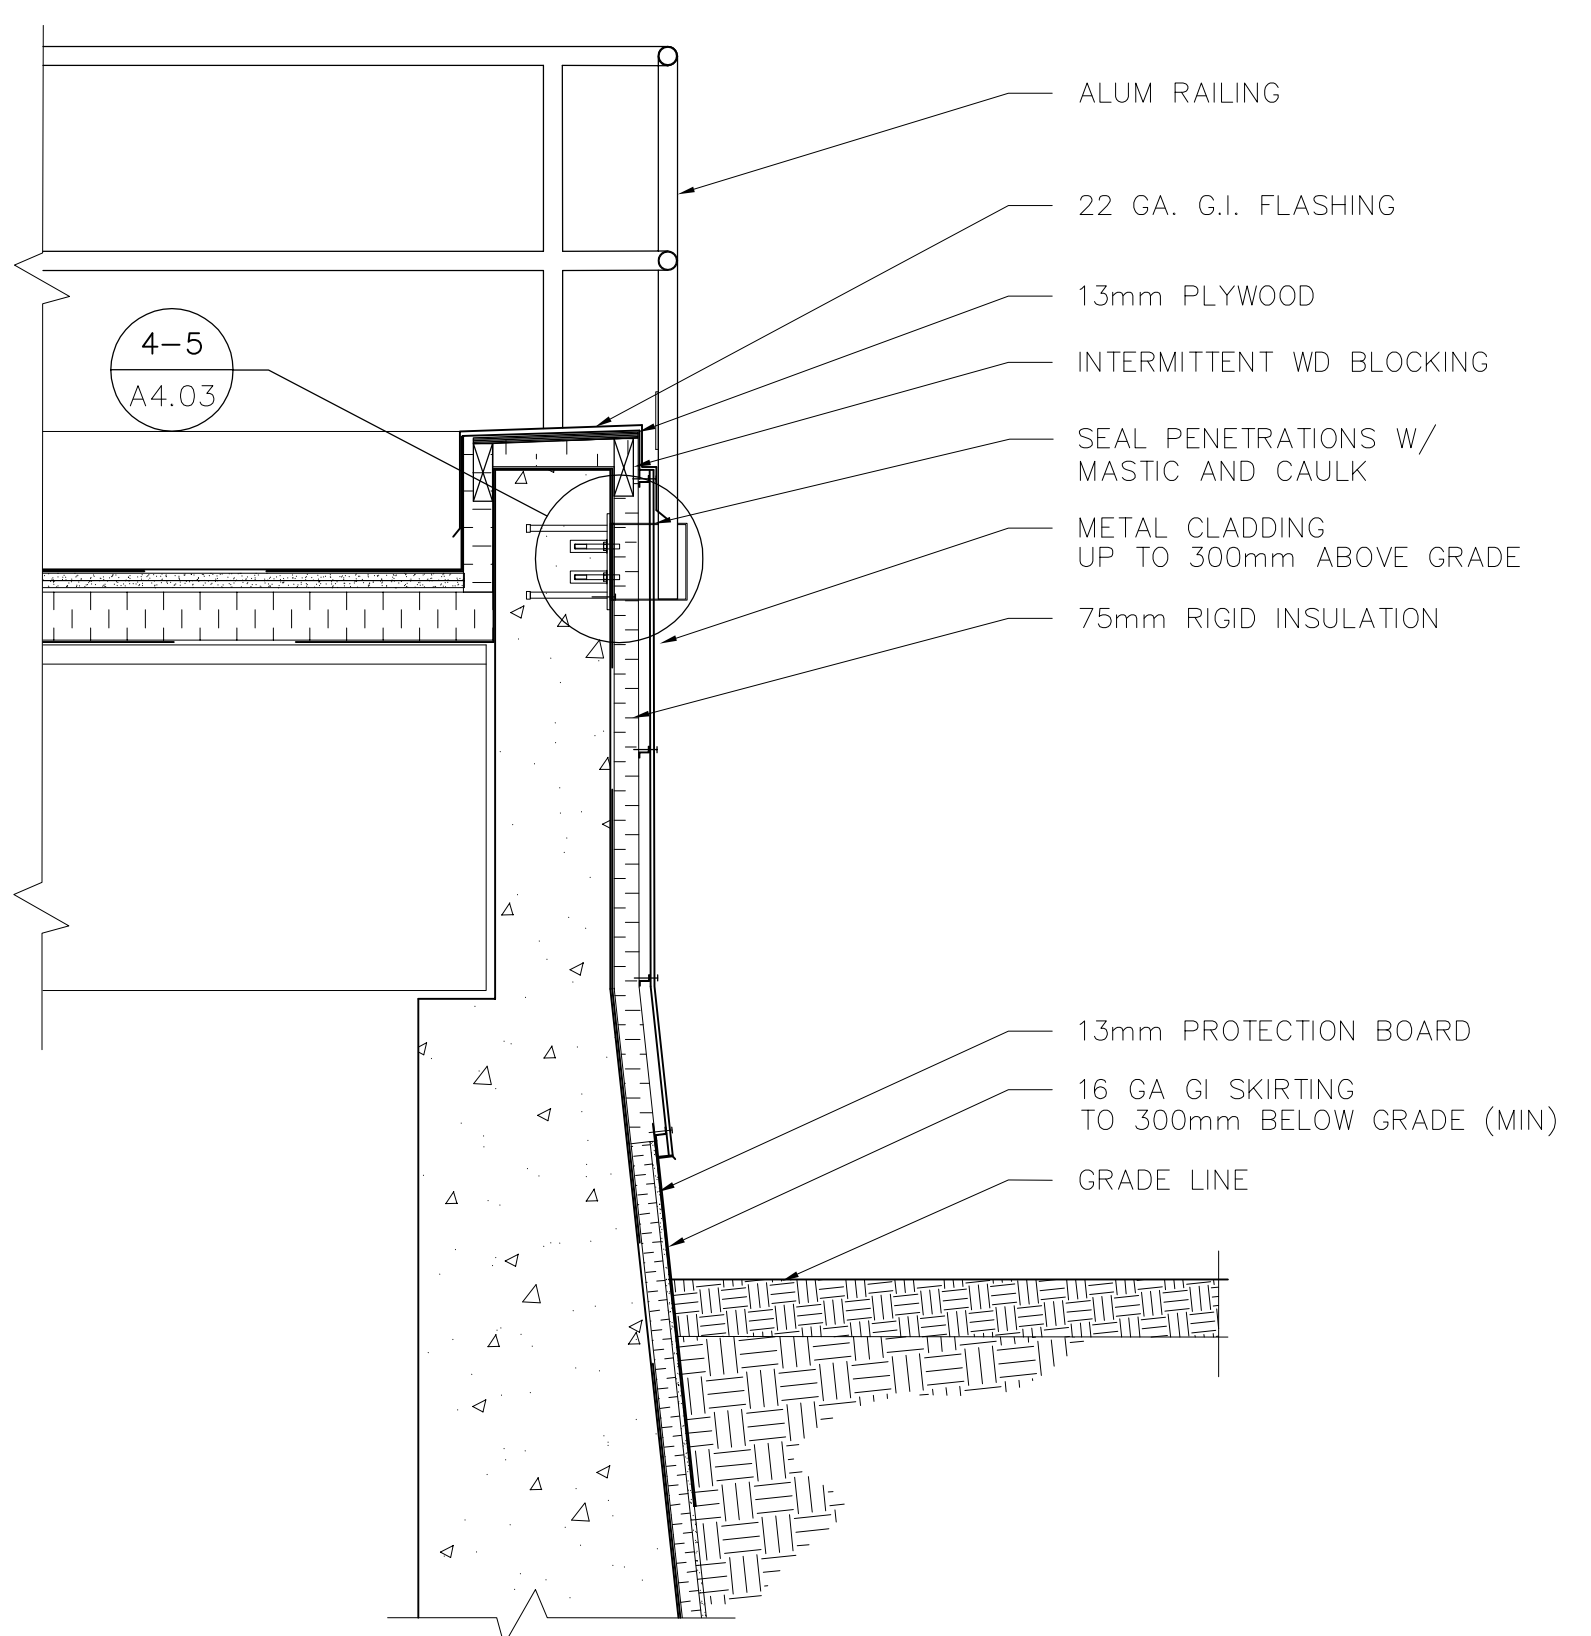

4 SBR WALL DETAIL SECTION
 A3-02 1:20

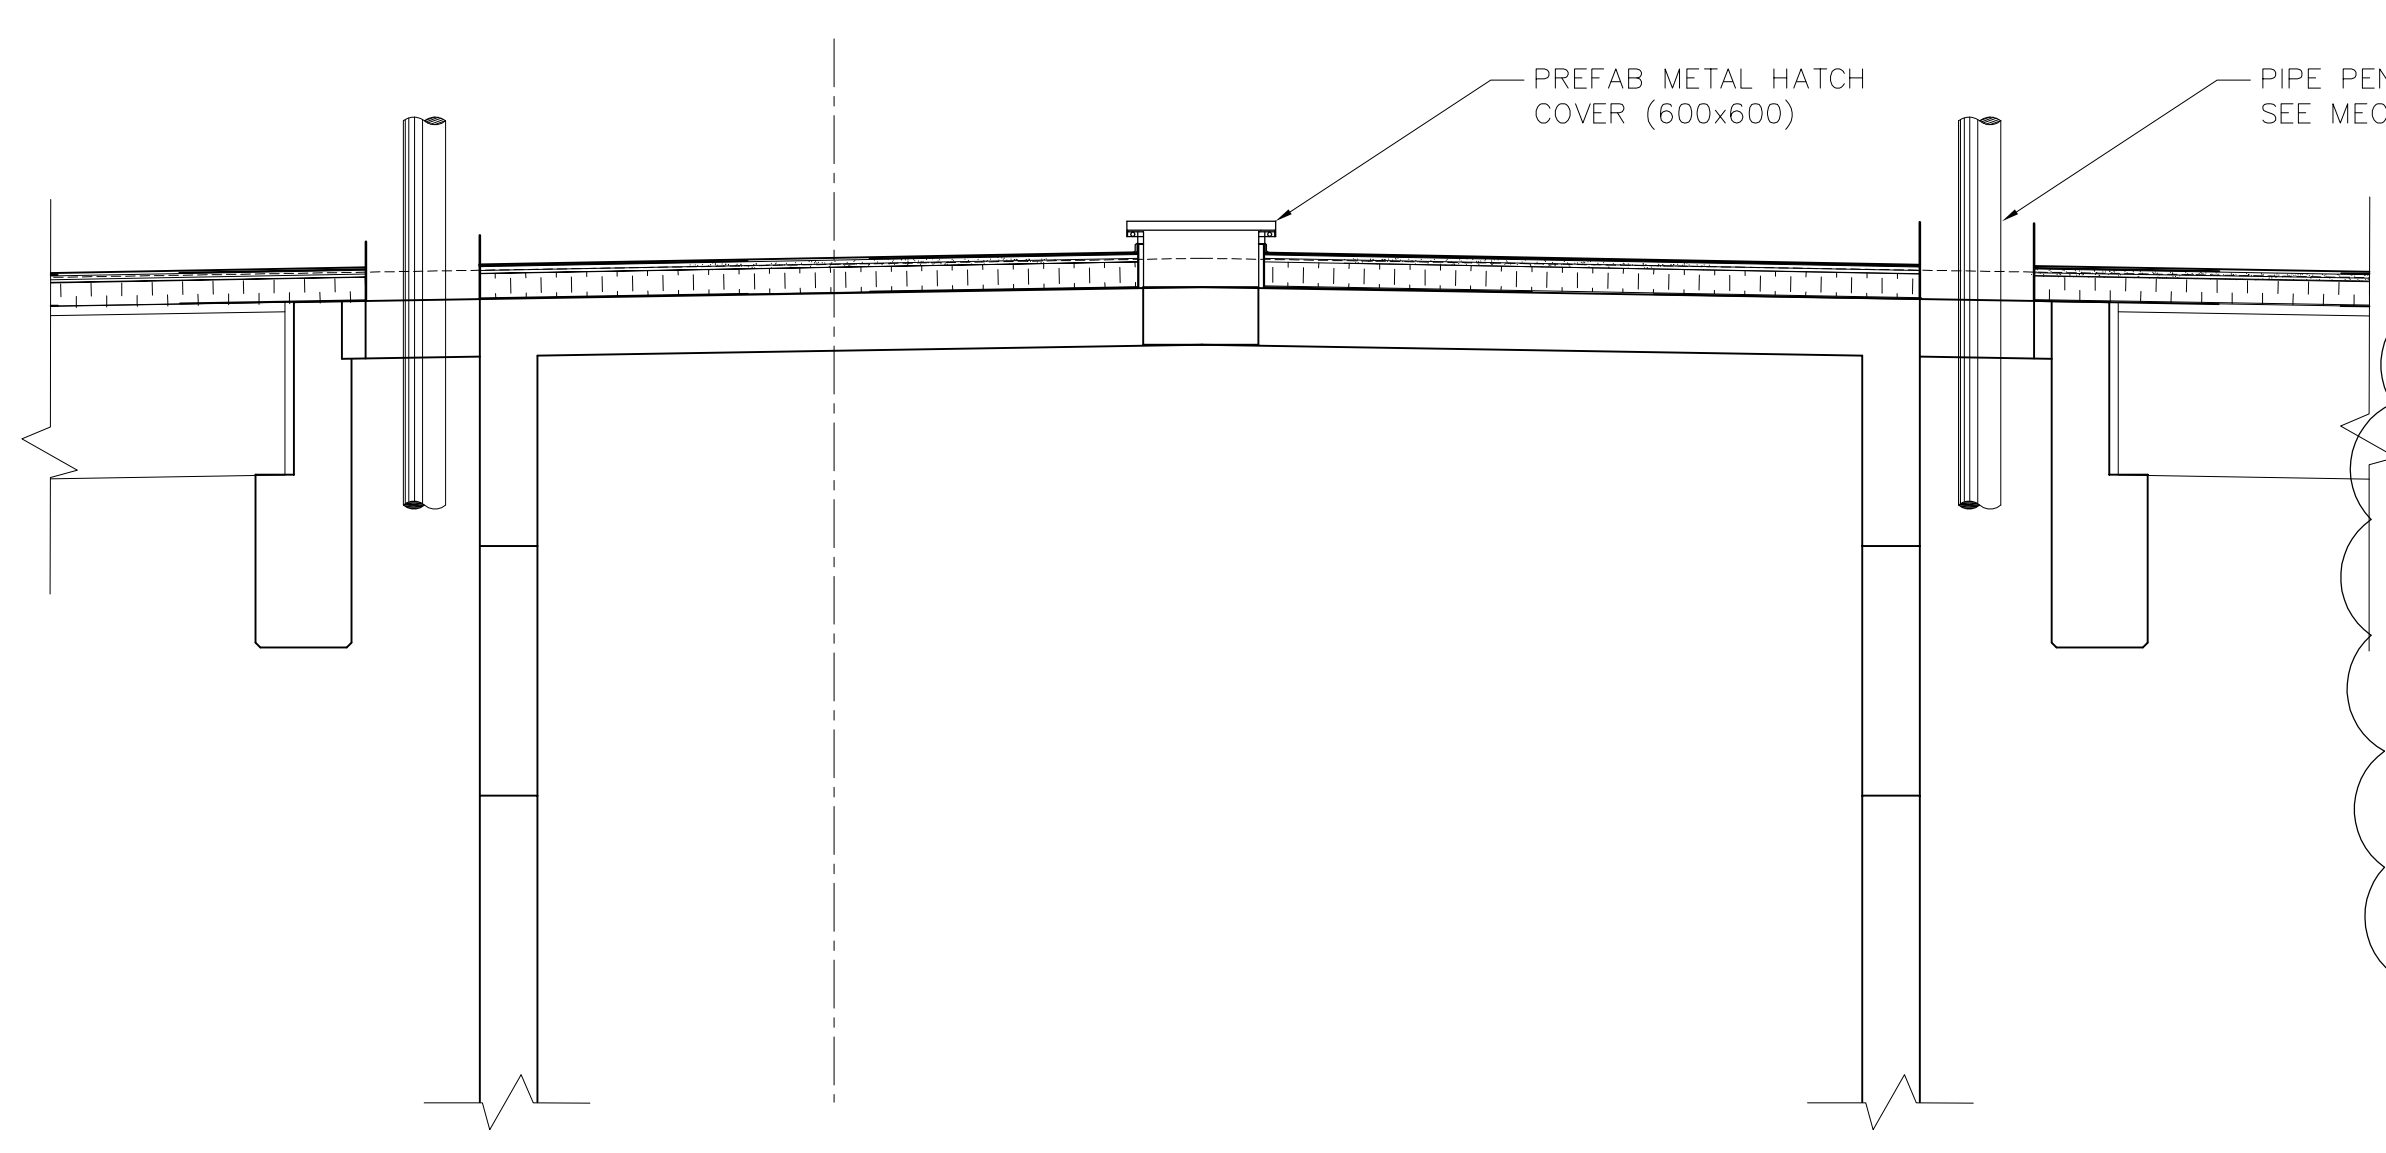

2 DETAIL SECTION
 A3.02 1:40

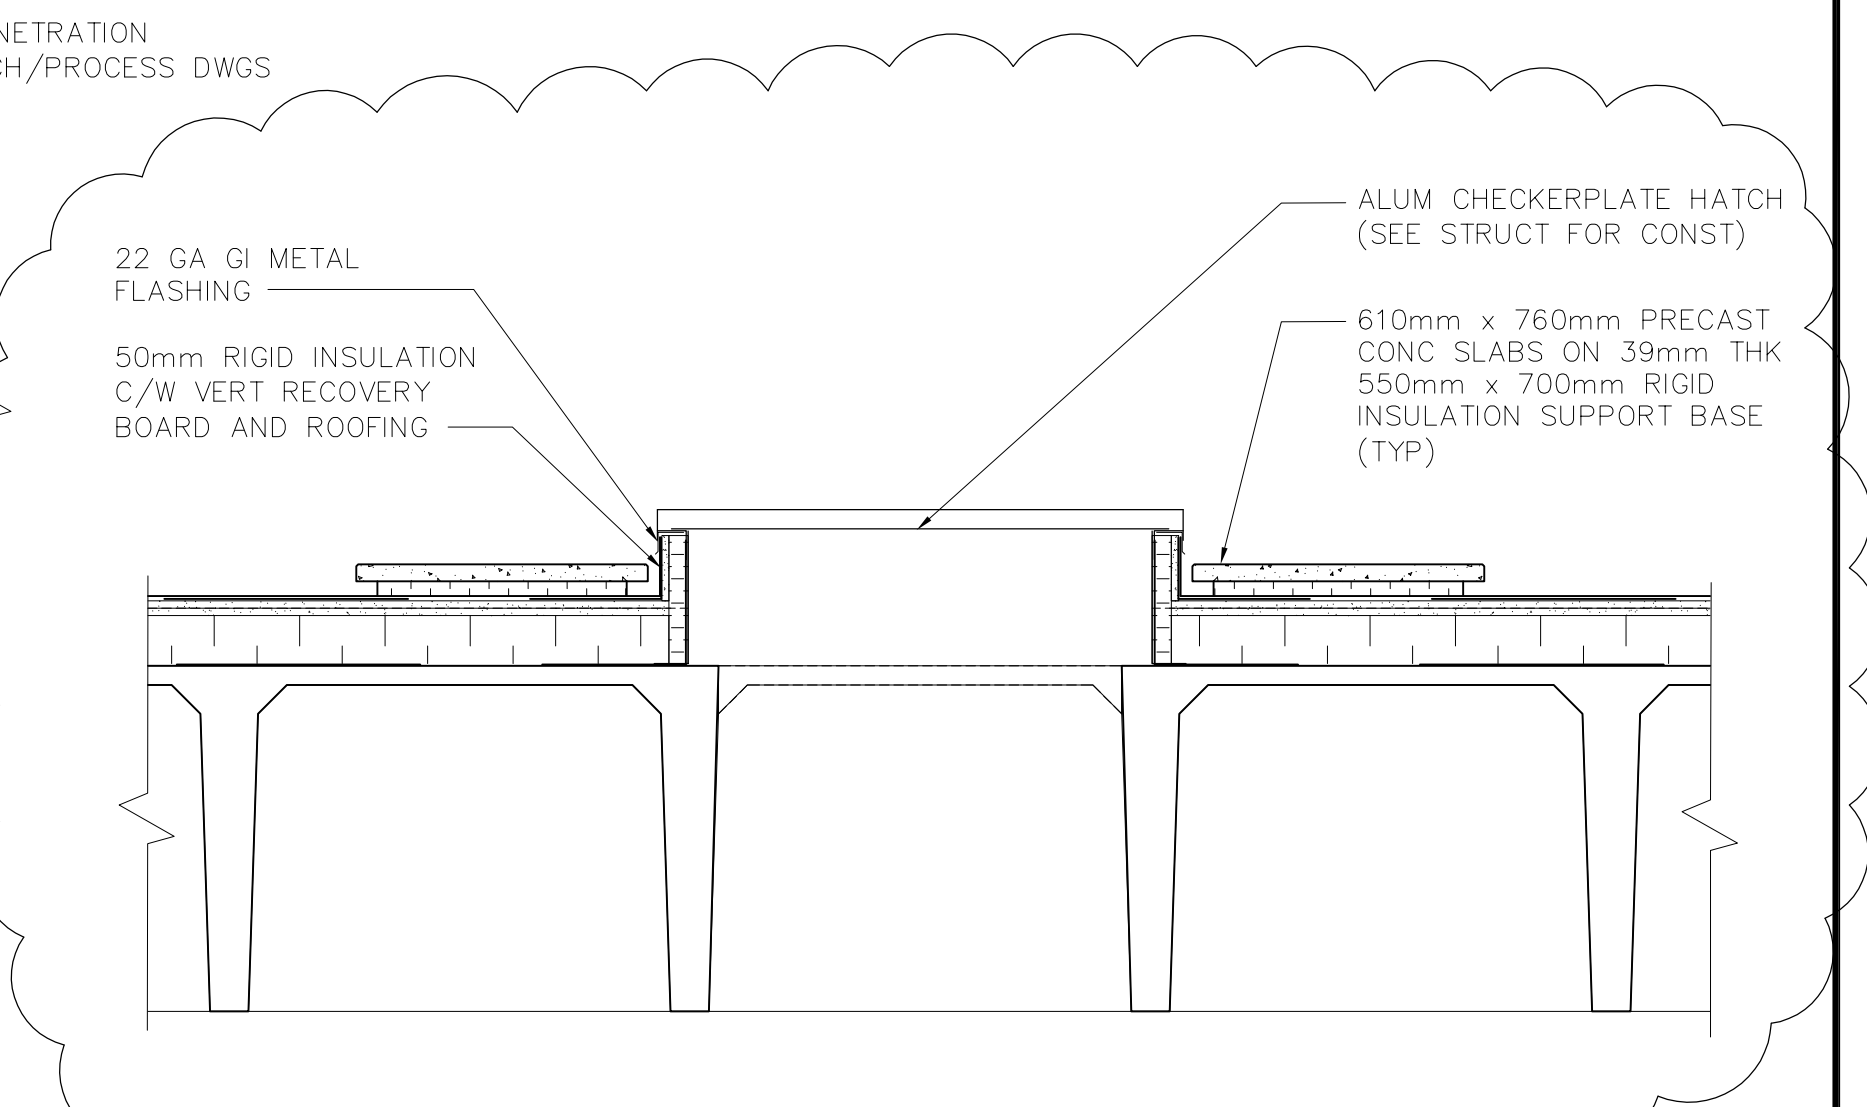

3 ROOF HATCH DETAIL (TYP)
 A1.02 1:20



B.M. ELEV.		EarthTech A Tyco International Ltd. Company		ENGINEER'S SEAL	THE CITY OF WINNIPEG WATER AND WASTE DEPARTMENT ENGINEERING DIVISION
				ORIGINAL SIGNED BY N. COOPER 2006/05/15	
DESIGNED BY	NC	CHECKED BY	LK	CONSULTANT DRAWING NO. A3.01	CITY FILE NUMBER
DRAWN BY	AL	APPROVED BY	JEH		SHEET OF
HOR. SCALE:	AS NOTED	RELEASED FOR CONSTRUCTION BY:	K. MARTENS	ARCHITECTURAL BUILDING SECTION & DETAILS	CITY DRAWING NUMBER
VERTICAL SCALE:		DATE	2006/03/21		
NO. REVISIONS	DATE	BY			