SHEET: COW-A1 (05/2005)

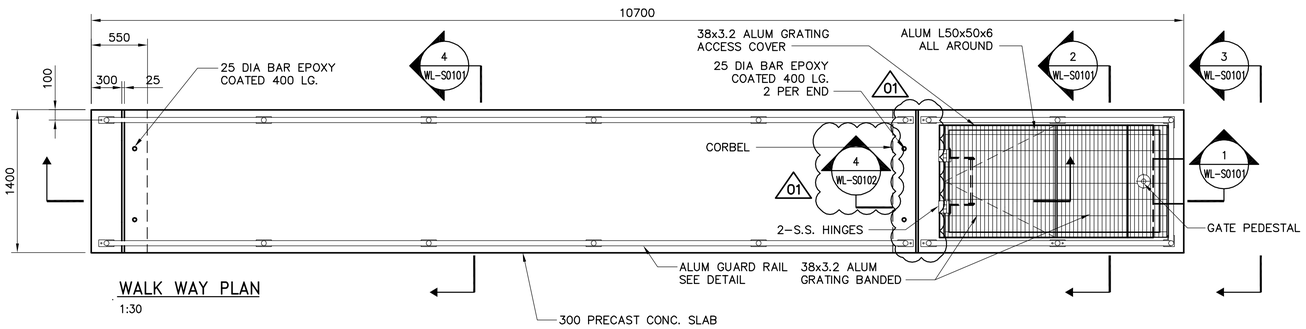

WALK WAY PLAN
1:30

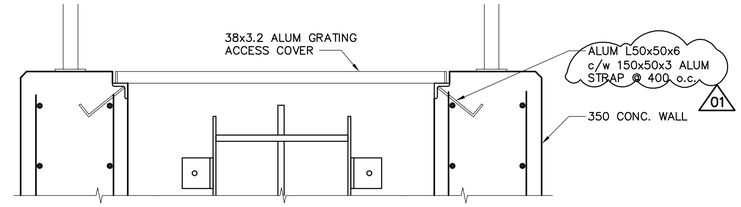

5 WL-S0101 DETAIL
1:10

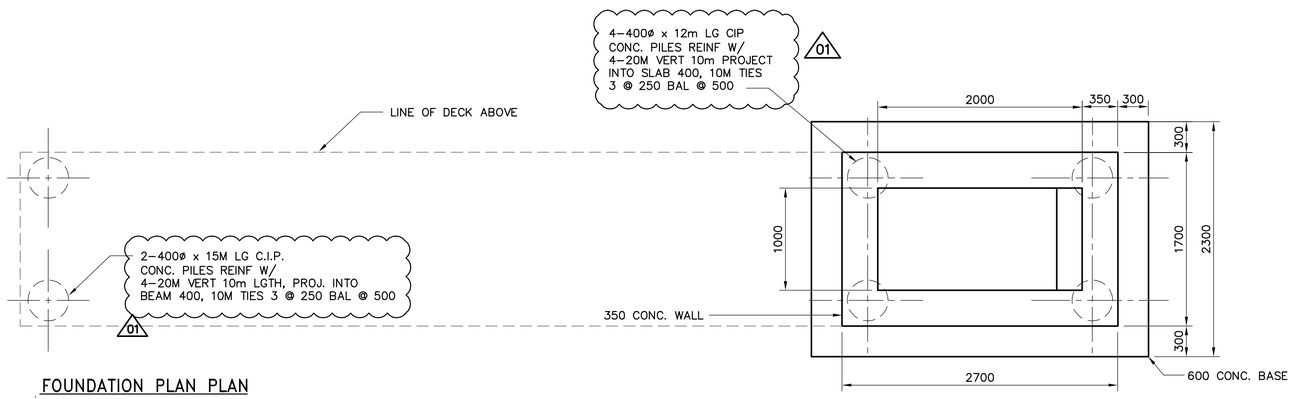

FOUNDATION PLAN PLAN
1:30

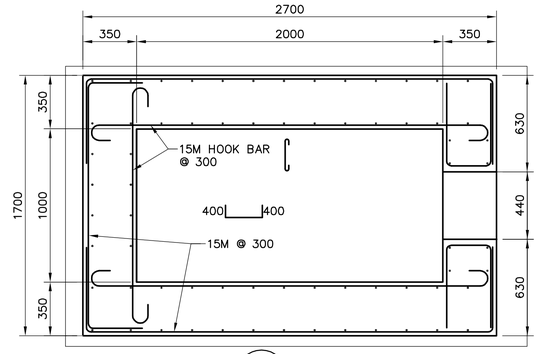

6 WL-S0101 DETAIL
1:10

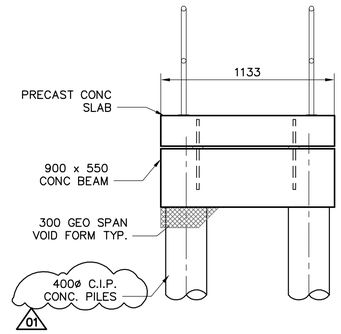

4 WL-S0101 SECTION
1:30

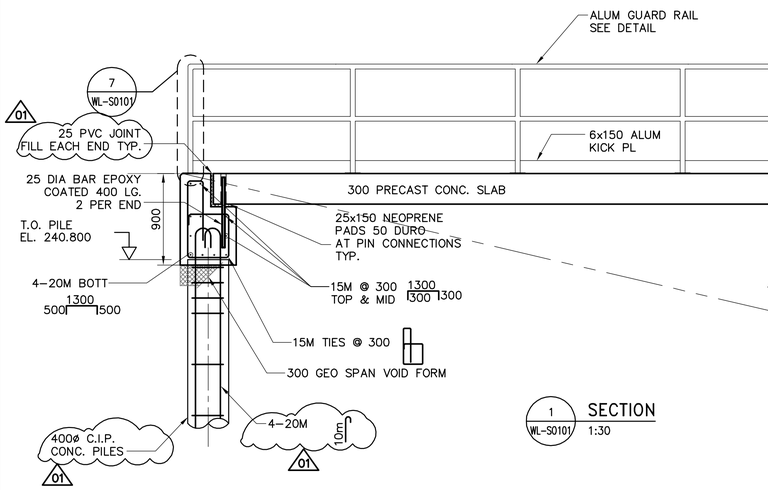

1 WL-S0101 SECTION
1:30

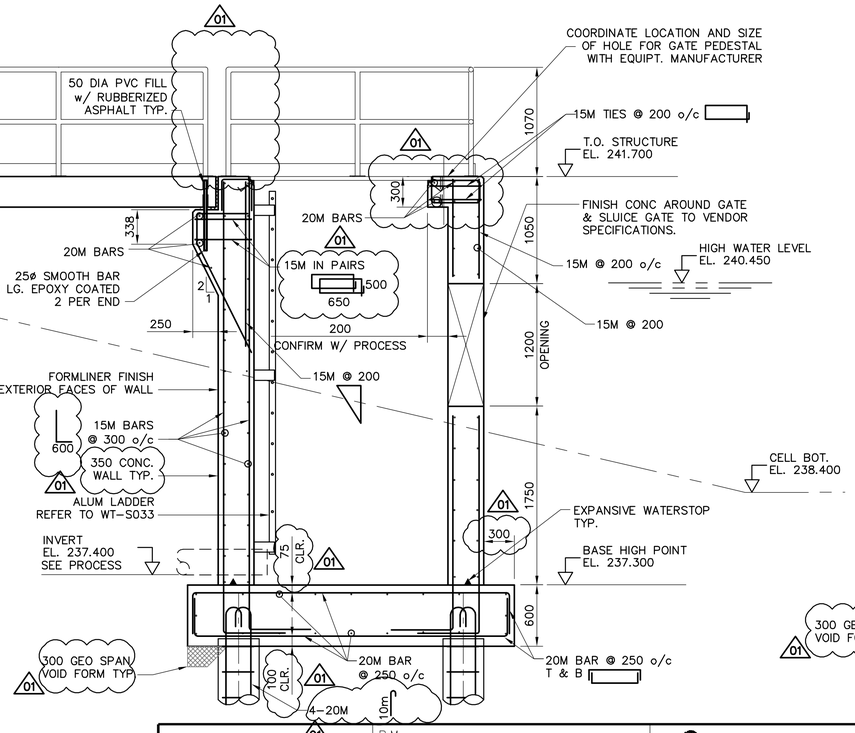

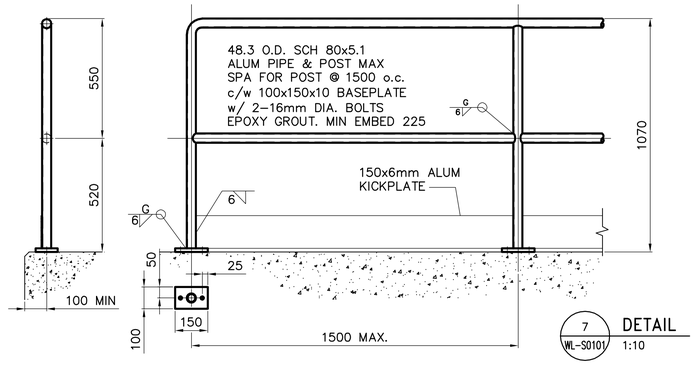

7 WL-S0101 DETAIL
1:10

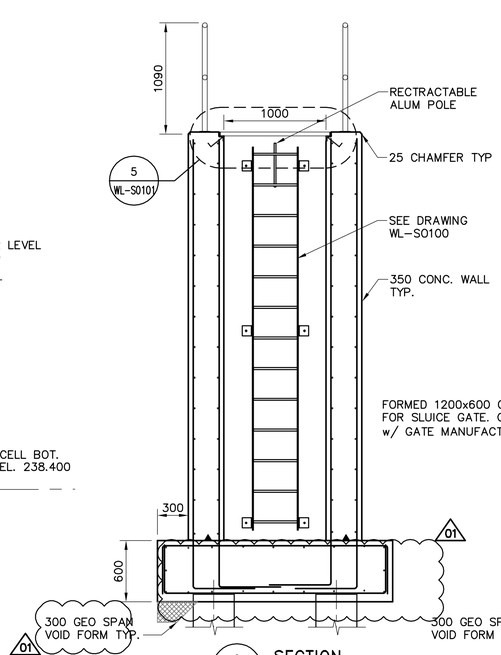

2 WL-S0101 SECTION
1:30

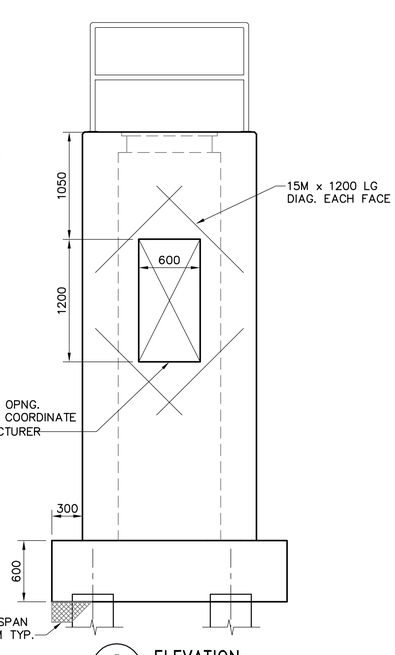

3 WL-S0101 ELEVATION
1:30

DRAWING NOTES:

1. REFER TO DRAWING WL-S0105 FOR GENERAL NOTES

APEGM
Certificate of Authorization
Earth Tech Canada Inc.
No. 730 Expiry: April 30, 2006

NO.	REVISIONS	DATE	BY
01	34-2006 ADDENDUM 2	06/04/07	CMF
00	ISSUED FOR TENDER	06/03/06	WDB

B.M. ELEV.

CH2MHILL Fredericksen Cooper ARCHITECTS
EarthTech A Tyco International Ltd. Company

DESIGNED BY	FK	CHECKED BY	MK
DRAWN BY	GGP/ WDB	APPROVED BY	DJT
SCALE:	AS NOTED	RELEASED FOR CONSTRUCTION BY:	RON SOROKOWSKI
DATE	2006/01/11	DATE	2006/03/07

ENGINEER'S SEAL
ORIGINAL SIGNED BY
M. KLASSEN
2006/03/07

CONSULTANT DRAWING NO.
WL-S0101

THE CITY OF WINNIPEG
WATER AND WASTE DEPARTMENT
ENGINEERING DIVISION

WATER TREATMENT PLANT
CONSTRUCTION OF DEWATERING CELLS

CITY FILE NUMBER
SHEET OF

STRUCTURAL
DECANT STRUCTURE
FOUNDATION PLANS, SECTIONS AND DETAILS

CITY DRAWING NUMBER
1-0601L-A-S0101-001-01D

Last Save: 2006-04-06 2:20 PM

L:\WORK\79000\79538\02A-CAD\IND\CONTR\FREEZE THAW PONDS\DN_WL-S0101_ET.DWG