



ISSUED FOR INFORMATION WITH
 BID OPPORTUNITY 35-2006

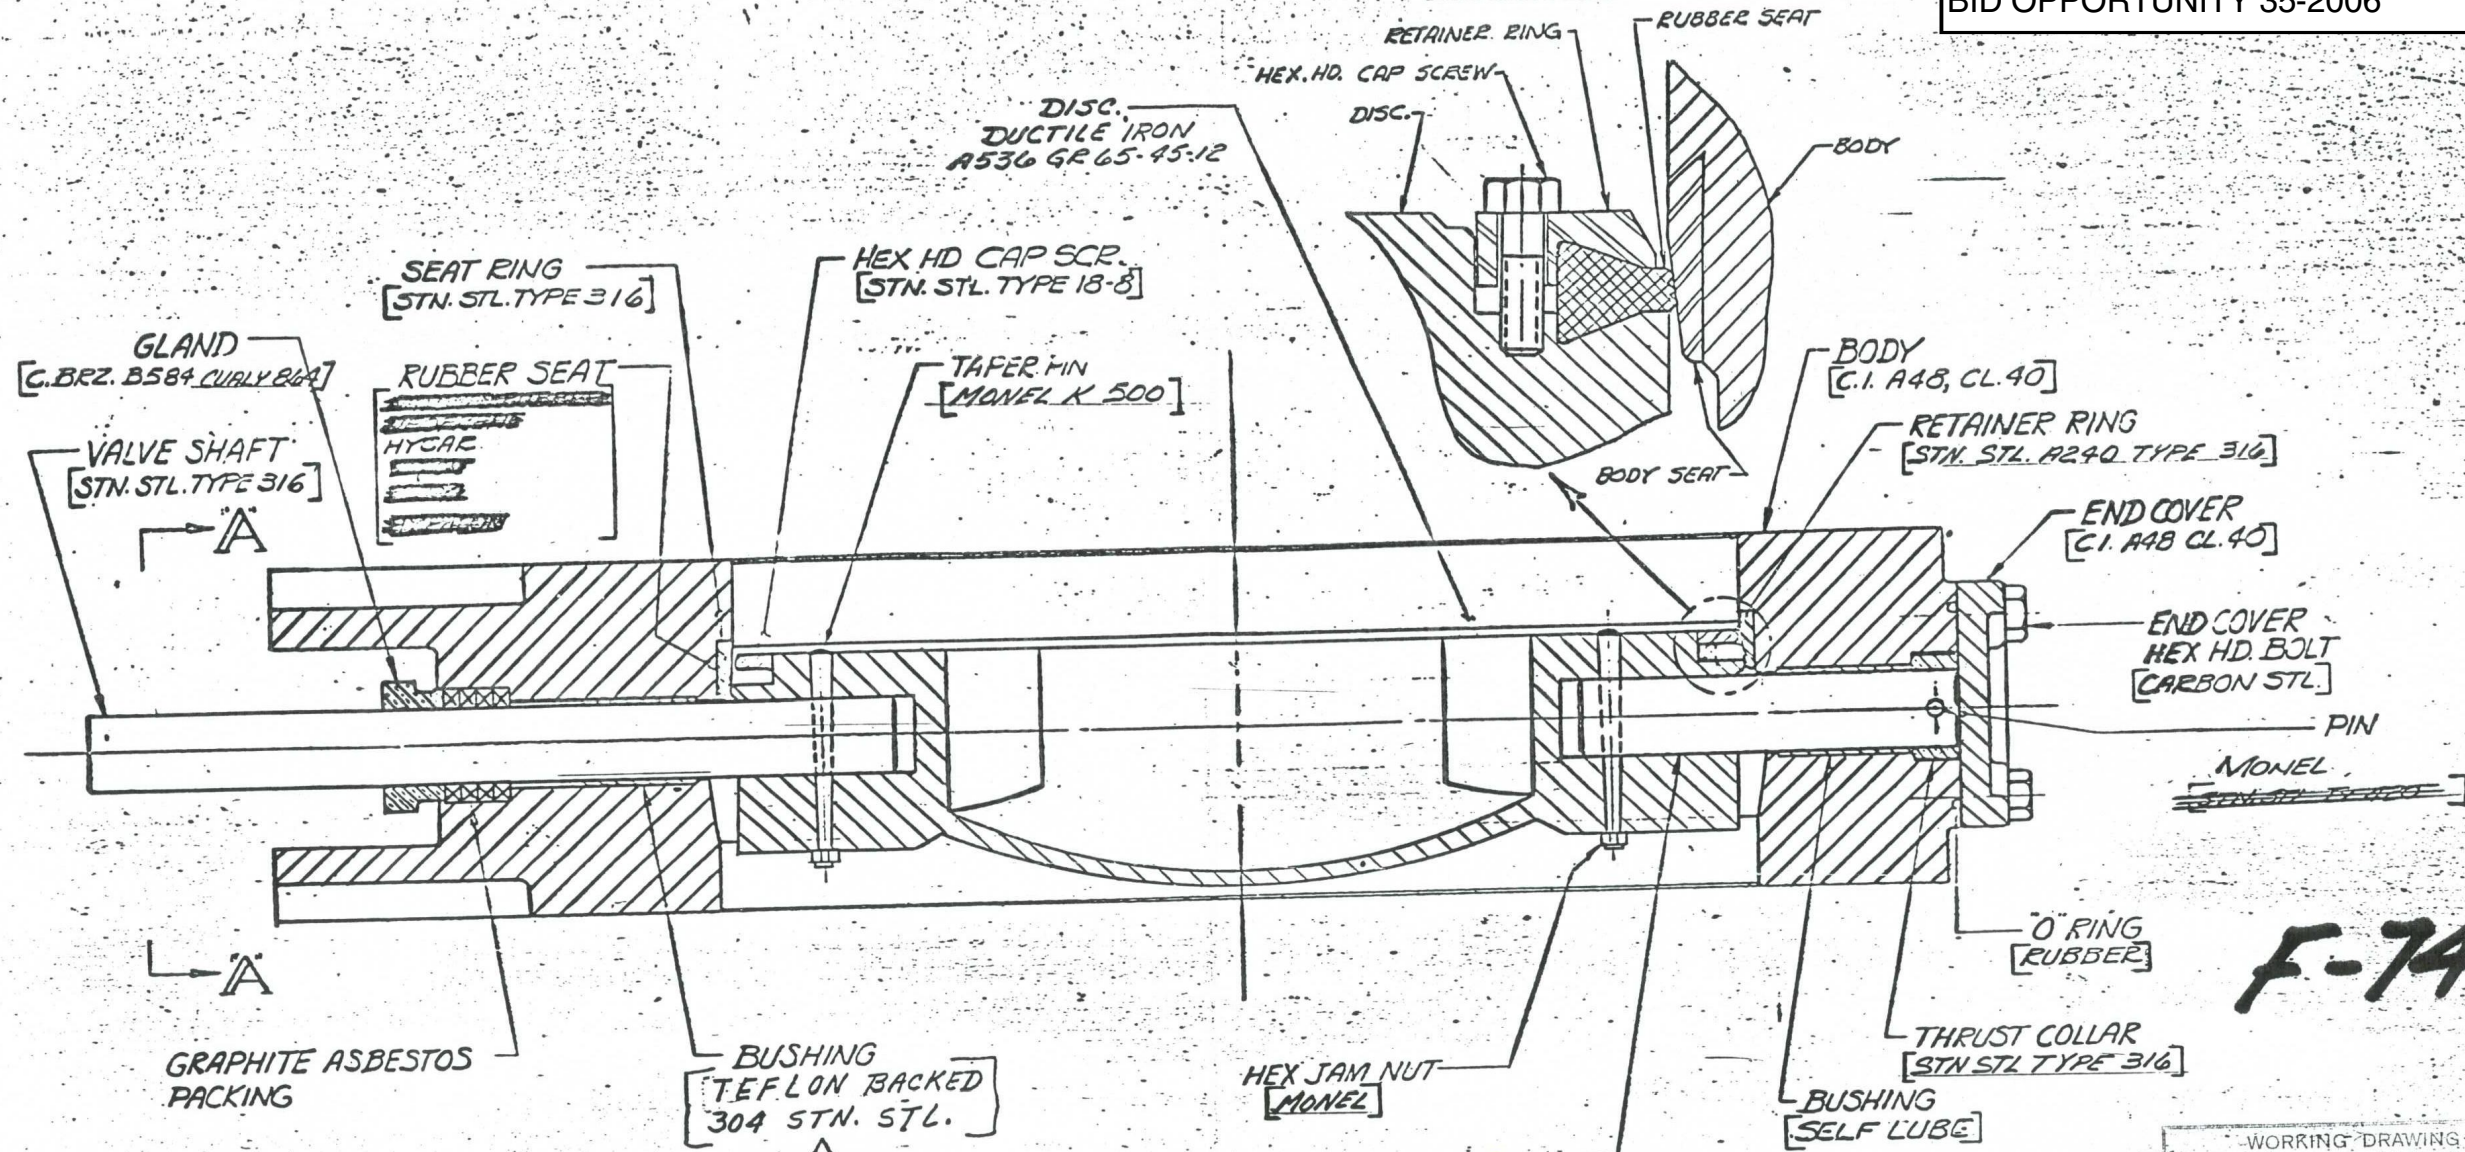

F-748

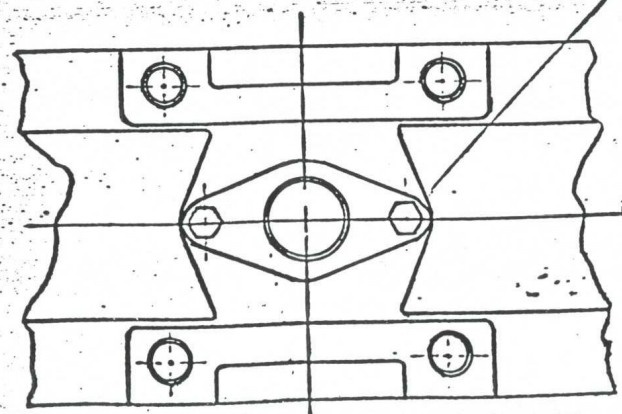

CUSTOMER	A-C CANADA CITY OF WINNIPEG (DEAN BOASTER P)
CUSTOMER OR.D. No.	LA-08978 ITEM: 3
QUANTITY	(1) 60"-75 B FR VALVE
AC ORDER No.	07-5500-42803
DATE	8-31-78 MMS/PA/KEL
REMARKS	LOCATION & NO. - VALVE CH. NO. 6

NOTE: (NO. OF PINS PER CLASS SHAFT)
 CLASS 14 TO 20 - 1 SPRING PIN
 CLASS 23 TO 44 - 2 SPRING PINS
 CLASS 45 TO 68 - 4 SPRING PINS

WORKING DRAWING REVIEW

REVIEW IS FOR GENERAL COMPLIANCE WITH CONTRACT DOCUMENTS. NO RESPONSIBILITY IS ASSUMED FOR CORRECTNESS OF DIMENSIONS.

NO EXCEPTIONS TAKEN

PROCESSED PER COMPANY POLICY

ASSENT PER COMMENTS

SELECTED

JAMES F. JARRELL
 CONSULTING ENGINEER

Date: 7 Feb 79

10819-15-4A
 10819-15-4

S.O. 74488

01 74488		ADD LOCATION & NO., ADD MATL FOR BUSHING	per PH	Wed	1-10-79
NO. S.O.		REVISION	APPROV	CHK'D	DRAWN
- CONFIDENTIAL - PROPERTY OF ALLIS-CHALMERS MFG. CO. YORK WORKS, YORK, PA.					
ASSY SECT 024-096					
				059640A	501