COW-A3 (02/2006)

SURGE TOWER No. 1 LEVEL TRANSMITTER	SURGE TOWER No. 1 LOCAL JUNCTION BOX TJB-Y11	JUNCTION BOX IN DEACON BOOSTER PS TJB-Y21	MAIN CONTROL PANEL	PLC SECTION

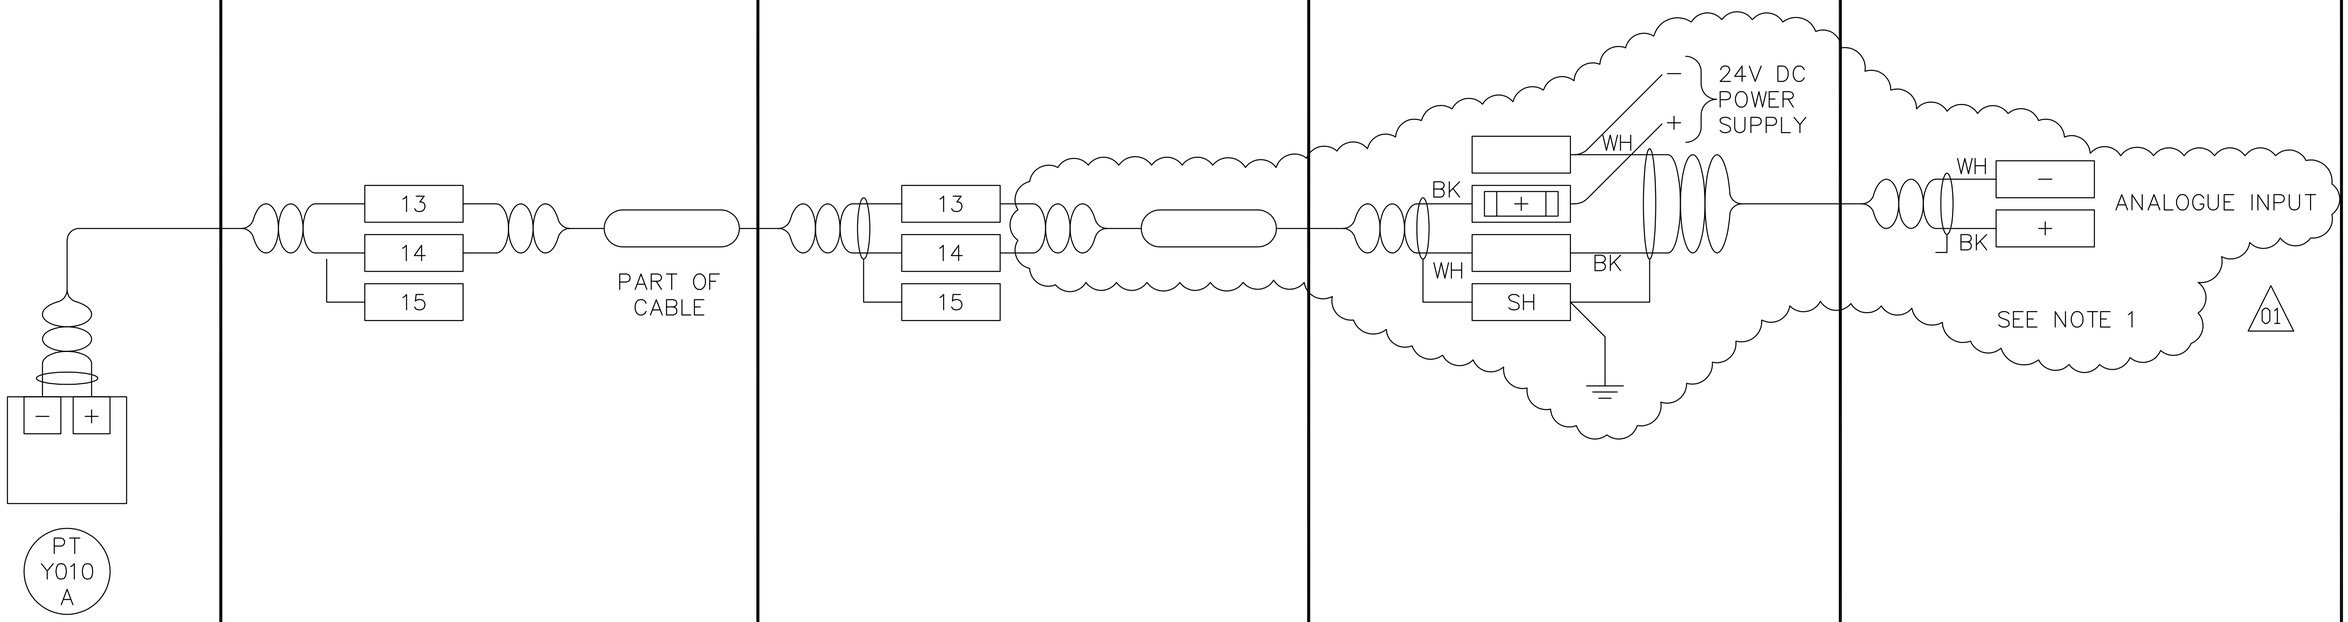

NOTE:

1. PLC ADDRESS TO BE AGREED ON SITE. 01

NO.	REVISIONS	DATE	BY
01	37–2006 ADDENDUM 1	06/05/24	SRP
00	ISSUED FOR TENDER	06/05/03	LAE

B.M.
ELEV.

CH2MHILL
Frederickson Cooper ARCHITECTS
EarthTech A Tyco International Ltd. Company

DESIGNED BY	NT	CHECKED BY	BLM
DRAWN BY	SRP	APPROVED BY	AHL
SCALE:	NTS	RELEASED FOR CONSTRUCTION BY:	R. SOROKOWSKI
DATE	2006/02/13	DATE	2006/05/03

ENGINEER'S SEAL
ORIGINAL SIGNED BY
B.L. MOORE
2006/05/03

CONSULTANT DRAWING NO.
WY–A0455

Winnipeg
THE CITY OF WINNIPEG
WATER AND WASTE DEPARTMENT
ENGINEERING DIVISION

WATER TREATMENT PLANT
YARD PIPING AND VALVE CHAMBERS
SURGE TOWER CONSTRUCTION

AUTOMATION / I&C
LEVEL TRANSMITTER PT–Y010A
LOOP DIAGRAM

CITY FILE NUMBER
SHEET OF
CITY DRAWING NUMBER
1–0601Y–H–A0455–001–01B

Last Save: 2006–05–23 2:09 PM

L:\WORK\79000\79538\02A–CAD\INST\CONTR\SURGE TOWER\DN_WY–A0455_ET.DWG