FILE NO. WP10536

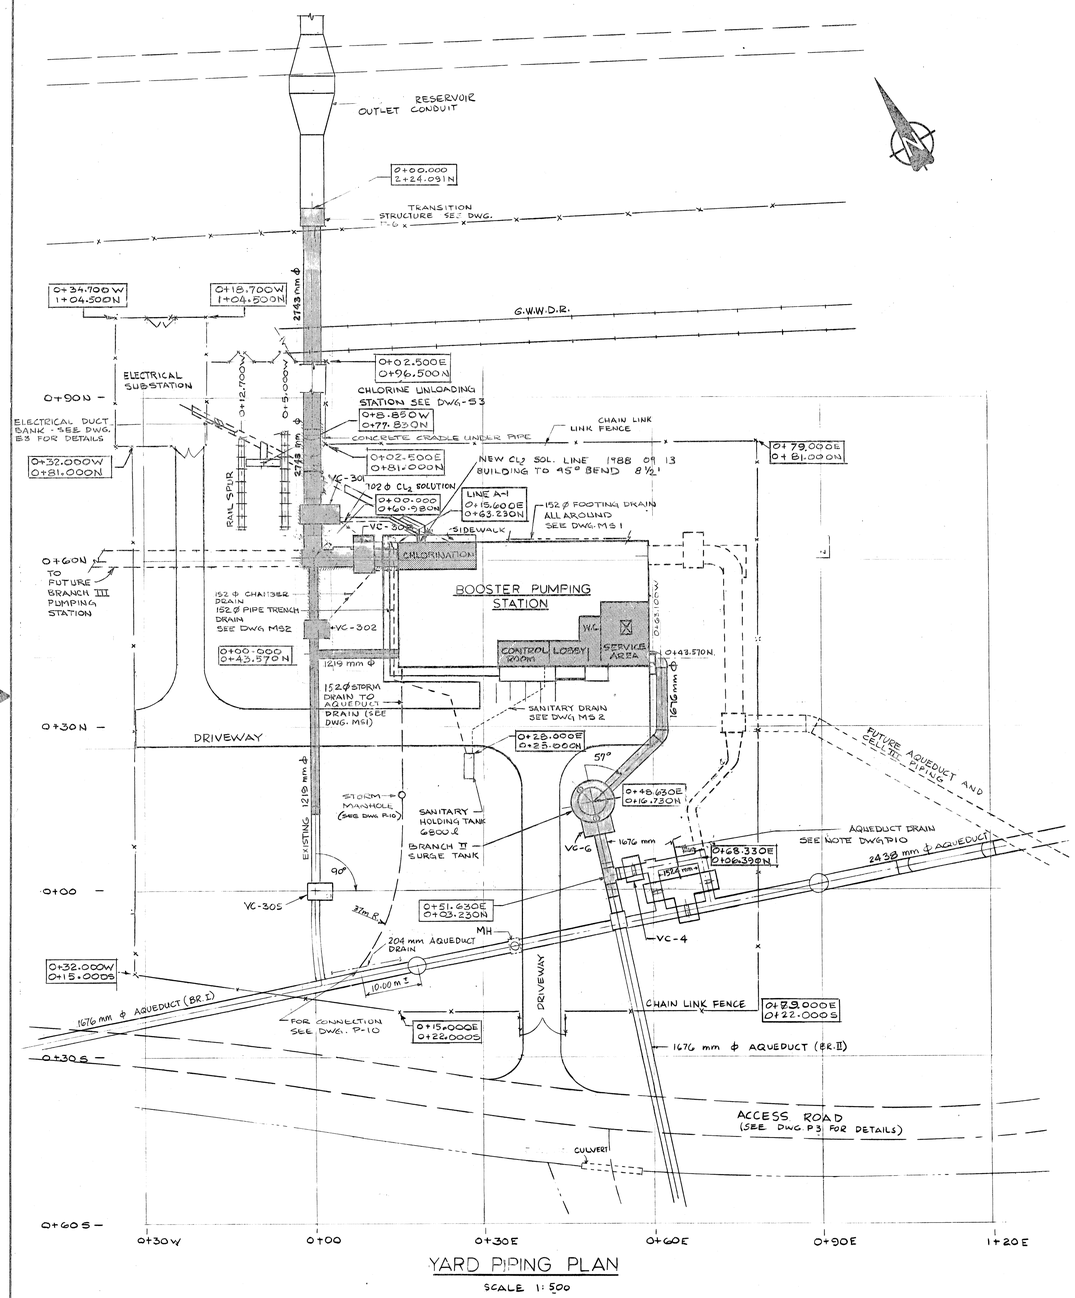

YARD PIPING PLAN

SCALE 1:500

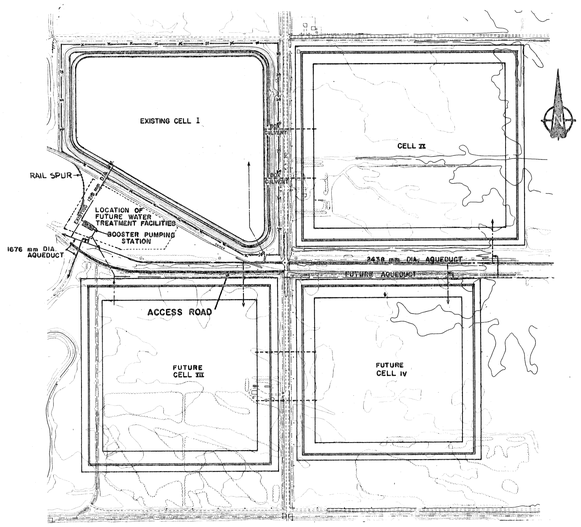

FUTURE RESERVOIR LAYOUT

SCALE 1:10,000 (APPROX.)

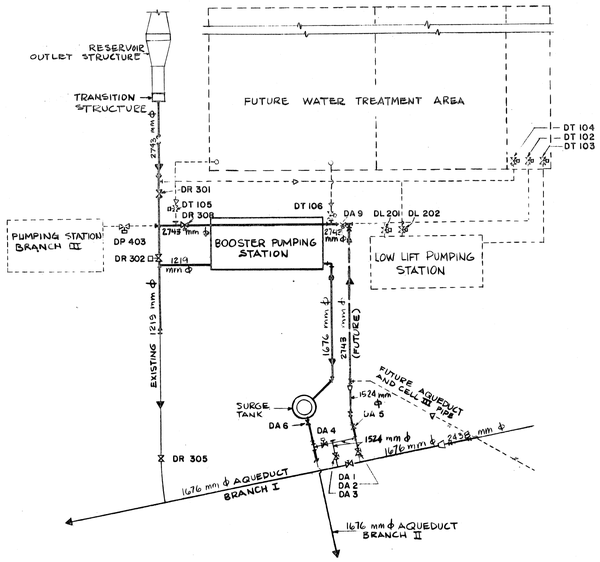

YARD PIPING SCHEMATIC

N.T.S.

NOTE

REFER TO CANRON SHOP DRAWINGS 10819-2D-1A TO 10819-2D-57 FOR ALL YARD PIPING DETAILS

REFERENCE ONLY

B. Hooper 12/14/81

AS BUILT

PROVINCE OF MANITOBA — B. D. MacBRIDE — REGISTERED ENGINEER

DIMENSIONS IN MILLIMETRES EXCEPT AS NOTED

CONSULTANT	DIVISION OF UTILITY	ENGINEERING OFFICE	CENTRAL FILE	ENGINEERING OFFICE
			DRAWING FILE NUMBER	

SHEET No. | No. OF SHEETS | SIZE | MEDIUM | SECURITY RESTR. No. | FRAME No. | No. OF FRAMES | REFERENCE No. | DATE FILMED

GRID CO-ORDINATES
MICROFILMING
WORKS & OPERATIONS DEPARTMENT

REV.	DESCRIPTION	BY	DATE
2	ADDED NEW CL2 SOL. LINE	EN	FEB'82
1	REVISED TO AS BUILT	RM	SEP 80

JAMES F. MacLAREN LIMITED
CONSULTING ENGINEERS, PLANNERS AND SCIENTISTS
WINNIPEG · LONDON · WINDSOR · WATERLOO · TORONTO

DRAWN BY: C.J.A | DESIGNED BY: BMacB
CHECKED BY: BMacB | APPROVED BY: DATE

THE CITY OF WINNIPEG
WATERWORKS, WASTE AND DISPOSAL DIVISION

DEACON BOOSTER PUMPING STATION
PROJECT

YARD PIPING PLAN

SCALE: AS SHOWN
DATE: MAY 30, 1978
CONSULTANT DRAWING No. P4 of 10
CITY DRAWING No. DBP-67

MICROFILMED NOV -- 1981
FILE # WP 10536
FILE 10819-AI-10408