SHEET: COW-A1 (05/2005)

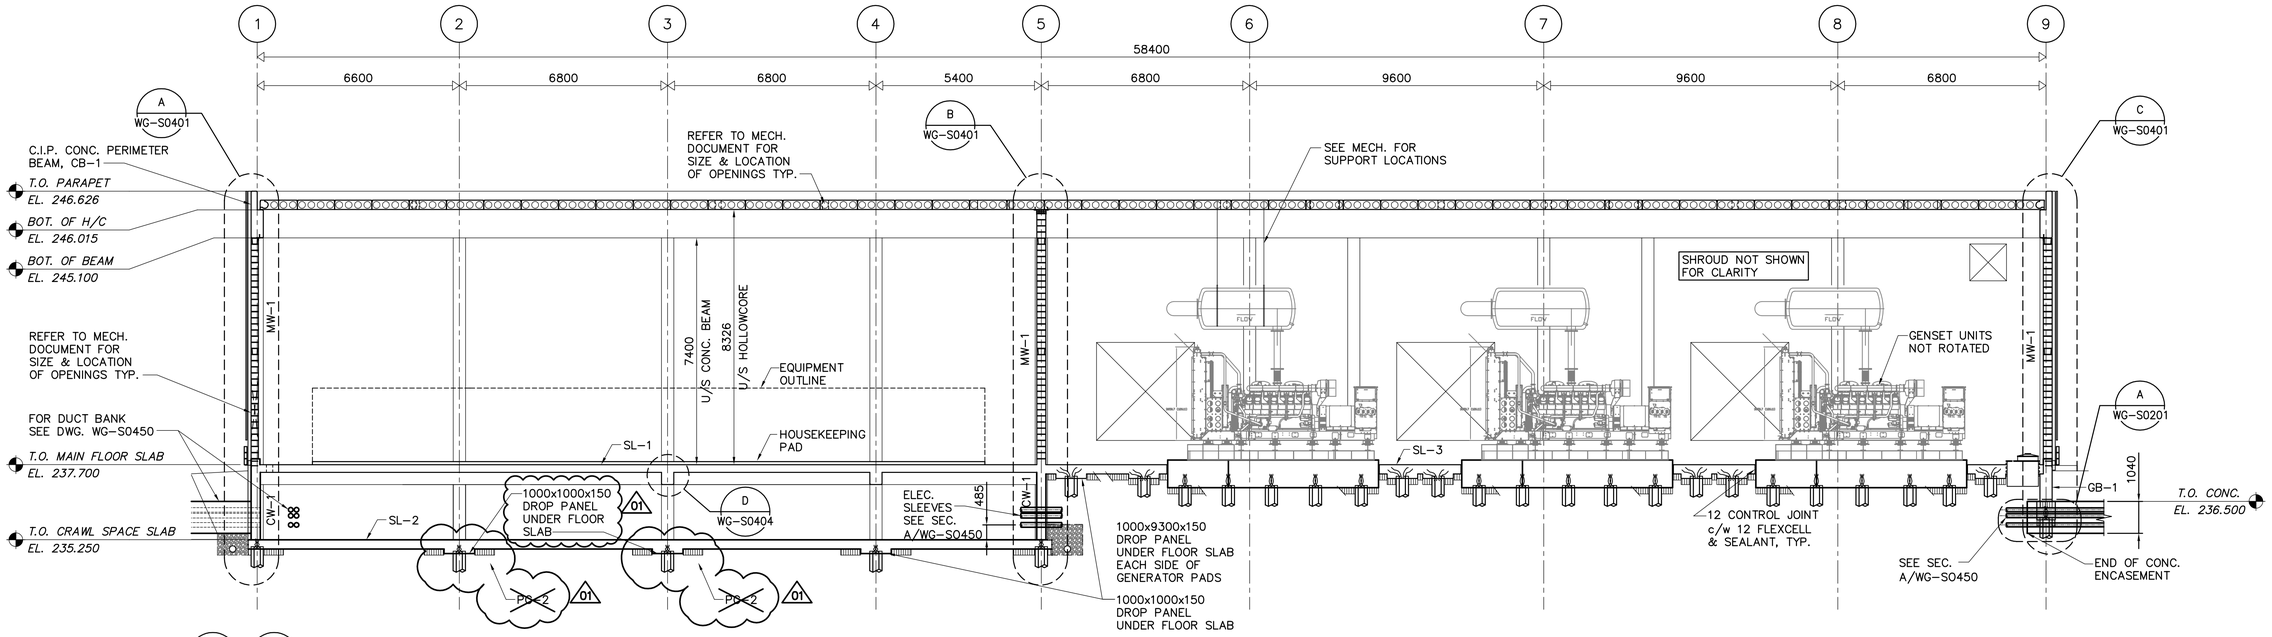

1 WG-S0100 / 1 WG-S0110 SECTION 1:100

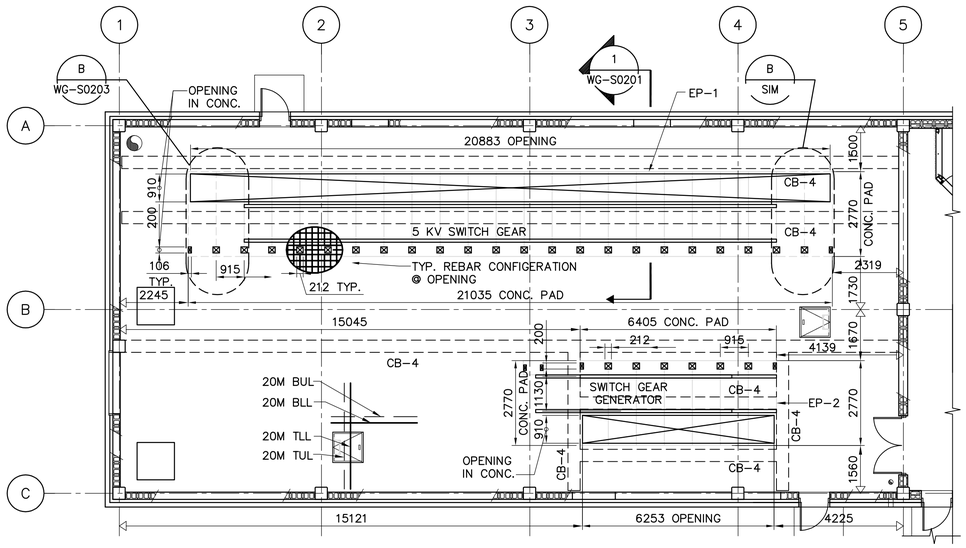

FLOOR PENETRATION FOR SWITCH GEAR CABLES
1:100

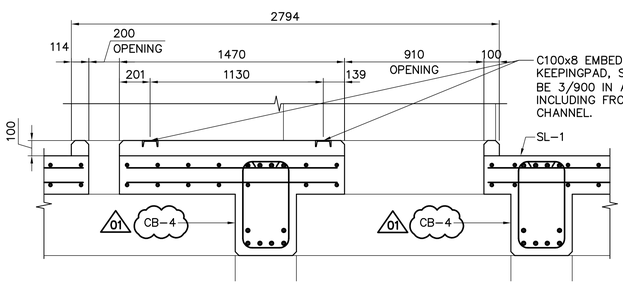

1 WG-S0201 TYP. DETAIL 1 THRU SWITCHGEAR OPENINGS 1:20

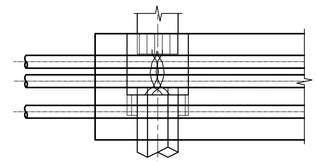

A WG-S0201 DETAIL 1:30

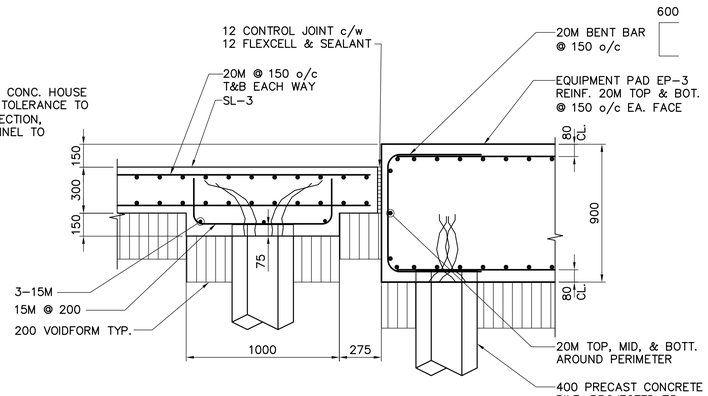

6 WG-S0140 / 6 WG-S0100 SECTION 1:20

APEGM
Certificate of Authorization
Earth Tech Canada Inc.
No. 730 Expiry: April 30, 2007

NO.	REVISIONS	DATE	BY
01	498-2006 ADDENDUM 2	06/09/22	KK
00	ISSUED FOR TENDER	06/08/28	KK

B.M. ELEV.

CH2MHILL Fredericksen Cooper ARCHITECTS — EarthTech A Tyco International Ltd. Company

DESIGNED BY	AP/GGP	CHECKED BY	MK
DRAWN BY	KK	APPROVED BY	AHL
SCALE:	AS SHOWN	RELEASED FOR CONSTRUCTION BY:	R. SOROKOWSKI
DATE	2006/06/16	DATE	2006/08/30

ENGINEER'S SEAL
ORIGINAL SIGNED BY
A. POCHANART
2006/08/30

CONSULTANT DRAWING NO.
WG-S0201

Winnipeg
THE CITY OF WINNIPEG
WATER AND WASTE DEPARTMENT
ENGINEERING DIVISION

WATER TREATMENT PLANT
STANDBY POWER GENERATOR

CITY FILE NUMBER
SHEET OF

STRUCTURAL
FLOOR PENETRATIONS PLAN
BUILDING SECTIONS

CITY DRAWING NUMBER
1-0601G-A-S0201-001-01D

Last Save: 2006-09-27 8:51 AM

L:\WORK\79000\79538\02A-CAD\IND\CONTR\GENSET\DN_WG-S0201_ET.DWG