SHEET: COW-A1 (05/2005)

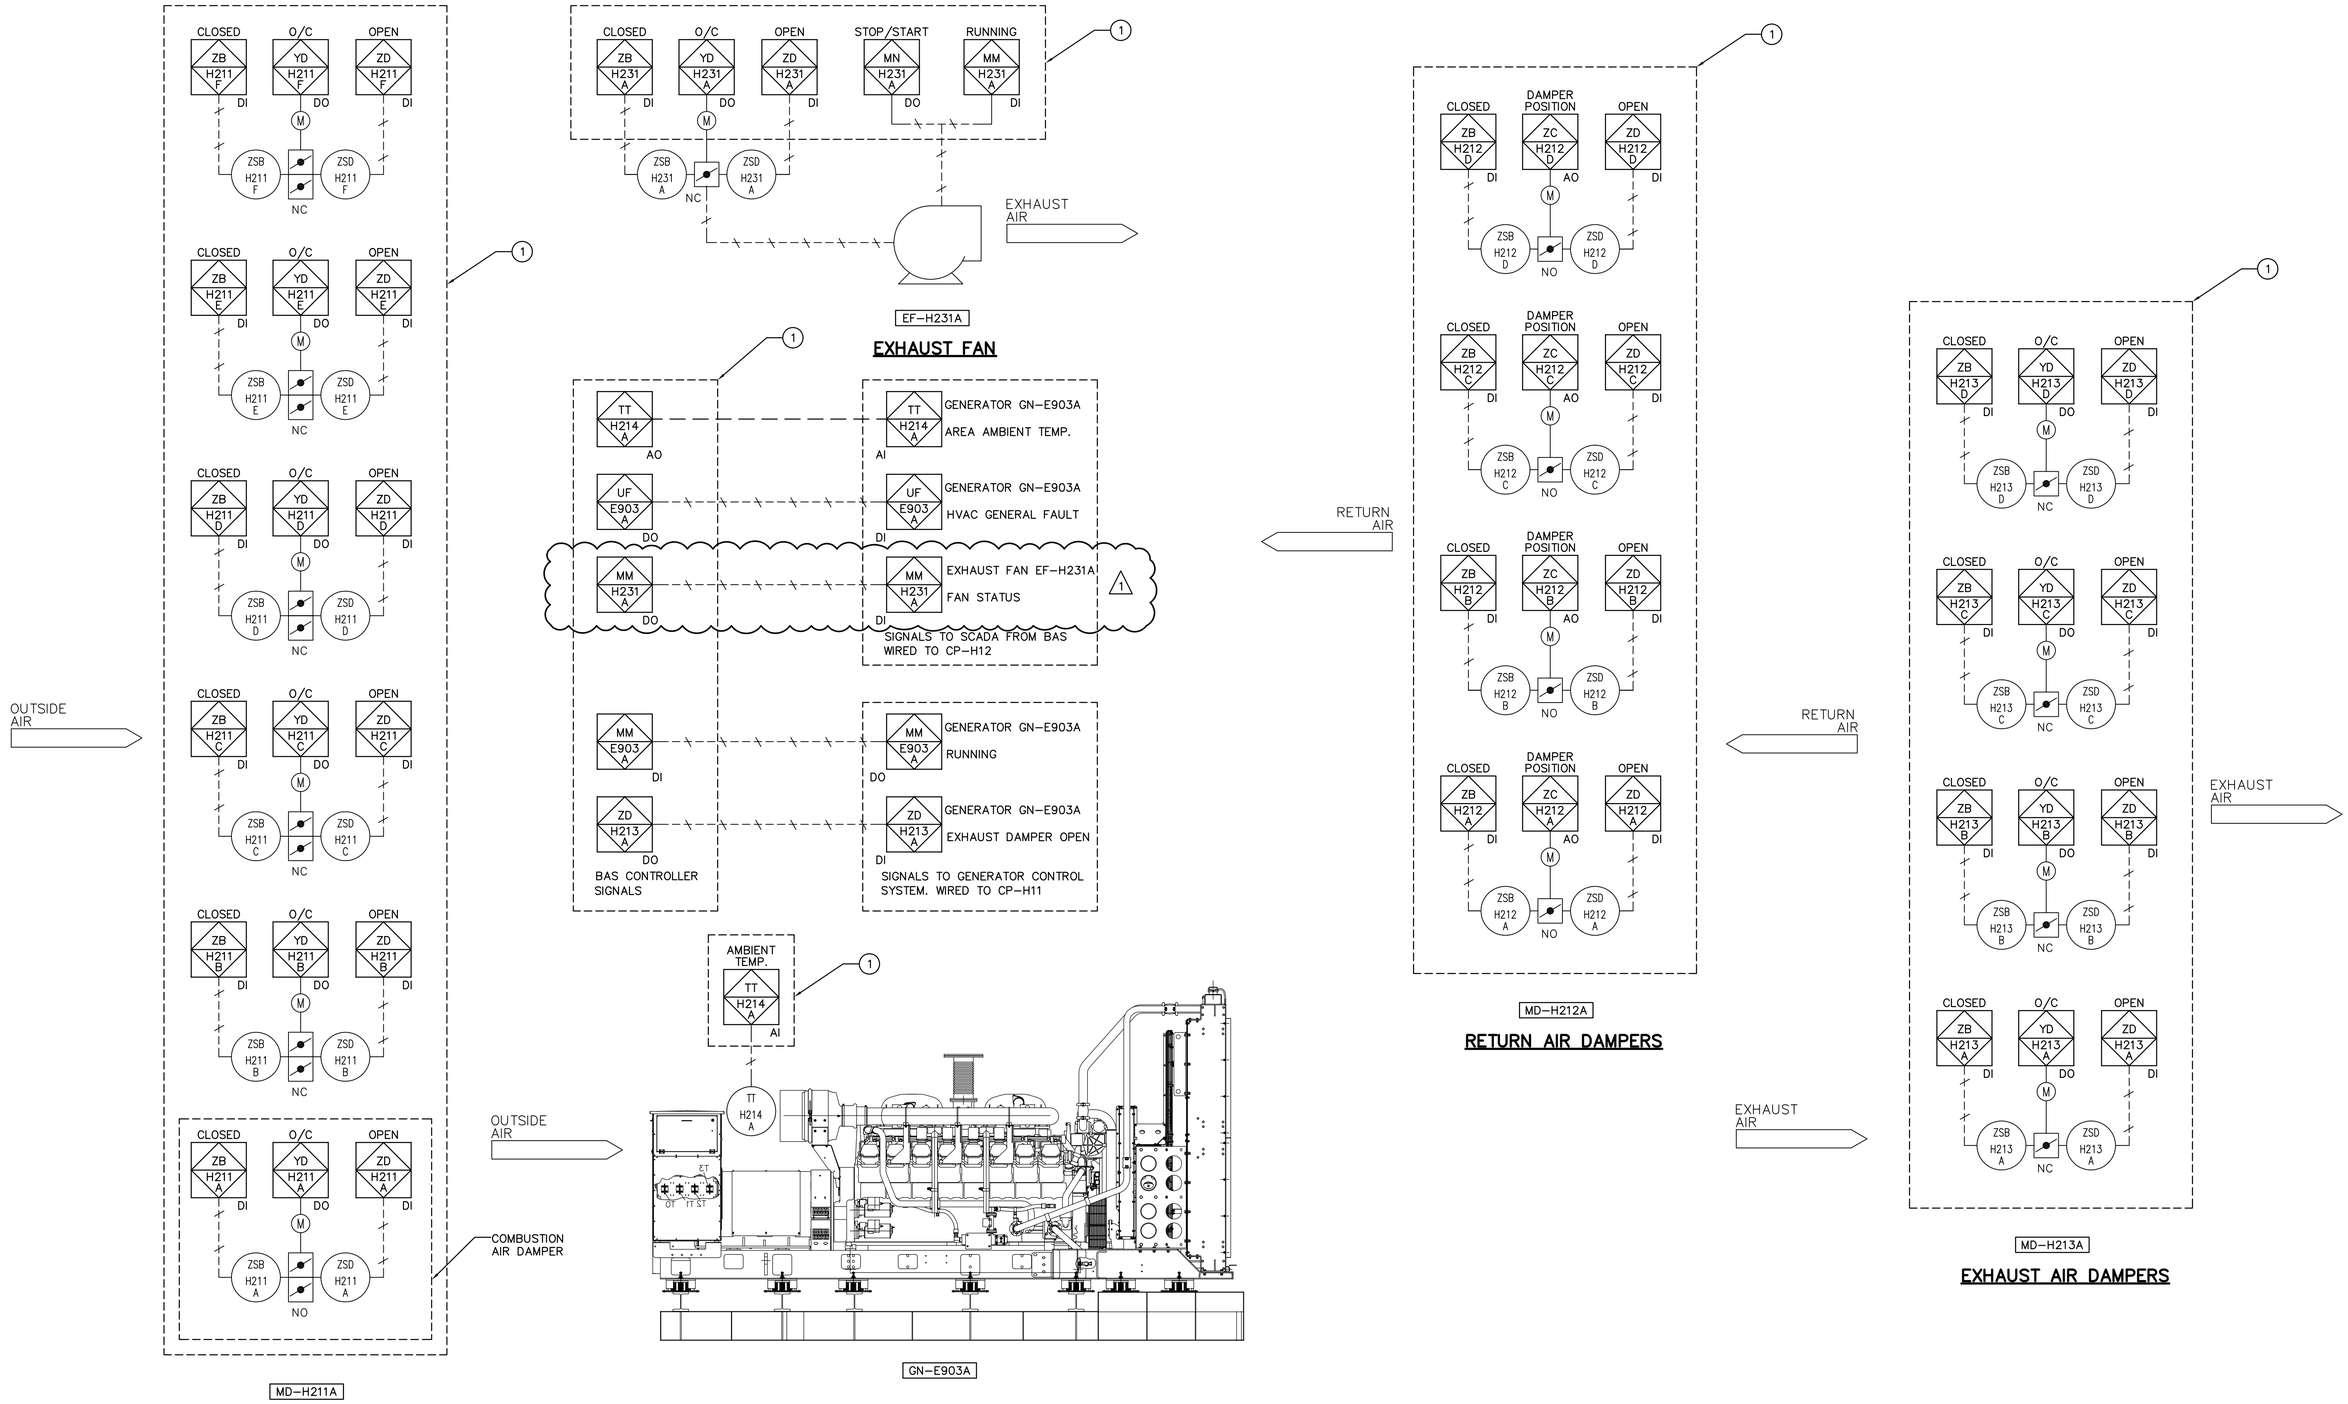

1 GENERATOR ROOM COOLING AND VENTILATION FOR GN-E903A
N.T.S.

NOTES:

1. BAS CONTROLLER #3.
I/O POINTS WIRED TO GENERATOR DDC(BAS) CONTROL PANEL AS PER SPEC. SECTIONS 15900, 15901, 15902. TYPICAL FOR EACH OF 3 GENERATORS.

APEGM
Certificate of Authorization
Earth Tech Canada Inc.
No. 730 Expiry: April 30, 2007

B.M.
ELEV.

NO.	REVISIONS	DATE	BY
01	498-2006 ADDENDUM 3	06/09/28	DC
00	ISSUED FOR TENDER	06/08/28	LJW

CH2MHILL
Fredericksen Cooper ARCHITECTS
EarthTech A Tyco International Ltd. Company

DESIGNED BY	AB	CHECKED BY	AMA, PVL
DRAWN BY	DJP	APPROVED BY	AHL
SCALE:	AS NOTED	RELEASED FOR CONSTRUCTION BY:	R. SOROKOWSKI
DATE	2006/06/15	DATE	2006/08/30

ENGINEER'S SEAL
ORIGINAL SIGNED BY
A. BURACHYNSKY
2006/08/30

CONSULTANT DRAWING NO.
WG-H0504

Winnipeg
THE CITY OF WINNIPEG
WATER AND WASTE DEPARTMENT
ENGINEERING DIVISION

WATER TREATMENT PLANT
STANDBY POWER GENERATOR

CITY FILE NUMBER
SHEET OF

MECHANICAL
GN-E903A
COOLING AND VENTILATION SCHEMATICS

CITY DRAWING NUMBER
1-0601G-G-H0504-001-01D

Last Save: 2006-09-28 10:50 AM

\\CAWPGS01\DATA\WORK\79000\79538\02A-CAD\MEC\CONTR\GENSET\DN_WG-H0504_ET.DWG