

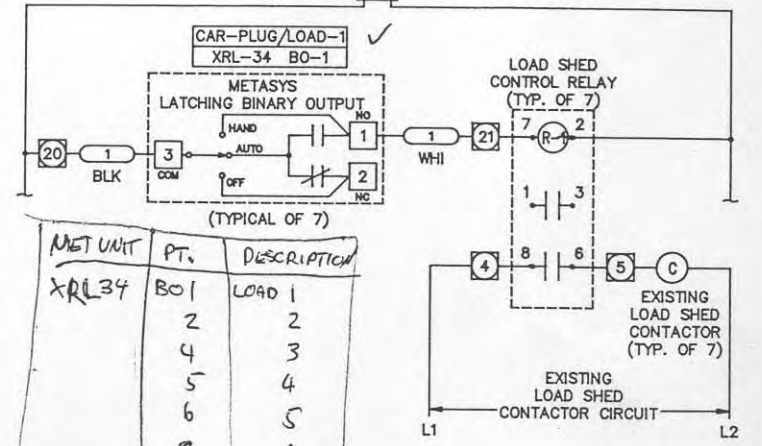


TO TERMINATION CABINET
1501-13C

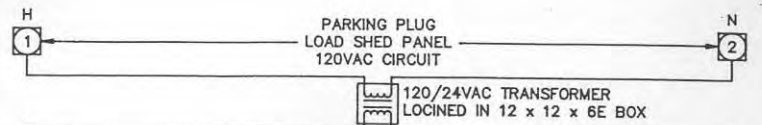

MET UNIT	PT.	DESCRIPTION
XRL34	BO1	LOAD 1
	2	2
	4	3
	5	4
	6	5
	8	6
XRL33	BO6	7

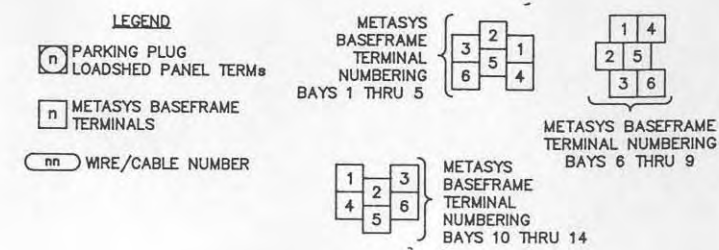

12 X 12 X 6 E BOX

DRAWING TITLE		FILE: LOADSHED	
LOAD SHED			
PANEL SCHEMATIC			
REFERENCE DRAWING	NO.	REVISION-LOCATION	EGN DATE BY
SALES ENR PROJECT MORT/APPL ENR	DRAWN	APPROVED	
BH RC RC	BY CH DATE 12/18/91	DATE	
PROJECT		CONTRACT NUMBER	
WINNEPEG TRANSIT		92098-0303	
METER PANEL CONTROL		800 MORAY STREET	
METASYS FACILITY		WINNEPEG, MANITOBA	
MANAGEMENT SYSTEM		R3U 3/9	
		DRAWING NUMBER	
		1501-14B	

JOHNSON CONTROLS
Systems & Services Division

JOHNSON CONTROLS LTD
204-905-8380.