


N1 LAN
TO NCU #1
BUILDING B
SEE 1501-3

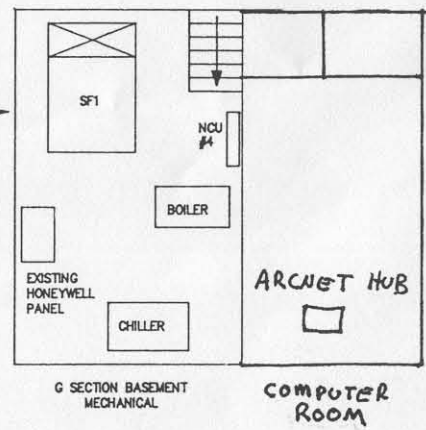

* SET END OF LINE N2 BUS DAISY CHAINS TO EACH UNIT.
THE REMOTE NT ROUTES FROM NCU #4 TO NEU #3

UNIT
UNIT → JOHNSON CONTROLS DC-9100-8154
UNITARY DIGITAL CONTROLLER (u = N2 ADDRESS)

530 FT.

DRAWING TITLE		FILE: GSECFURP	
FT. ROUGE G SECTION		2	2098-5007/UNIT 18
N2 COMMUNICATION BUS		1	AS BUILT
LAYOUT		NO. 1	REVISION-LOCATION
REFERENCE DRAWING	NO. 1	DATE	BY
SCALES	ENGR	PROJECT	MANAGER
BH	RC	RC	BY
DATE	07/25/91	DATE	
PROJECT	WINNIPEG TRANSIT	CONTRACT NUMBER	91098-5006
ADMINISTRATION AND G SECTION	METASYS FACILITY	DRAWING NUMBER	1501-32A
MANAGEMENT SYSTEM	JOHNSON CONTROLS	Systems & Services Division	
	JOHNSON CONTROLS LTD	800 MORAY STREET	WINNIPEG, MANITOBA
	R3J 3W9	204-885-8300	